

Environmental Services - Water Quality
Onsite Wastewater Scan Data Entry Form

PERMIT #: **W A I 4 5 5 6**

PIN #: **0 6 6 8 7 8 2 4 2 4**

OP DATE: **0 9 / 0 8 / 2 0 1 6**

SYSTEM USE:

- ☒ House
☐ Mobile Home
☐ Business
☐ Other

SEWAGE TYPE:

- ☒ Domestic
☐ Industrial

PUMP/SIPHON?:

- ☐ Yes
☒ No

PRESSURE MANIFOLD:

- ☐ Yes
☒ No

SYSTEM TYPE:

- ☐ I
☒ II
☐ III
☐ IV
☐ V
☐ VI
☐ Other

SUB TYPE:

- ☒ A
☐ B
☐ C
☐ D
☐ E
☐ F
☐ G

NBR BEDROOMS:

- ☐ 1
☐ 2
☐ 3
☒ 4
☐ 5
☐ 6
☐ Other

MAINT. SCHEDULE:

- ☐ Yes
☒ No

CERT. OPERATOR

- ☐ Yes
☒ No

GT	ST	PT	SIZE
☐	☐		750
☐	☐	☐	900
☐	☐	☐	1,000
☐	☒	☐	1,200
☐	☐	☐	1,500
☐	☐	☐	1,800
☐	☐	☐	2,100
☐	☐	☐	2,500
☐	☐	☐	3,000
☐	☐	☐	4,000
☐	☐	☐	5,000
☐	☐	☐	8,000
☐	☐	☐	10,000
☐	☐	☐	Other
☒		☒	None/NA GT or PT

DRAINFIELD SIZE(SQ. FT.)

0 1 2 0 0

DRAIN TYPE:

- ☒ Stone
☐ EZ Flow
☐ Infiltrator
☐ Biodiffuser
☐ Cultec
☐ Drip
☐ Hancor
☐ Large Dia. Pipe
☐ Multi-Pipe
☐ Other

MAX DEPTH (IN.):

- ☐ 12 in. or less
☐ 18 in. or less
☐ 24 in. or less
☐ 26 in. or less
☒ 28 in. or less
☐ 30 in. or less
☐ 32 in. or less
☐ 36 in. or less
☐ Other

STONE DEPTH (IN.):

- ☐ 8 in. or less
☒ 12 in. or less
☐ 18 in. or less
☐ 24 in. or less
☐ Other

TRENCHES:

- ☒ Individual
☐ Bed

TRENCH WIDTH (IN.):

- ☐ 12 in. or less
☐ 18 in.
☐ 24 in.
☒ 36 in.
☐ 6 ft. or less
☐ 9 ft. or less
☐ Other

W# 14556

BM. 1989 - 1383

N 89° 01' 04" E 250.23'

Impervious Coverage Information

Building Footprint	4122.9 Sq. Ft.
Driveway	3882.7 Sq. Ft.
Sidewalks	289.7 Sq. Ft.
Gazebo	185.1 Sq. Ft.
Storage Bldg.	144.3 Sq. Ft.
Porch	320.0 Sq. Ft.
Patio and Pool	2995.0 Sq. Ft.
Total allowed impervious coverage	36757.4 Sq. Ft.
Total area of impervious coverage	11939.7 Sq. Ft.
Total square footage of lot	122524.5 Sq. Ft.

Site plan approved as shown for Gazebo.
Any changes to site plan or structure apply
for septic systems and wells, regarding any
additions and/or accessory structures. Applicant is responsible
for protecting all portions of the septic system, repair area and
wells from damage during construction. Adhere to all Local and
State Rules.
Approved by Alan Moore Date 9/8/16
Wake County Department of Environmental Services,
Water and Waste Water Section

0468782424
I certify that the location of planned or existing structure(s)
are accurately shown. I understand failure to locate
structures in accordance with this plot plan may
require the relocation of structure(s) regardless
degree of completion. I hereby grant permission to
Municipal/County Representatives the right of entry
to make evaluations or inspections upon this property.
Eddie Cochran
Signature of Owner or Authorized Agent

I, James R. Wilson, do hereby certify that this property
is not located in a Special Flood Hazard Area
as determined by the Department of Housing and
Urban Development.
James R. Wilson 8-27-16
James R. Wilson P.L.S. No. L-2452 Date


I, James R. Wilson, certify that this plat was
drawn under my supervision from an actual survey
made under my supervision; that the error of closure
as calculated by latitudes and departures is
1 : 15,000+; that the boundaries
not surveyed are shown as broken lines plotted from
information found in Book _____, Page _____;
that this plat was prepared in accordance with G.S. 47-
30 as amended. Witness my original signature,
registration number and seal this 27th day of
Aug., A.D., 2016.

James R. Wilson
Professional Land Surveyor
L-2452
Registration Number



Comments:
Zoning R30
Approve X
Revised MBL 10/14
Reject 50
Front 50
Side 50
Corner 50

CURVE	RADIUS	ARC LENGTH	CHORD LENGTH	CHORD BEARING	DELTA ANGLE
C1	280.89'	183.13'	179.91'	N 87° 39' 55" W	37° 21' 21"
C2	941.09'	211.70'	211.25'	S 75° 25' 48" E	12° 53' 19"

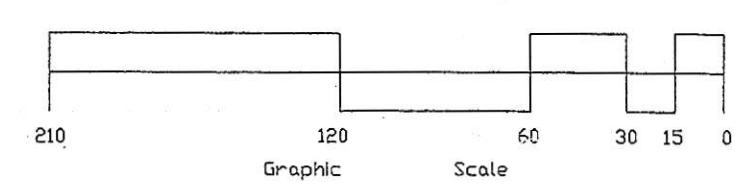

Lot 87
122524.5 SQ. FT.
2.8128 ACRES
D. B. 14804 - 1992
P. B. 1994 - 338

Edward M. Plut and wife

Survey For:
Edward M. Plut and wife
Julie A. Plut
3609 Breckenridge Lane
Fuquay Varina, North Carolina
Wake County
Scale: 1"=60' Date: 8-27-16 File No.: 2016-027

James R. Wilson
Professional Land Surveyor
2173 Will Suitt Rd. - Creedmoor, N.C.
919-818-1022
jwsurvey@ix.netcom.com

070713