

Environmental Services - Water Quality
Onsite Wastewater Scan Data Entry Form

PERMIT #: 0048090

PIN #: 0686094817

OP DATE: 09/21/2012

SYSTEM USE:

- ☒ House
☐ Mobile Home
☐ Business
☐ Other

SEWAGE TYPE:

- ☒ Domestic
☐ Industrial

PUMP/SIPHON?:

- ☐ Yes
☒ No

PRESSURE MANIFOLD:

- ☐ Yes
☒ No

SYSTEM TYPE:

- ☐ I
☒ II
☐ III
☐ IV
☐ V
☐ VI
☐ Other

SUB TYPE:

- ☒ A
☐ B
☐ C
☐ D
☐ E
☐ F
☐ G

NBR BEDROOMS:

- ☐ 1
☐ 2
☒ 3
☐ 4
☐ 5
☐ 6
☐ Other

MAINT. SCHEDULE:

- ☐ Yes
☒ No

CERT. OPERATOR

- ☐ Yes
☒ No

GT ST PT SIZE

- | | | | |
|-------------------------------------|-------------------------------------|-------------------------------------|------------------|
| ☐ | ☐ | ☐ | 750 |
| ☐ | ☐ | ☐ | 900 |
| ☐ | ☒ | ☐ | 1,000 |
| ☐ | ☐ | ☐ | 1,200 |
| ☐ | ☐ | ☐ | 1,500 |
| ☐ | ☐ | ☐ | 1,800 |
| ☐ | ☐ | ☐ | 2,100 |
| ☐ | ☐ | ☐ | 2,500 |
| ☐ | ☐ | ☐ | 3,000 |
| ☐ | ☐ | ☐ | 4,000 |
| ☐ | ☐ | ☐ | 5,000 |
| ☐ | ☐ | ☐ | 8,000 |
| ☐ | ☐ | ☐ | 10,000 |
| ☒ | ☐ | ☒ | Other |
| ☒ | | ☒ | None/NA GT or PT |

DRAINFIELD SIZE(SQ. FT.)

00006

repair existing

DRAIN TYPE:

- ☐ Stone
☐ EZ Flow
☐ Infiltrator
☐ Biodiffuser
☐ Cultec
☐ Drip
☐ Hancor
☐ Large Dia. Pipe
☐ Multi-Pipe
☒ Other

MAX DEPTH (IN.):

- ☐ 12 in. or less
☐ 18 in. or less
☐ 24 in. or less
☐ 26 in. or less
☐ 28 in. or less
☐ 30 in. or less
☐ 32 in. or less
☐ 36 in. or less
☒ Other

STONE DEPTH (IN.):

- ☐ 8 in. or less
☐ 12 in. or less
☐ 18 in. or less
☐ 24 in. or less
☒ Other

TRENCHES:

- ☒ Individual
☐ Bed

TRENCH WIDTH (IN.):

- ☐ 12 in. or less
☐ 18 in.
☐ 24 in.
☐ 36 in.
☐ 6 ft. or less
☐ 9 ft. or less
☒ Other

B W 11/21/13

WAKE COUNTY DEPARTMENT OF ENVIRONMENTAL SERVICES WELL AND SEWAGE SITE LOCATION PERMITNO PERMIT(S) FOR CONSTRUCTION, LOCATION OR RELOCATION ACTIVITY SHALL BE ISSUED
UNTIL AN AUTHORIZATION FOR WASTEWATER SYSTEM CONSTRUCTION HAS BEEN ISSUED***PERMIT VOID IF NOT IN COMPLIANCE WITH ZONING REGULATIONS AND/ OR IF SITE IS ALTERED OR INTENDED USE CHANGED***

PERMIT#: D048090 STATUS: A APP. DATE: 09/11/2012 BLDG. PERMIT#: I010206
PIN: 0686.01 09 4817 000 TAX MAP: 0856 0010 RECORDED: Y ORIG. PERMIT#:
TOWNSHIP: 12 MIDDLE CREEK JURISDICTION: WC ZONING: R10 SW DEVICE: N S#:
APPLICANT: HUNT, JOSHUA
1828 NC 42
WILLOW SPRING, NC 27592
(919) 455 - 5460
USE: HD USE: 0001 REPAIR/EXISTING SYSTEM
EXIST USE: 101A CONVENTIONAL ONE-FAMILY H
LTAR: 0.30 0.30 BEDROOMS: 3 BASEMENT: N #EMPLOYEES: 0
SITE: ADDRESS: 1828 NC 42 HWY
SUBDIVISION: WILLOW SPRING LOT: 1 ACRES: 0.44 EASEMENT: N LOC: SYS:
DIRECTION: SEE ATTACHED

Well System: WATER: INDIVIDUAL - TYPE: EXISTING

WELL LOG INFORMATION: DEPTH: _____ CASING DEPTH: _____ YIELD: _____ STATIC LEVEL: _____
WELLI CONTRACTOR: _____ REG.# _____ PUMP CONTRACTOR: _____ REG.# _____
Construction Compliance GROUT APPROVED ☐ DATE _____ EHS _____
WELLHEAD APPROVED ☐ DATE _____ EHS _____
SYSTEM FINALIZED ☐ DATE _____ EHS _____

COMMENTS: _____

Operation Permit

DESIGN FLOW: _____ gal./min. ACTUAL FLOW: _____ INNOVATIVE LETTER: _____

INSTALLED BY: _____ INSTALLATION APPROVED BY: _____

PROPRIETARY SYSTEM: : _____ FILTER NO: _____

COMMENTS: _____

OPERATIONS PERMIT ISSUED? _____ OP DATE: 9/21/12 BY: _____

This permit is based in part on information provided by the homeowner or his/her representative in the application submitted for this permit. The Environmental Health Specialist is not responsible for false or misleading information contained in the application. The Environmental Health Specialist is also not responsible for concealed conditions on the property or for statements in this report that may have resulted from false or misleading statements provided to him in the application. Neither Wake County nor the Environmental Health Specialist warrants that the septic tank system will continue to function satisfactorily in the future or that the water supply will remain potable.

As Built Information:

Date: _____ Benchmark: _____ Rod reading: _____ Distance to Structure: _____
ST: _____ gals ID#: _____ D.O.M.: _____ Elev.: _____ Distance to Well: _____
PT: _____ gals ID#: _____ D.O.M.: _____ Elev.: _____
D-box/FD/PM elev.: _____ Supply Line: _____ ft. Pump/Control Panel: _____
Line 1: _____ Date: _____ Line 6: _____ Date: _____
Line 2: _____ Date: _____ Line 7: _____ Date: _____
Line 3: _____ Date: _____ Line 8: _____ Date: _____
Line 4: _____ Date: _____ Line 9: _____ Date: _____
Line 5: _____ Date: _____ Line 10: _____ Date: _____
Distance to P/L: _____ Notes: _____

WAKE COUNTY DEPARTMENT OF ENVIRONMENTAL SERVICES WELL AND SEWAGE SITE LOCATION PERMIT

NO PERMIT(S) FOR CONSTRUCTION, LOCATION OR RELOCATION ACTIVITY SHALL BE ISSUED
UNTIL AN AUTHORIZATION FOR WASTEWATER SYSTEM CONSTRUCTION HAS BEEN ISSUED

PERMIT VOID IF NOT IN COMPLIANCE WITH ZONING REGULATIONS AND/ OR IF SITE IS ALTERED OR INTENDED USE CHANGED

PERMIT#: D048090 STATUS: A APP. DATE: 09/11/2012 BLDG. PERMIT#: I010206
PIN: 0686.01 09 4817 000 TAX MAP: 0856 0010 RECORDED: Y ORIG. PERMIT#:
TOWNSHIP: 12 MIDDLE CREEK JURISDICTION: WC ZONING: R10 SW DEVICE: N S#:
APPLICANT: HUNT, JOSHUA
1828 NC 42
WILLOW SPRING, NC 27592
(919) 455 - 5460
USE: HD USE: 0001 REPAIR/EXISTING SYSTEM
EXIST USE: 101A CONVENTIONAL ONE-FAMILY H
LTAR: 0.30 0.30 BEDROOMS: 3 BASEMENT: N #EMPLOYEES: 0 FOUNDATION DRAIN: N
SITE: ADDRESS: 1828 NC 42 HWY
SUBDIVISION: WILLOW SPRING LOT: 1 ACRES: 0.44 EASEMENT: N LOC: SYS:
DIRECTION: SEE ATTACHED

IMPROVEMENT PERMIT

TANK SIZE: 1000 gal. PUMP Tank: _____ gal. SQ FT: _____ STONE DEPTH: _____ in. MAX DEPTH LINE: _____ in.
WASTEWATER: INDIVIDUAL SEWAGE: DOMESTIC TYPE SYSTEM: II A PUMP: N P/M: N
DAILY FLOW: 360 gal/day DESIGN FEE REQ?: _____ PAID?: _____ WATER: INDIVIDUAL

COMMENTS:

IP ISSUED? _____ DATE: _____ BY: () _____ PHONE#: _____

AUTHORIZATION FOR WASTEWATER/WATER SYSTEM CONSTRUCTION


VOID SIXTY (60) MONTHS FROM DATE OF ISSUANCE

AUTHORIZATION CONDITIONS:

Contractors shall install system on contours, see attached site plan for wastewater system design and well location. No underground utilities, water lines or sprinkler systems may be located in the original system or repair areas. A septic tank filter with a riser for access is required. The wastewater system shall not be covered or placed into use until inspected by the Wake County Department of Environmental Services and an Operation Permit issued. An Accepted Status System may be used in place of conventional system, if it can be placed in the permitted/authorized trench footprint (except reduction in line length and/or number as allowed for in approval) and the installation is in accordance with the accepted system approval, without unauthorized product alteration. If permit required use of an Accepted Status System, substitution with another accepted status system may be made, as long as no changes are necessary in the location of each nitrification line (including any increase in line length), trench depth or effluent distribution method. If changes are necessary, prior approval by this office is required before system installation. **OTHER CONDITIONS:**

INSTALL NEW 1000 GALLON ST NEAR EXISTING ST. CRUSH AND FILL OLD ST.

TANK SIZE: 1000 gal. PUMP TANK: _____ gal. SQ FT: _____ STONE DEPTH: _____ in. MAX DEPTH LINE: _____ in.
MAINT: N OPER: N L/O: N TRENCH#: _____ LENGTH: _____ ft. WIDTH: _____ in. DESIGNER: _____
SUBFIELDS: _____ DESIGN HEAD PRESSURE: _____ DESIGN FLOW: _____ gal/min DOSE VOLUME: _____ gal.

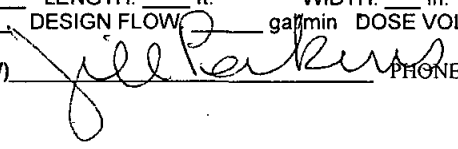CA ISSUED? Y DATE: 09/11/2012 BY: (JEW)  PHONE#: 856-7342


D48090

Nc 42 Hwy



Crash
114
New
1000
gallon
ST

MAP TITLE

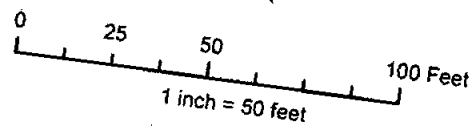

Disclaimer
iMaps makes every effort to produce and publish
the most current and accurate information possible.
However, the maps are produced for information purposes,
and are **NOT** surveys. No warranties, expressed or implied
are provided for the data therein, its use, or its interpretation.