

NO PERMIT(S) FOR CONSTRUCTION, LOCATION OR RELOCATION ACTIVITY SHALL BE ISSUED UNTIL AN
AUTHORIZATION FOR WASTEWATER SYSTEM CONSTRUCTION AUTHORIZATION HAS BEEN ISSUED
***PERMIT VOID IF NOT IN COMPLIANCE WITH ZONING REGULATIONS AND/OR IF SITE IS ALTERED OR
INTENDED USE CHANGED***

DOSING PUMP TANK ELEVATION: 6

RECIRCULATION TANK ELEVATION:

DISTRIBUTION DEVICE ELEVATION: 3

INSTALLED TRENCH DEPTH	INSTALLED AGGREGATE DEPTH	INSTALLED TRENCH LENGTH	INSTALLED TRENCH BOTTOM ELEVATION
23	12	85	6.17
23	12	65	5.65
23	12	65	5.35
23	12	65	5.08
23	12	110	4.5

ACTUAL PRESSURE HEAD: 2

ACTUAL FLOW RATE: 31

ACTUAL DOSE VOLUME: 157


SPECIFIC OPERATION REQUIREMENTS:

ISSUED BY:



DATE: 12/18/2018

As-Built

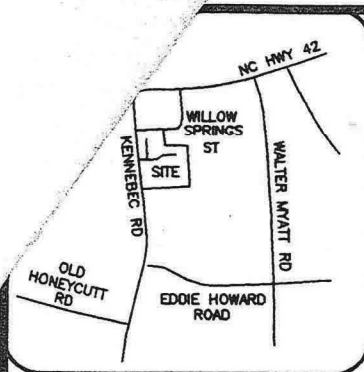

LEGEND

AC=AIR CONDITIONING UNIT
BOC=BACK OF CURB
DW=CONC DRIVEWAY
EB=ELECTRIC BOX
EIR=EXISTING IRON ROD
EOP=EDGE OF PAVEMENT
EP=ELECTRIC PEDESTAL
ICV=IRRIGATION CONTROL VALVE
P=PATIO
PO=PORCH
RCP=REINFORCED CONCRETE PIPE
SCO=CLEANOUT
SW=SIDEWALK
TP=TELEPHONE PEDESTAL
WM=WATER METER
⊙ IRON PIPE FOUND
⊗ IRON PIPE SET
⊙ NAIL SET

THIS SURVEY IS OF AN EXISTING PARCEL OR
PARCELS OF LAND AND DOES NOT CREATE A
NEW STREET OR CHANGE AN EXISTING STREET.

SHAWN T. RUMBERGER, PLS L-4909 DATE

THIS MAP IS ONLY INTENDED FOR THE PARTIES
AND PURPOSES SHOWN. THIS MAP IS NOT FOR
RECORDATION. NO TITLE REPORT PROVIDED.

PORTIONS OF THIS SUBDIVISION ARE LOCATED
IN A FLOOD HAZARD AREA PER
F.E.M.A. MAP #3720068600J
EFF. DATE: 5/2/2006 ZONE X & AE

VICINITY MAP (NTS)


IMPERVIOUS AREA

HOUSE	2,656	SQ.FT.
DRIVE	1,235	SQ.FT.
WALK	144	SQ.FT.
DECK	240	SQ.FT.
PATIO	144	SQ.FT.
TOTAL	4,419	SQ.FT.

SETBACKS

FRONT	35'
SIDE	15'
REAR	30'
SIDE STREET	25'

FUTURE PHASE TWO

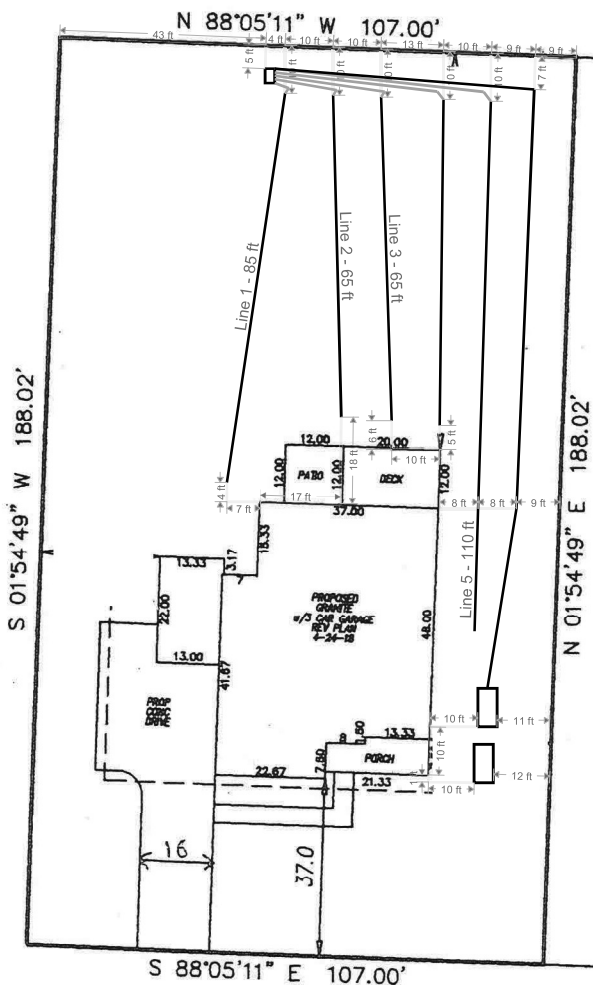

FUTURE PHASE TWO

OLDE JUDD DRIVE
50' PUBLIC R/W

P R E L I M I N A R Y
P L O T P L A N


$$1 \text{ inch} = 40 \text{ ft.}$$

I certify that the location of the planned or existing structure(s) are accurately shown. I understand failure to locate structures in accordance with this plot plan may require the relocation of structure(s) regardless of degree of completion. I hereby grant permission to Municipal/County Representatives the right of entry to make evaluations or inspections upon this property.

Signature of Owner or Authorized Agent

5-24-18

REVISION: FRONT PORCH/HOUSE DIMENSIONS UPDATED PER REQUEST 4-24-18

PROJECT:	16-002 JUDD RESERVE
DRAWN BY:	APS
SCALE:	1"=40'
DATE:	4-23-18

FOR
AMERICAN HOMESMITH
4144 OLDE JUDD DRIVE
LOT 50 JUDD RESERVE SUBDIVISION
MIDDLE CREEK TWP., WAKE CO., NC
B.M. 2016, PG. 2079



ECLS
GLOBAL
U.S. VETERAN-OWNED
19 N MCKINLEY ST
COATS, NC 27521
257 ECLSGLOBAL.COM
329 (FAX) CO#C-4175