

Environmental Services - Water Quality
Onsite Wastewater Scan Data Entry Form

PERMIT #: D026649

PIN #: 0665679700

OP DATE: 0510812003

SYSTEM USE:

- ☒ House
☐ Mobile Home
☐ Business
☐ Other

SEWAGE TYPE:

- ☒ Domestic
☐ Industrial

PUMP/SIPHON?:

- ☐ Yes
☒ No

PRESSURE MANIFOLD:

- ☐ Yes
☒ No

SYSTEM TYPE:

- ☐ I
☐ II
☒ III
☐ IV
☐ V
☐ VI
☐ Other

SUB TYPE:

- ☐ A
☐ B
☐ C
☐ D
☐ E
☐ F
☒ G

NBR BEDROOMS:

- ☐ 1
☐ 2
☒ 3
☐ 4
☐ 5
☐ 6
☐ Other

MAINT. SCHEDULE:

- ☐ Yes
☒ No

CERT. OPERATOR

- ☐ Yes
☒ No

GT ST PT SIZE

- | | | | |
|-------------------------------------|-------------------------------------|-------------------------------------|------------------|
| ☐ | ☐ | | 750 |
| ☐ | ☐ | ☐ | 900 |
| ☐ | ☒ | ☐ | 1,000 |
| ☐ | ☐ | ☐ | 1,200 |
| ☐ | ☐ | ☐ | 1,500 |
| ☐ | ☐ | ☐ | 1,800 |
| ☐ | ☐ | ☐ | 2,100 |
| ☐ | ☐ | ☐ | 2,500 |
| ☐ | ☐ | ☐ | 3,000 |
| ☐ | ☐ | ☐ | 4,000 |
| ☐ | ☐ | ☐ | 5,000 |
| ☐ | ☐ | ☐ | 8,000 |
| ☐ | ☐ | ☐ | 10,000 |
| ☐ | ☐ | ☐ | Other |
| ☒ | | ☒ | None/NA GT or PT |

DRAINFIELD SIZE(SQ. FT.)

00990

DRAIN TYPE:

- ☐ Stone
☒ EZ Flow
☐ Infiltrator
☐ Biodiffuser
☐ Cultec
☐ Drip
☐ Hancor
☐ Large Dia. Pipe
☐ Multi-Pipe
☐ Other

MAX DEPTH (IN.):

- ☐ 12 in. or less
☐ 18 in. or less
☒ 24 in. or less
☐ 26 in. or less
☐ 28 in. or less
☐ 30 in. or less
☐ 32 in. or less
☐ 36 in. or less
☐ Other

STONE DEPTH (IN.):

- ☐ 8 in. or less
☒ 12 in. or less
☐ 18 in. or less
☐ 24 in. or less
☐ Other

TRENCHES:

- ☒ Individual
☐ Bed

TRENCH WIDTH (IN.):

- ☐ 12 in. or less
☐ 18 in.
☐ 24 in.
☒ 36 in.
☐ 6 ft. or less
☐ 9 ft. or less
☐ Other

CH

WAKE COUNTY DEPARTMENT OF ENVIRONMENTAL SERVICES WELL AND SEWAGE SITE LOCATION PERMIT
NO PERMIT(S) FOR CONSTRUCTION, LOCATION OR RELOCATION ACTIVITY SHALL BE ISSUED
UNTIL AN AUTHORIZATION FOR WASTEWATER SYSTEM CONSTRUCTION HAS BEEN ISSUED

PERMIT VOID IF NOT IN COMPLIANCE WITH ZONING REGULATIONS AND/ OR IF SITE IS ALTERED OR INTENDED USE CHANGED

PERMIT#: D026649 STATUS: A APP. DATE: 03/17/2003 BLDG. PERMIT#: 0032252
PIN: 0665.02 67 9700 000 TAX MAP: 0877 0000 RECORDED: Y ORIG. PERMIT#:
TOWNSHIP: 12 MIDDLE CREEK JURISDICTION: WC ZONING: R30
APPLICANT: PETER A. BREWER CONSTRUCT. INC
4804 CYPRESS FORD DR.
FUQUAY-VARINA, NC 27526
(919) 567 - 8900
USE: HD USE: 101 ONE-FAMILY HOUSE
EXIST USE:
DISPOSAL: BEDROOMS: 3 BASEMENT: N #EMPLOYEES: 0
SITE: ADDRESS: 4021 OLDE WAVERLY WAY
SUBDIVISION: OLDE WAVERLY LOT: 32 ACRES: 0.66
DIRECTION: 401 S TL PURFOY RD TL OLDE WAVERLY WAY INTO S/D
(WELL/SEPTIC)

Well System: WATER: INDIVIDUAL - TYPE: NEW

WELL LOG INFORMATION: DEPTH: 225 CASING DEPTH: 45 YIELD: 25.0 STATIC LEVEL: 20
WELL CONTRACTOR: N. W. POOLE REG.# 00004 PUMP CONTRACTOR: REG.#
Construction Compliance GROUT APPROVED ☐ DATE EHS
WELLHEAD APPROVED ☐ DATE EHS
SYSTEM FINALIZED ☐ DATE EHS

COMMENTS:

Operation Permit

DESIGN FLOW: gal./min. ACTUAL FLOW: INNOVATIVE LETTER: R
INSTALLED BY: Rickey Holland INSTALLATION APPROVED BY: Yilmennal
PROPRIETARY SYSTEM: FILTER NO:
COMMENTS:

OPERATIONS PERMIT ISSUED? OP DATE: 05/08/03 BY: Yilmennal

This permit is based in part on information provided by the homeowner or his/her representative in the application submitted for this permit. The Environmental Health Specialist is not responsible for false or misleading information contained in the application. The Environmental Health Specialist is also not responsible for concealed conditions on the property or for statements in this report that may have resulted from false or misleading statements provided to him in the application. Neither Wake County nor the Environmental Health Specialist warrants that the septic tank system will continue to function satisfactorily in the future or that the water supply will remain potable.

As Built Information:

Date: Benchmark: Rod reading: Distance to Structure:
ST: gals ID#: D.O.M.: Elev.: Distance to Well:
PT: gals ID#: D.O.M.: Elev.:
D-box/FD/PM elev.: Supply Line: ft. Pump/Control Panel:
Line 1: Date:
Line 2: Date:
Line 3: Date:
Line 4: Date:
Line 5: Date:
Distance to P/L: Notes:
As Built

WAKE COUNTY DEPARTMENT OF ENVIRONMENTAL SERVICES WELL AND SEWAGE SITE LOCATION PERMIT

NO PERMIT(S) FOR CONSTRUCTION, LOCATION OR RELOCATION ACTIVITY SHALL BE ISSUED

UNTIL AN AUTHORIZATION FOR WASTEWATER SYSTEM CONSTRUCTION HAS BEEN ISSUED

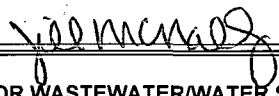
PERMIT VOID IF NOT IN COMPLIANCE WITH ZONING REGULATIONS AND/ OR IF SITE IS ALTERED OR INTENDED USE CHANGED

PERMIT#: D026649 STATUS: A APP. DATE: 03/17/2003 BLDG. PERMIT#: 0032252
PIN: 0665.02 67 9700 000 TAX MAP: 0877 0000 RECORDED: Y ORIG. PERMIT#:
TOWNSHIP: 12 MIDDLE CREEK JURISDICTION: WC ZONING: R30
APPLICANT: PETER A. BREWER CONSTRUCT. INC
4804 CYPRESS FORD DR.
FUQUAY-VARINA, NC 27526
(919) 567 - 8900
USE: HD USE: 101 ONE-FAMILY HOUSE
EXIST USE:
DISPOSAL: BEDROOMS: 3 BASEMENT: N #EMPLOYEES: 0 FOUND DRAIN:
SITE: ADDRESS: 4021 OLDE WAVERLY WAY
SUBDIVISION: OLDE WAVERLY LOT: 32 ACRES: 0.66
DIRECTION: 401 S TL PURFOY RD TL OLDE WAVERLY WAY INTO S/D
(WELL/SEPTIC)

IMPROVEMENT PERMIT

TANK SIZE: 1000 gal. PUMP Tank: ____ gal. SQ FT: 990 INNOVATIVE MAX DEPTH LINE: 24 in.
WASTEWATER: INDIVIDUAL SEWAGE: DOMESTIC TYPE SYSTEM: III G PUMP: N P/M: N
DAILY FLOW: 360 gal/day DESIGN FEE REQ?: PAID?: WATER: INDIVIDUAL

COMMENTS:

IP ISSUED? Y DATE: 04/03/2003 BY: (JEM)  PHONE#: _____

AUTHORIZATION FOR WASTEWATER/WATER SYSTEM CONSTRUCTION

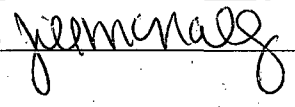
VOID SIXTY (60) MONTHS FROM DATE OF ISSUANCE

AUTHORIZATION CONDITIONS:

Contractors shall install system on contours, see attached site plan for wastewater system design and well location. No underground utilities, water lines or sprinkler systems may be located in the original system or repair areas. A septic tank filter with a riser for access is required. The wastewater system shall not be covered or placed into use until inspected by the Wake County Department of Environmental Services and an Operation Permit issued. **OTHER CONDITIONS:**

INSTALL LINES ON CONTOUR. MAINTAIN ALL SETBACKS. MAX TRENCH DEPTH IS 24" ON DEEPEST SIDE OF TRENCH. IF SITE OR SITE PLAN CHANGES, PERMIT IS VOID. DO NOT GRADE OR REMOVE ANY SOIL FROM SEPTIC SYSTEM OR REPAIR AREA. CALL PRIOR TO INSTALLATION WITH ANY QUESTIONS, COMMENTS OR CONCERNS. DO NOT INSTALL IRRIGATION SYSTEM OVER DRIANLINES. TAKE CARE NOT TO CROSS UTILITIES LINES OVER SEPTIC SYSTEM.

TANK SIZE: 1000 gal. PUMP TANK: ____ gal. SQ FT: 990 INNOVATIVE MAX DEPTH LINE: 24 in.
MAINT: N OPER: N L/O: Y TRENCH#: 3 LENGTH: 83 ft. WIDTH: 36 in. DESIGNER: ____
SUBFIELDS: ____ DESIGN HEAD PRESSURE: ____ DESIGN FLOW: ____ gal/min DOSE VOLUME: ____ gal.

CA ISSUED? Y DATE: 04/03/2003 BY: (JEM)  PHONE#: _____

WAKE COUNTY DEPARTMENT OF ENVIRONMENTAL SERVICES WELL AND SEWAGE SITE LOCATION PERMIT
NO PERMIT(S) FOR CONSTRUCTION, LOCATION OR RELOCATION ACTIVITY SHALL BE ISSUED
UNTIL AN AUTHORIZATION FOR WASTEWATER SYSTEM CONSTRUCTION HAS BEEN ISSUED

PERMIT VOID IF NOT IN COMPLIANCE WITH ZONING REGULATIONS AND/ OR IF SITE IS ALTERED OR INTENDED USE CHANGED

PERMIT#: D026649 STATUS: A APP. DATE: 03/17/2003 BLDG. PERMIT#: 0032252
PIN: 0665.02 67 9700 000 TAX MAP: 0877 0000 RECORDED: Y ORIG. PERMIT#:
TOWNSHIP: 12 MIDDLE CREEK JURISDICTION: WC ZONING: R30
APPLICANT: PETER A. BREWER CONSTRUCT. INC
4804 CYPRESS FORD DR.
FUQUAY-VARINA, NC 27526
(919) 567 - 8900
USE: HD USE: 101 ONE-FAMILY HOUSE
EXIST USE:
DISPOSAL: BEDROOMS: 3 BASEMENT: N #EMPLOYEES: 0
SITE: ADDRESS: 4021 OLDE WAVERLY WAY
SUBDIVISION: OLDE WAVERLY LOT: 32 ACRES: 0.66
DIRECTION: 401 S TL PURFOY RD TL OLDE WAVERLY WAY INTO S/D
(WELL/SEPTIC)

Well System: WATER: INDIVIDUAL TYPE: NEW

WELL LOG INFORMATION: DEPTH: 25 CASING DEPTH: 45 YIELD: 25 STATIC LEVEL: 120
WELL CONTRACTOR: NAW 1006 REG.# 4 PUMP CONTRACTOR: NAW 1006 REG.# 546
Construction Compliance GROUT APPROVED ☒ DATE 4/15/03 EHS: [Signature]
12457 WELLHEAD APPROVED ☒ DATE 4/24/03 EHS: [Signature]
SYSTEM FINALIZED ☒ DATE 7/17/03 EHS: [Signature]

COMMENTS:

Operation Permit

DESIGN FLOW: _____ gal./min. ACTUAL FLOW: _____ INNOVATIVE LETTER: _____

INSTALLED BY: _____ INSTALLATION APPROVED BY: _____
PROPRIETARY SYSTEM: _____ FILTER NO: _____
COMMENTS: _____

OPERATIONS PERMIT ISSUED? _____ OP DATE: [Stamp] BY: [Stamp]

This permit is based in part on information provided by the homeowner or his/her representative in the application submitted for this permit. The Environmental Health Specialist is not responsible for false or misleading information contained in the application. The Environmental Health Specialist is also not responsible for concealed conditions on the property or for statements in this report that may have resulted from false or misleading statements provided to him in the application. Neither Wake County nor the Environmental Health Specialist warrants that the septic tank system will continue to function satisfactorily in the future or that the water supply will remain potable.

As Built Information:

Date: _____ Benchmark: _____ Rod reading: _____ Distance to Structure: _____
ST: _____ gals ID#: _____ D.O.M.: _____ Elev.: _____ Distance to Well: _____
PT: _____ gals ID#: _____ D.O.M.: _____ Elev.: _____
D-box/FD/PM elev.: _____ Supply Line: _____ ft. Pump/Control Panel: _____
Line 1: _____ Date: _____
Line 2: _____ Date: _____
Line 3: _____ Date: _____
Line 4: _____ Date: _____
Line 5: _____ Date: _____
Distance to P/L: _____ Notes: _____

WAKE COUNTY DEPARTMENT OF ENVIRONMENTAL SERVICES WELL AND SEWAGE SITE LOCATION PERMIT
NO PERMIT(S) FOR CONSTRUCTION, LOCATION OR RELOCATION ACTIVITY SHALL BE ISSUED
UNTIL AN AUTHORIZATION FOR WASTEWATER SYSTEM CONSTRUCTION HAS BEEN ISSUED

PERMIT VOID IF NOT IN COMPLIANCE WITH ZONING REGULATIONS AND/ OR IF SITE IS ALTERED OR INTENDED USE CHANGED

PERMIT#: D026649 STATUS: A APP. DATE: 03/17/2003 BLDG. PERMIT#: 0032252
PIN: 0665.02 67 9700 000 TAX MAP: 0877 0000 RECORDED: Y ORIG. PERMIT#:
TOWNSHIP: 12 MIDDLE CREEK JURISDICTION: WC ZONING: R30
APPLICANT: PETER A. BREWER CONSTRUCT. INC
4804 CYPRESS FORD DR.
FUQUAY-VARINA, NC 27526
(919) 567 - 8900
USE: HD USE: 101 ONE-FAMILY HOUSE
EXIST USE:
DISPOSAL: BEDROOMS: 3 BASEMENT: N #EMPLOYEES: 0 FOUND DRAIN:
SITE: ADDRESS: 4021 OLDE WAVERLY WAY
SUBDIVISION: OLDE WAVERLY LOT: 32 ACRES: 0.66
DIRECTION: 401 S TL PURFOY RD TL OLDE WAVERLY WAY INTO S/D
(WELL/SEPTIC)

IMPROVEMENT PERMIT

TANK SIZE: 1000 gal. PUMP Tank: ____ gal. SQ FT: 990 STONE DEPTH: 12 in. MAX DEPTH LINE: 24 in.
WASTEWATER: INDIVIDUAL SEWAGE: DOMESTIC TYPE SYSTEM: II A PUMP: N P/M: N
DAILY FLOW: 360 gal/day DESIGN FEE REQ?: PAID?: WATER: INDIVIDUAL

COMMENTS:

IP ISSUED? Y DATE: 04/03/2003 BY: (JEM) Jim McNally PHONE#:

AUTHORIZATION FOR WASTEWATER/WATER SYSTEM CONSTRUCTION

VOID SIXTY (60) MONTHS FROM DATE OF ISSUANCE

AUTHORIZATION CONDITIONS:

Contractors shall install system on contours, see attached site plan for wastewater system design and well location. No underground utilities, water lines or sprinkler systems may be located in the original system or repair areas. A septic tank filter with a riser for access is required. The wastewater system shall not be covered or placed into use until inspected by the Wake County Department of Environmental Services and an Operation Permit issued. **OTHER CONDITIONS:**

INSTALL LINES ON CONTOUR. MAINTAIN ALL SETBACKS. MAX TRENCH DEPTH IS 24" ON DEEPEST SIDE OF TRENCH. IF SITE OR SITE PLAN CHANGES, PERMIT IS VOID. DO NOT GRADE OR REMOVE ANY SOIL FROM SEPTIC SYSTEM OR REPAIR AREA. CALL PRIOR TO INSTALLATION WITH ANY QUESTIONS, COMMENTS OR CONCERNS. DO NOT INSTALL IRRIGATION SYSTEM OVER DRIANLINES. TAKE CARE NOT TO CROSS UTILITIES LINES OVER SEPTIC SYSTEM.

TANK SIZE: 1000 gal. PUMP TANK: ____ gal. SQ FT: 990 STONE DEPTH: 12 in. MAX DEPTH LINE: 24 in.
MAINT: N OPER: N L/O: Y TRENCH#: 3 LENGTH: 110 ft. WIDTH: 36 in. DESIGNER: ____
SUBFIELDS: ____ DESIGN HEAD PRESSURE: ____ DESIGN FLOW: ____ gal/min DOSE VOLUME: ____ gal.

CA ISSUED? Y DATE: 04/03/2003 BY: (JEM) Jim McNally PHONE#:

CA Site Plan
4.00' 15' Rear
6032252
D-026649

LOT 20750 s.f.

IMPERVIOUS SOILS

HOUSE 3900 s.f.
DRIVEWAY 480
WALK 220
4600 s.f.

PERCENT IMPROVEMENT 16%

PIN: 0665. 02-67-9700

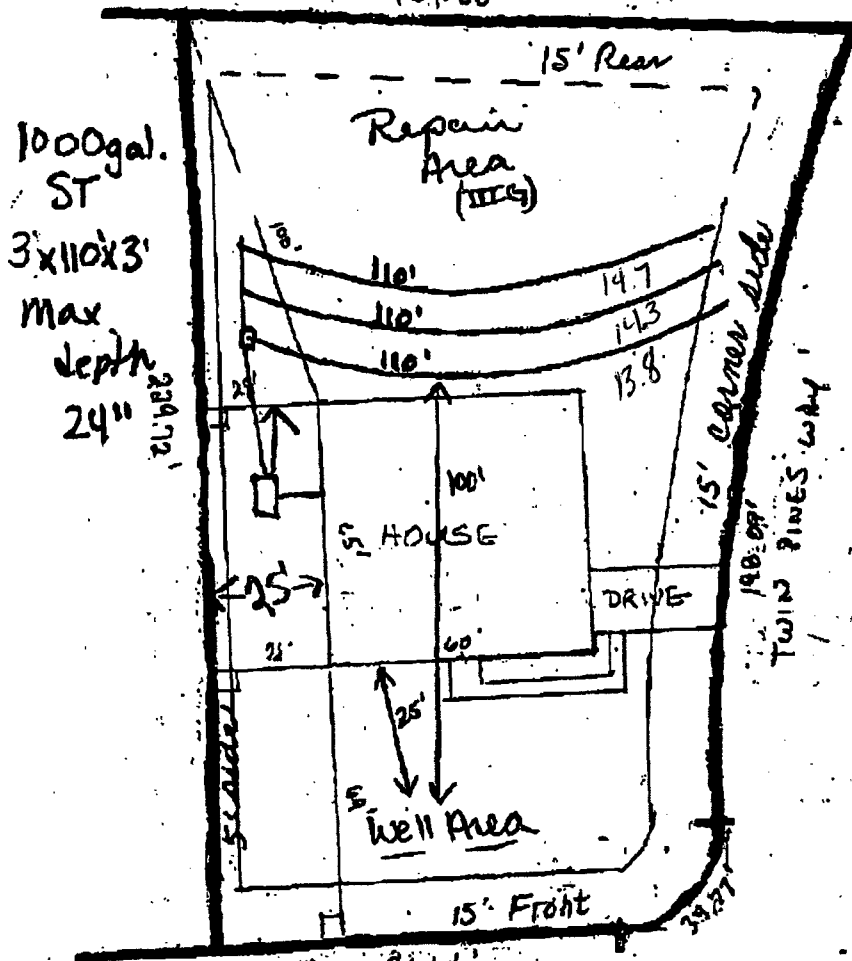
I certify that the location of planned or existing structure(s) are accurately shown. I understand failure to locate structures in accordance with this plot plan, may require the relocation of structure(s) regardless degree of completion. I hereby grant permission to Municipal/County Representatives the right of entry to make evaluations or inspections upon this property.

Signature of Owner or Authorized Agent:

Zoning R30 By SBC
 Approve ✓ Date 3-17-2003
 Review _____ Use 101
 Reject _____ NIBL _____
 Floor 15 Rear 15'
 Side 5 Corner 15'
 Comments _____

**PETER A. BREWER
CONSTRUCTION, INC.
4804 CYPRESS FORD DRIVE
FUQUAY-VARINA, NC 27626**

(919) 567-8900 Offic.
(919) 557-4775 Fax.
(919) 432-3670 Mobi



4021 OLDE WANDERLY WAY

BT 51000
STB 103

SITE PLAN

OLDE WAVERLY PHASE 1 LOT 32
SCALE 1"=40'
3/17/2003

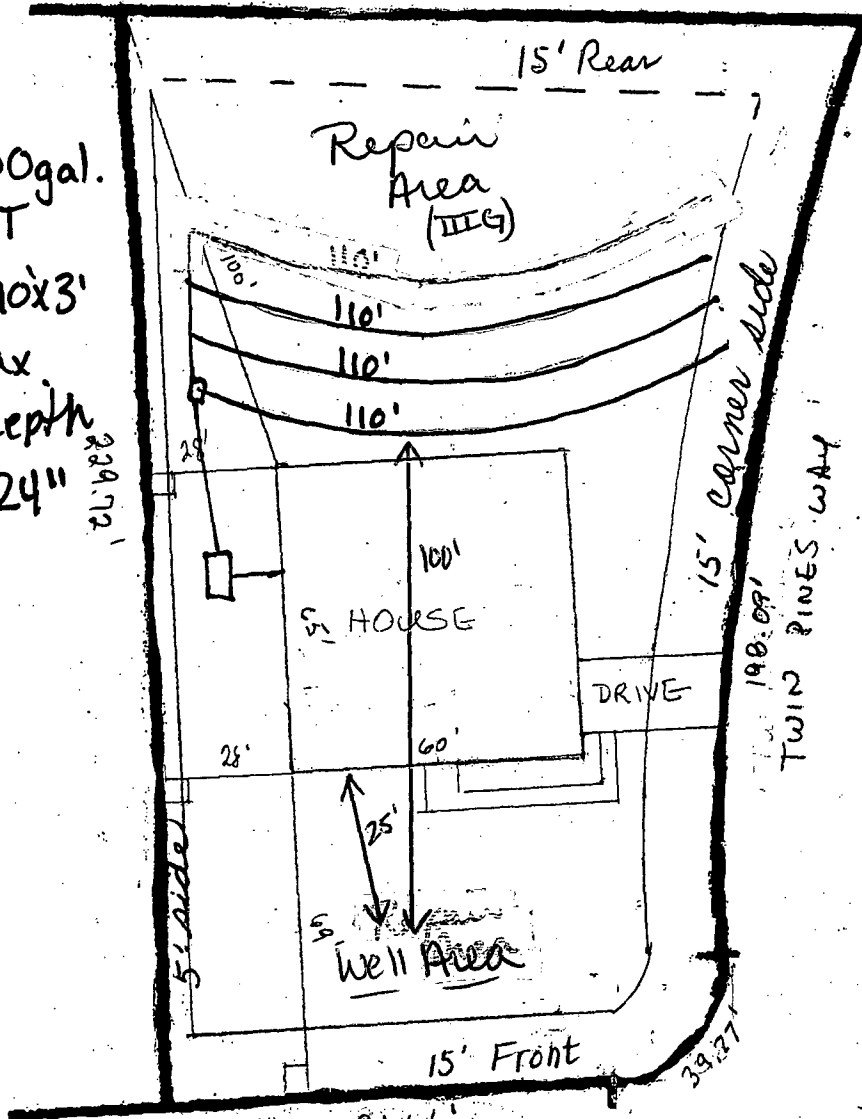
247.50
(3) 85 EZ 4 (2554)
260

2 PM

CA Site Plan

0032252
D-026649

1000gal.
ST
3'x110'x3'
Max
depth
24"



LOT 28750 s.f.

IMPERVIOUS SOILS

HOUSE 3900 s.f.
DRIVEWAY 480
WALK 220
4600 s.f.

PERCENT IMPERVIOUS 16%

PIN: 0665.02-67-9700

I certify that the location of planned or existing structure(s) are accurately shown. I understand failure to locate structures in accordance with this plot plan may require the relocation of structure(s) regardless degree of completion. I hereby grant permission to Municipal/County Representatives the right of entry to make evaluations or inspections upon this property.

Peter A. Brewer

Signature of Owner or Authorized Agent

3-17-03

Zoning R30 By SBC
Approve ✓ Date 3-17-2003
Revise _____ Use 101
Reject _____ MBL _____
Front 15 Rear 15'
Side 5 Corner 15'
Comments _____

SITE PLAN

OLDE WAVERLY PHASE 1 LOT 32
SCALE 1" = 40'
3/17/2003

PETER A. BREWER
CONSTRUCTION, INC.
4804 CYPRESS FORD DRIVE
FUQUAY-VARINA, NC 27526
(919) 567-8900 Office
(919) 557-9775 Fax
(919) 422-3670 Mobile

May 01 03 12:04p

Ricky Lynn Holland

919-639-3130

p.1

I, Pete Brewer hereby request the chamber system or
 polystyrene aggregate system called EZ FLOW to
 be used in my sewage disposal system. I understand that I will be
 granted a 25% reduction in the amount of required drainfield for my
 property. My property is located at Lot 32 Olde Waverly

* Pete A. Brewer Owner
 * 5/5/2003 Date
 D# 026649
 Blding Permit # 0032252
 PIN: 0665-02679700

Generic NameProprietary Name

☐ Drip System
☐ Chamber Trench Sys.
☐ Brunswick Bed/Fill Sys.
☐ Chamber Trench Sys.
☒ Polystyrene Aggregate Tr
☐ Chamber Trench
☐ Polyethylene
☐ Sand Filter Pretreatment
☐ Chamber Trench
☐ Peat Filter Pret. Sys.
☐ Fibermesh Reinforced Tanks

"Perc-Rite" Subsurface
 "Infiltrator" Chambered
 "Brunswick" Bed/Fill
 "Hancor EnviroChamber"
 Houck Drainage Sys.
 "Contractor Model 75,100,125, and field drain"
 Norwesco P.E. Tanks
 Pressure Dosed Sand
 "Bio Diffuser" Low Profile
 Puraflo Peat Biofilter Sys.
 Fibermesh Reinforced Tank

Attention: *Jill Nally*

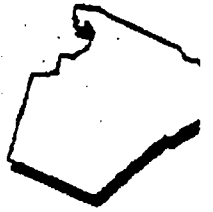
WAKE COUNTY

Department of Environmental Services

Water, Wastewater and Development Services

(919) 856-7400 FAX: (919) 856-7407

PO Box 550, Raleigh, NC 27602

**REVISIONS THAT DO NOT NEED REVISED SITE PLANS**D # 026649

PIN # _____

Building Permit # 0032252

- Change of Bedrooms from 4
to 3
- Change of Name on Permit * _____
- Change of Foundation _____
- Change of Garbage Disposal _____
- Change of Employees _____

* Need Name, Address and Phone Number of New Applicant

Comments:

Applicant Signature

Peter R. Brewer

Date

4/3/2003

Permit Processor _____

Date _____

To protect and improve the quality of Wake County's environment and ensure a healthy future
for its citizens through cooperation, education, management and enforcement

WELL CONSTRUCTION RECORD

North Carolina - Department of Environment and Natural Resources - Division of Water Quality - Groundwater Section

WELL CONTRACTOR (INDIVIDUAL) NAME (print) DONN BERRYHILL CERTIFICATION # 2635

WELL CONTRACTOR COMPANY NAME _____ PHONE # () _____

STATE WELL CONSTRUCTION PERMIT# _____ ASSOCIATED WQ PERMIT# _____
(if applicable) (if applicable)

1. WELL USE (Check Applicable Box): Residential ☒ Municipal/Public ☐ Industrial ☐ Agricultural ☐
Monitoring ☐ Recovery ☐ Heat Pump Water Injection ☐ Other ☐ If Other, List Use _____

2. WELL LOCATION:
Nearest Town: Fugate Valley County WAKE

(Street Name, Numbers, Community, Subdivision, Lot No., Zip Code)

Topographic/Land setting
☐ Ridge ☒ Slope ☐ Valley ☐ Flat
(check appropriate box)

Latitude/longitude of well location

3. OWNER:
Address _____
(Street or Route No.)

City or Town _____ State _____ Zip Code _____

Area code: Phone number _____

4. DATE DRILLED 4-14-03

5. TOTAL DEPTH: 225'

6. DOES WELL REPLACE EXISTING WELL? YES ☐ NO ☒

7. STATIC WATER LEVEL Below Top of Casing: 20 FT.

(Use "4" if Above Top of Casing)

8. TOP OF CASING IS 1.5 FT. Above Land Surface*

*Top of casing terminated at/or below land surface requires a variance in accordance with 15A NCAC 2C .0118.

9. YIELD (gpm): 25 METHOD OF TEST Blow

10. WATER ZONES (depth): 195'

(degrees/minutes/seconds)
Latitude/longitude source: ☐ GPS ☐ Topographic map
(check box)

DEPTH DRILLING LOG
From To Formation Description

0	2	Top Soil
2	13	Clay
13	30	Sand & Clay
30	45	Slat
45	225	Slat

LOCATION SKETCH

Show direction and distance in miles from at least two State Roads or County Roads. Include the road numbers and common road names.

11. DISINFECTION: Type HTH Amount 1/2 lb

12. CASING: Wall Thickness
From 0 To 45 Ft. Diameter 6 1/4 or Weight/Ft. 1188 Material Galv

13. GROUT: Depth Material Method
From 0 To 22 Ft. Port-Sand Gravity

14. SCREEN: Depth Diameter Slot Size Material
From _____ To _____ Ft. _____ in. _____ in. _____

15. SAND/GRAVEL PACK: Depth Size Material
From _____ To _____ Ft. _____ _____

16. REMARKS: DH

I DO HEREBY CERTIFY THAT THIS WELL WAS CONSTRUCTED IN ACCORDANCE WITH 15A NCAC 2C, WELL CONSTRUCTION STANDARDS, AND THAT A COPY OF THIS RECORD HAS BEEN PROVIDED TO THE WELL OWNER

Donn Berryhill

SIGNATURE OF PERSON CONSTRUCTING THE WELL

DATE

4-14-03

Submit the original to the Division of Water Quality, Groundwater Section, 1636 Mail Service Center - Raleigh, NC 27699-1636 Phone No. (919) 733-3221, within 30 days.

GW-1 REV. 07/2001