

Environmental Services - Water Quality
Onsite Wastewater Scan Data Entry Form

PERMIT #: 0017208

PIN #: 0655295597

OP DATE: 1010912003

SYSTEM USE:

- ☒ House
☐ Mobile Home
☐ Business
☐ Other

SEWAGE TYPE:

- ☒ Domestic
☐ Industrial

PUMP/SIPHON?:

- ☐ Yes
☒ No

PRESSURE MANIFOLD:

- ☐ Yes
☒ No

SYSTEM TYPE:

- ☐ I
☒ II
☐ III
☐ IV
☐ V
☐ VI
☐ Other

SUB TYPE:

- ☒ A
☐ B
☐ C
☐ D
☐ E
☐ F
☐ G

NBR BEDROOMS:

- ☐ 1
☐ 2
☒ 3
☐ 4
☐ 5
☐ 6
☐ Other

MAINT. SCHEDULE:

- ☐ Yes
☒ No

CERT. OPERATOR

- ☐ Yes
☒ No

GT ST PT SIZE

- | | | | |
|-------------------------------------|-------------------------------------|-------------------------------------|------------------|
| ☐ | ☐ | | 750 |
| ☐ | ☐ | ☐ | 900 |
| ☐ | ☒ | ☐ | 1,000 |
| ☐ | ☐ | ☐ | 1,200 |
| ☐ | ☐ | ☐ | 1,500 |
| ☐ | ☐ | ☐ | 1,800 |
| ☐ | ☐ | ☐ | 2,100 |
| ☐ | ☐ | ☐ | 2,500 |
| ☐ | ☐ | ☐ | 3,000 |
| ☐ | ☐ | ☐ | 4,000 |
| ☐ | ☐ | ☐ | 5,000 |
| ☐ | ☐ | ☐ | 8,000 |
| ☐ | ☐ | ☐ | 10,000 |
| ☐ | ☐ | ☐ | Other |
| ☒ | | ☒ | None/NA GT or PT |

DRAINFIELD SIZE(SQ. FT.)

00900

DRAIN TYPE:

- ☒ Stone
☐ EZ Flow
☐ Infiltrator
☐ Biodiffuser
☐ Cultec
☐ Drip
☐ Hancor
☐ Large Dia. Pipe
☐ Multi-Pipe
☐ Other

MAX DEPTH (IN.):

- ☐ 12 in. or less
☐ 18 in. or less
☒ 24 in. or less
☐ 26 in. or less
☐ 28 in. or less
☐ 30 in. or less
☐ 32 in. or less
☐ 36 in. or less
☐ Other

STONE DEPTH (IN.):

- ☐ 8 in. or less
☒ 12 in. or less
☐ 18 in. or less
☐ 24 in. or less
☐ Other

TRENCHES:

- ☒ Individual
☐ Bed

TRENCH WIDTH (IN.):

- ☐ 12 in. or less
☐ 18 in.
☐ 24 in.
☒ 36 in.
☐ 6 ft. or less
☐ 9 ft. or less
☐ Other

B.W 9/4/14

WAKE COUNTY DEPARTMENT OF ENVIRONMENTAL SERVICES WELL AND SEWAGE SITE LOCATION PERMIT

NO PERMIT(S) FOR CONSTRUCTION, LOCATION OR RELOCATION ACTIVITY SHALL BE ISSUED
UNTIL AN AUTHORIZATION FOR WASTEWATER SYSTEM CONSTRUCTION HAS BEEN ISSUED

PERMIT VOID IF NOT IN COMPLIANCE WITH ZONING REGULATIONS AND/OR IF SITE IS ALTERED OR INTENDED USE CHANGED

PERMIT#: D017208 STATUS: A APP DATE: 02/08/2000 BLDG PERMIT#:
 APPLICANT: CRABTREE, ROBERT DAY PHONE: (919) 552 - 5897
 ADDRESS: 5528 STICKLEBACK DR FAX#: (000) 000 - 0000
 CITY: FUQUAY VARINA STATE: NC ZIP: 27526
 OWNER: ROBERT CRABTREE BUILDER I DAY PHONE: (919) 552 - 5897
 ADDRESS: SAME FAX#: (000) 000 - 0000
 CITY: SAME STATE: NC ZIP: 27526
 HD USE CD: 101 ONE-FAMILY HOUSE ORIG PERMIT#: REC?: Y
 EXIST USE: TAX MAP#: 0875 003A
 BEDROOMS: 3 BSMT: N #EMPLOYEES: 0 WATER: P WASTEWATER: I GARB DISPOSAL: N
 TOWNSHIP: 12 MIDDLE CREEK JURIS: FUX ZON: PIN: ~~0655-01-39-2284-000~~ 655.29
 SUBD#: S 000 000 00 SUBD NAME: GRAY STONE LOT-SEC: 09 ACRE: .5 5597
 IMPRV PRMT: ISSUED?: Y DATE: 04/20/2000 BY: SFM TYPE SYSTEM: II A PUMP:
 CNSTR AUTH: ISSUED?: Y DATE: 04/20/2000 BY: SFM MAINT: N OPER: N
 RECEIPT#: 0001284 FEE: 145.00 OP DATE: BY:
 WATR SAMPL: REQ?: N APPROVED?: DATE: PROPRIETARY SYS:
 ST#: 1616 MI: DIR: NAME: WET STONE DIR: TYP: DR
 DIRECTIONS: TAKE WAGSTAFF RD W TL WETSTONE DR LOT ON LEFT

IMPROVEMENT PERMIT

SIZE OF TANK 1000 ST PT GALS. TOTAL SQ. FT. 900 DEPTH OF STONE 12 IN. MAX. DEPTH LINE 24 IN.

WASTEWATER: DOMESTIC ☒ INDUSTRIAL ☐

I.P. ISSUED BY

Steve Meyer, RS

AUTHORIZATION FOR WASTEWATER SYSTEM CONSTRUCTION

VOID SIXTY (60) MONTHS FROM DATE OF ISSUANCE

AUTHORIZATION CONDITIONS

Contractor To Follow Contours, See Attached Site Plan For Wastewater System Design And Well Location. The wastewater system shall not be covered or placed into use until inspected by the Wake County Department of Environmental Services and an Operation Permit issued.

OTHER CONDITIONS: INSTALL LINES ON CONTOUR WITH NO STEPDOWNS. REMOVE ALL TREES THAT INTERFERE WITH INSTALLING SYSTEM ON 9'CENTERS. CALL PRIOR TO INSTALLATION WITH ANY QUESTIONS OR CHANGES.

SIZE OF TANK 1000 ST PT GALS. TOTAL SQ. FT. DEPTH OF STONE 12 IN. MAX. DEPTH LINE 24 IN.

ST FILTER REQUIRED ☒ NUMBER OF TRENCHES 3 LENGTH OF TRENCHES 100 FT. WIDTH OF TRENCHES 3 FT.

C.A. ISSUED BY *Steve Meyer, RS* INSTALLED BY *Dennis medlin* CTR. I.D. #

SEPTIC TANK FILTER USED

INNOV. APPL. #: IWWS- DATE 10/6/03 INSTALLATION APPROVED BY *Jill McNeal*

WELL SYSTEM = PRIVATE ☐ SEMI-PUBLIC ☐ NEW ☐ REPLACEMENT ☐ EXISTING ☐

WELL LOG INFORMATION = DEPTH CASING DEPTH YIELD STATIC LEVEL

WELL CONTRACTOR REG.# PUMP CONTRACTOR REG.#

CONSTRUCTION COMPLIANCE = GROUT APPROVED ☐ DATE EHS

WCHD ID # WELLHEAD APPROVED ☐ DATE EHS

NEGATIVE BACTERIOLOGICAL RESULTS ☐ DATE EHS

SYSTEM FINALIZED ☐ DATE EHS

COMMENTS:


This permit is based in part on information provided by the homeowner or his/her representative in the application submitted for this permit. The Environmental Health Specialist is not responsible for false or misleading information contained in the application. The Environmental Health Specialist is also not responsible for concealed conditions on the property or for statements in this report that may have resulted from false or misleading statements provided to him in the application. Neither Wake County nor the Environmental Health Specialist warrants that the septic tank system will continue to function satisfactorily in the future or that the water supply will remain potable.

KEULKE Ann: Steve Myers

NOTE: SUBJECT PROPERTY IS ☐ IS NOT ☐ LOCATED IN A
SPECIAL FLOOD HAZARD AREA. SEE F.E.M.A. FLOOD
INSURANCE RATE MAP _____ ZONE _____
EFFECTIVE DATE _____

NC GRID NORTH
BM. 1985, PG. 1960

N

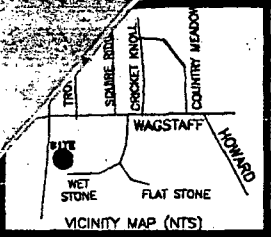

LEGEND

EIP EXISTING IRON PIPE
PP POWER POLE
W/M WATER METER
TB TELEPHONE BOX
IPS IRON PIPE SET
CP&L TRANSFORMER
CTV CABLE TV
L. POLE LIGHT POLE
OHPL OVERHEAD POWER LINE
F.E.S. FLARED END SECTION
RCP REINFORCED CONC. PIPE
B.O.C. BACK OF CURB
F.H. FIRE HYDRANT
C/O SEWER CLEAN OUT

I certify that the location of planned or existing structure(s) are accurately shown. I understand failure to locate structures in accordance with this plot plan may require the relocation of structure(s) regardless degree of completion. I hereby grant permission to Municipal/County Representatives the right of entry to make evaluations of ~~the property~~ this property.

Signature of Owner or Authorized Agent

(PIPE)

CURVE RADIUS LENGTH CHORD CH.BEARING


C1 50.00' 51.76' 49.48' S 40°41'08"W

As Built

pl- Need last
50' of 3rd line.
gen.

J.C. BENDER
DB. 4422-657

SOUTHERN RAILWAY 100' R/W

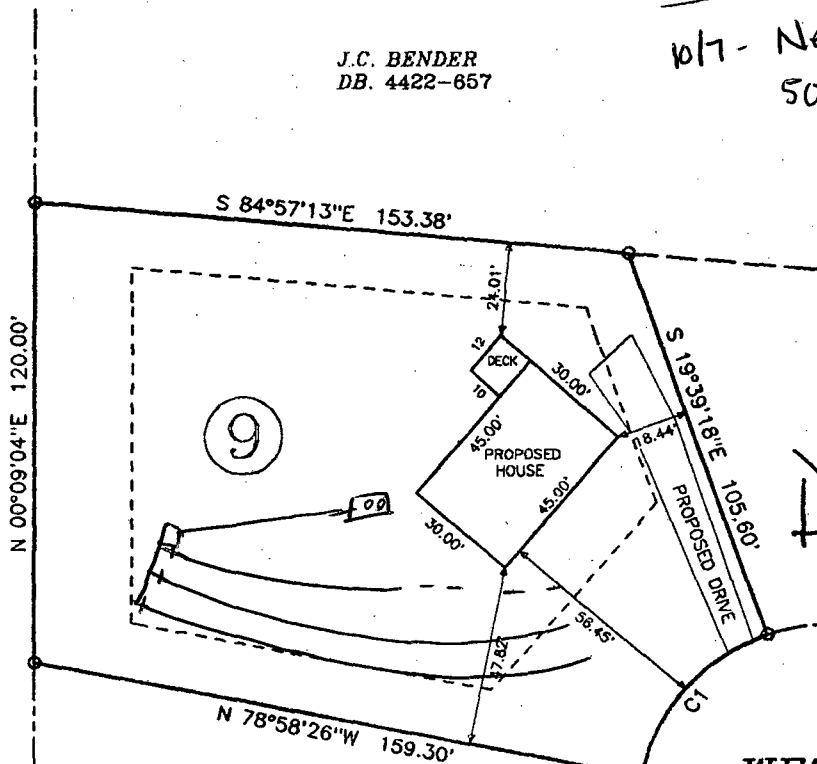

Zoning _____ By _____

Approve _____ Date _____

Revise _____ Use _____


Reject _____ MBL _____

Front _____ Rear _____

Side _____ Corner _____

Comments:


50 0 50 100 150

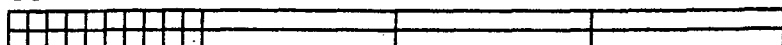

GRAPHIC SCALE - FEET

NOTE: SHOWN IS LOT 9 OF
GRAY STONE S/D.
REF: BM. 1999, PG. 1318


AREA = 21,879 SQ. FT.
1616 WET STONE DRIVE

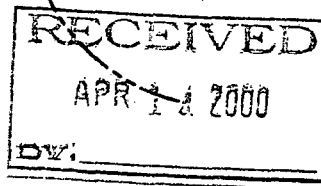

KEUKE Ann: Steve Myers

NOTE: SUBJECT PROPERTY IS ☐ IS NOT ☐ LOCATED IN A SPECIAL FLOOD HAZARD AREA. SEE F.E.M.A. FLOOD INSURANCE RATE MAP _____ ZONE _____ EFFECTIVE DATE _____

NC GRID NORTH
BM. 1985, PG. 1960

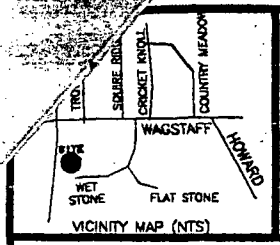

- LEGEND**
- EIP EXISTING IRON PIPE
 - PP POWER POLE
 - W/M WATER METER
 - TB TELEPHONE BOX
 - IPS IRON PIPE SET
 - CP&L TRANSFORMER
 - CTV CABLE TV
 - L. POLE LIGHT POLE
 - OHPL OVERHEAD POWER LINE
 - F.E.S. FLARED END SECTION
 - RCP REINFORCED CONC. PIPE
 - B.O.C. BACK OF CURB
 - F.H. FIRE HYDRANT
 - C&O SEWER CLEAN OUT

I certify that the location of planned or existing structure(s) are accurately shown. I understand failure to locate structures in accordance with this plot plan may require the relocation of structure(s) regardless degree of completion. I hereby grant permission to Municipal/County Representatives the right of entry to make evaluations of structures on this property.


[Signature]

Signature of Owner or Authorized Agent

CURVE	RADIUS	LENGTH	CHORD	CH.BEARING
C1	50.00'	51.76'	49.48'	S 40°41'08"W

- CA
- * 1000 gal IT
 - * 900 sq. FT
 - * 3-100' x 3' Lines
 - * 24" max T.D.
 - * No STEP DOWNS
 - * Call Prior to Installation with any questions or changes

SOUTHERN RAILWAY 100' R/W

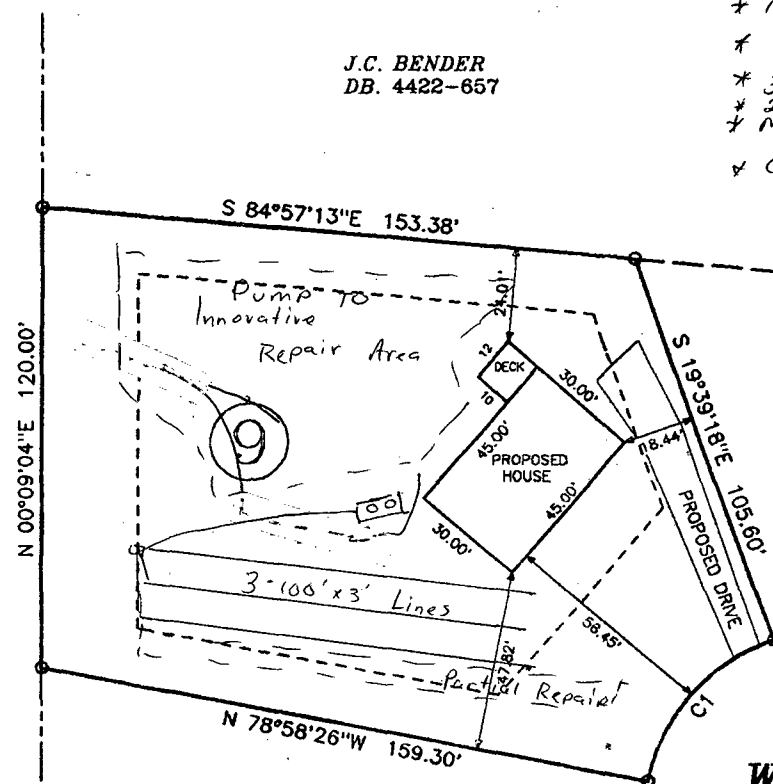

8
D17208

WET STONE DRIVE 50'R/W

Zoning _____ By _____

Approve _____ Date 10

Revise _____ Use _____

Reject _____ MBL _____

Front _____ Rear _____

Side _____ Corner _____

RECEIVED
APR 14 2000
DW:

NOTE: SHOWN IS LOT 9 OF GRAY STONE S/D.
REF: BM. 1999, PG. 1318
AREA = 21,879 SQ. FT.
1616 WET STONE DRIVE

