

WAKE COUNTY DEPARTMENT OF ENVIRONMENTAL SERVICES WASTEWATER PERMIT
NO PERMIT(S) FOR CONSTRUCTION, LOCATION OR RELOCATION ACTIVITY SHALL BE ISSUED UNTIL AN
AUTHORIZATION FOR WASTEWATER SYSTEM CONSTRUCTION AUTHORIZATION HAS BEEN ISSUED
***PERMIT VOID IF NOT IN COMPLIANCE WITH ZONING REGULATIONS AND/OR IF SITE IS ALTERED OR
INTENDED USE CHANGED***

OPERATIONS PERMIT

PERMIT # D059876 **APPLICATION DATE:** 05/16/2018 **BLDG. PERMIT#:**
PIN: 0647236503 **RECORDED:** Yes
TOWNSHIP: 06 - Holly Springs **JURISDICTION:** Holly Springs **ZONING:**
APPLICANT: Sean Wilson **BUSINESS PHONE:**
1210 Trinity Rd 102 **HOME PHONE:**
 MOBILE PHONE: (919) 376-5656
HD USE: 101A CONVENTIONAL ONE-FAMILY HOUSE **EXISTING USE:**
SITE ADDRESS: 00101 Jewell Farm LN
SUBDIVISION: BALLENTINE PLAC **LOT:** 36 **ACRES:** 0.75
DIRECTIONS:

Systems defined as either type III-b, III-g with a pump, IV, V or VI, in accordance with the North Carolina administrative code 15A NCAC 18a .1961, table V as adopted by reference in the "Regulations Governing Wastewater Treatment Dispersal Systems in Wake County", requires Wake County Environmental Services to conduct periodic inspections of the system type pursuant to 15A NCAC 18a. 1961 (j). Fees for these inspections will be charged as per the approved Fee Schedule. In addition, all systems are to be operated and maintained as specified in 15A NCAC 18A .1961. This permit is based in part on information provided by the homeowner and/or his/her representative in the application submitted for this permit. The Environmental Health Specialist is not responsible for false or misleading information contained in the application. The environmental health specialist is also not responsible for concealed conditions on the property or for statements in this report that may have resulted from false or misleading statements provided to him/her in the application. Neither Wake County nor the Environmental Health Specialist warrants that the septic tank system will continue to function satisfactorily in the future or that the water supply will remain potable.

OPERATION PERMIT VALID FOR: No Expiration
INSTALLED BY: BRANTLEY, CORY - 1036 - IV
PROPRIETARY SYSTEM: EZ1203HG - EZFlow EZ 1203H Geo **PRETREATMENT SYSTEM:**
SYSTEM TYPE INSTALLED: II A
OPERATION PERMIT: **STATUS:** Issued **ISSUED BY:** Alexander Brown **ISSUED DATE:** 09/19/2018
SEPTIC TANK: David Brantley & Sons - STB-323 - 1250 gallons **DATE OF MANUFACTURE:** 06/06/2018 **FILTER:** GAG SIM/TECH - STF-100
GREASE TRAP: **DATE OF MANUFACTURE:** **FILTER:**
DOSING PUMP TANK: **DATE OF MANUFACTURE:** **FILTER:**
CC1: **ETM1:** **CC2:** **ETM2:**
RECIRCULATION TANK: **DATE OF MANUFACTURE:**
CC1: **ETM1:** **CC2:** **ETM2:**
SEPTIC TANK ELEVATION: 6 **GREASE TRAP ELEVATION:** **DOSING PUMP TANK ELEVATION:**
RECIRCULATION TANK ELEVATION: **DISTRIBUTION DEVICE ELEVATION:** 7

INSTALLED TRENCH DEPTH	INSTALLED AGGREGATE DEPTH	INSTALLED TRENCH LENGTH	INSTALLED TRENCH BOTTOM ELEVATION
24	12	140	8.1
24	12	135	8.5
24	12	135	8.7

ACTUAL PRESSURE HEAD:

ACTUAL FLOW RATE:

ACTUAL DOSE VOLUME:


SPECIFIC OPERATION REQUIREMENTS:

ISSUED BY:



DATE: 09/19/2018

PLOT PLAN FOR
ROYAL OAKS BUILDING GROUP, LLC
 101 JEWELL FARM LANE
 LOT 36, BALLENTINE PLACE SUBDIVISION, PHASE 1
 TOWN OF HOLLY SPRINGS, WAKE COUNTY, NORTH CAROLINA
 101 Jewell Farm Lane 0647 23 6503

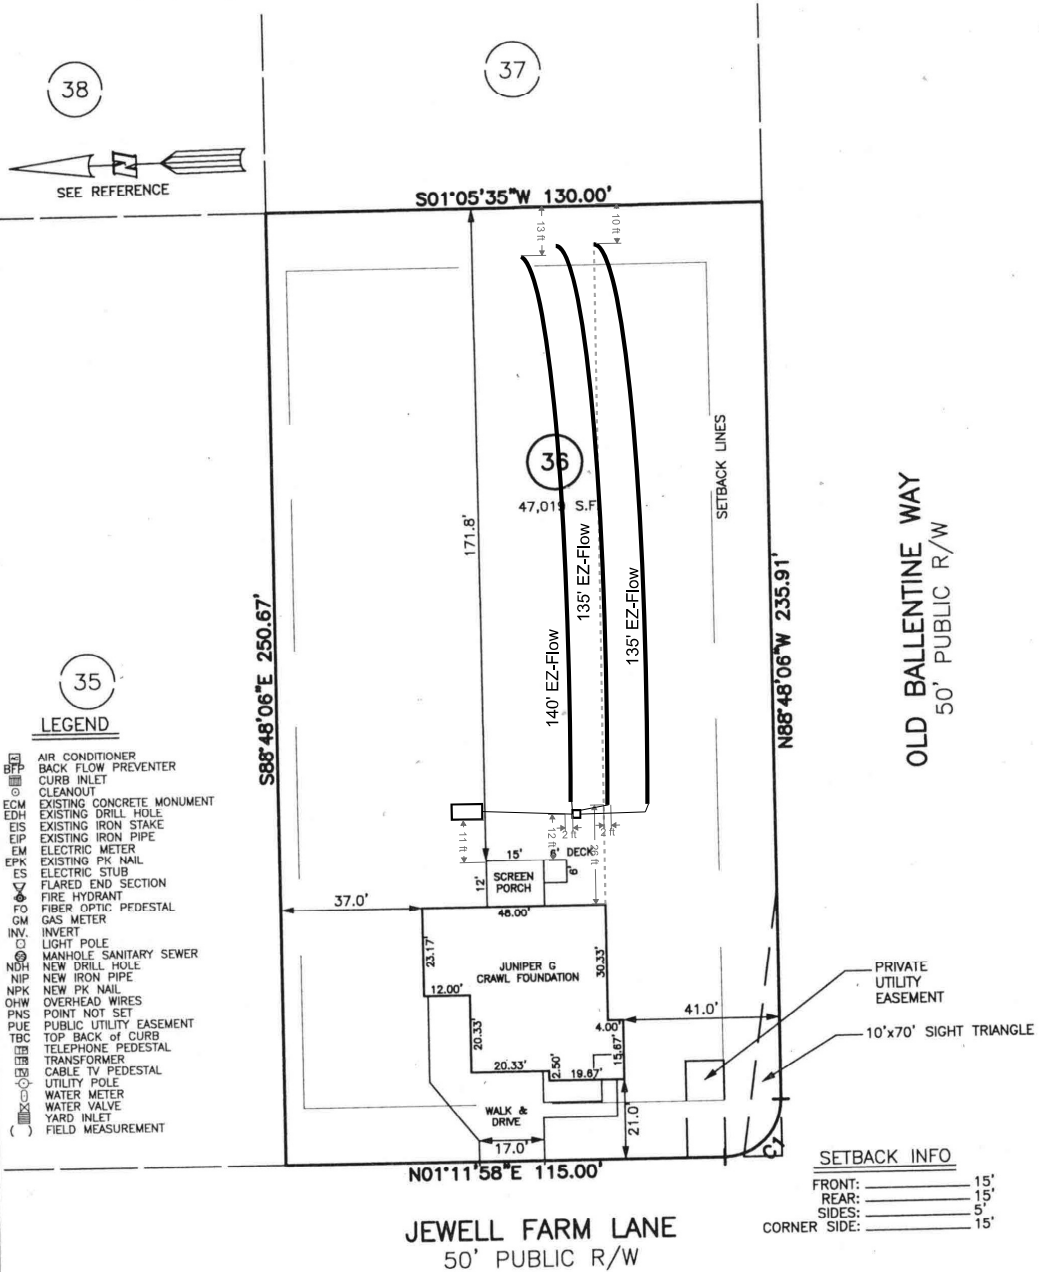

NUMBER	RADIUS'	DELTA	ARC'	CHORD BRG.	CHORD'
C1	15.00	90°00'04"	23.56	N43°48'04"W	21.21

NOTES

1. NOT FOR RECORDING IN MAP BOOKS.
2. THIS SURVEY SUBJECT TO ANY FACTS THAT MAY BE DISCLOSED BY A FULL AND ACCURATE TITLE SEARCH.
3. THIS MAP IS NOT A CERTIFIED SURVEY AND HAS NOT BEEN REVIEWED BY A LOCAL GOVERNMENT AGENCY FOR COMPLIANCE WITH ANY APPLICABLE LAND DEVELOPMENT REGULATIONS

PLOT PLAN
 PRELIMINARY PLAT- NOT FOR RECORDATION,
 CONVEYANCE OR SALES

REV CODE: 1.FLIP, 2.PLAN, 3.ROTATE, 4.MOVE, 5.SS
 6.SEVERAL OF ABOVE, 7.LAND FEATURE, 8. OTHER

DATE: APR. 11, 2018

F.B. _____

RWK, PA
ENGINEERING ~ SURVEYING
 CORPORATE LICENSE: C-1771
 101 W. MAIN ST., SUITE 202
 GARNER, NC 27529
 PHONE (919) 779-4854
 FAX (919) 779-4056
C:\BILTIN\BILTIN36.BILTIN36.DWG