


9/130

SIZE

THE ABOVE SIGNATURE INDICATES THAT I HAVE READ, UNDERSTAND, AND AGREE WITH ALL PROVISIONS AND INFORMATION AS OUTLINED ON THE BACK SIDE OF THIS FORM

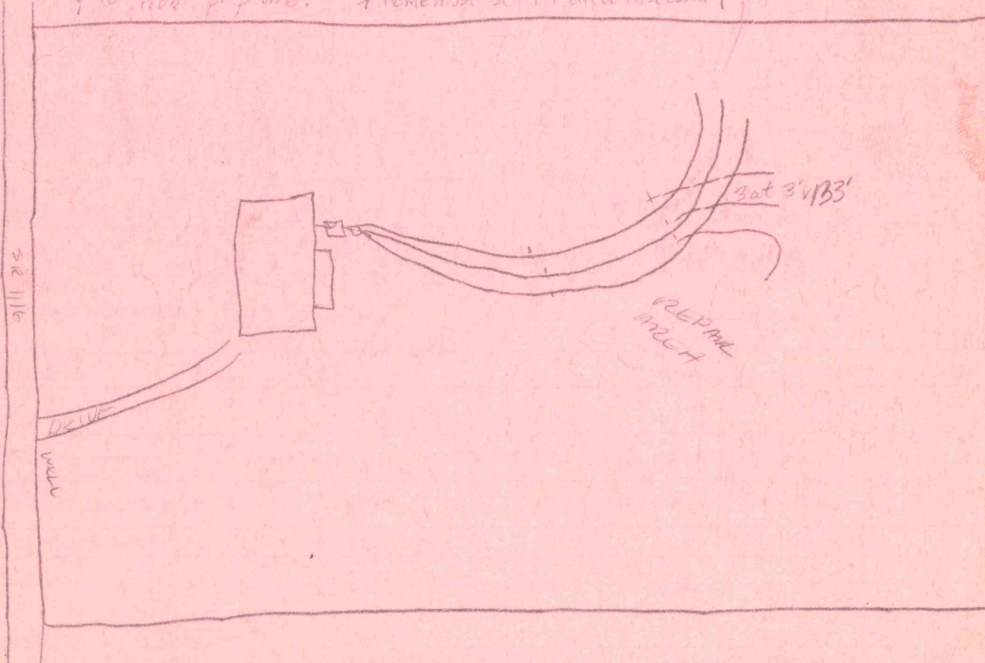

DATE ISSUED 3/2/92

EH SPECIALIST *Chris Harris*

DATE APPROVED 4/9/62

EH SPECIALIST *John P. Smith*