

Environmental Services - Water Quality
Onsite Wastewater Scan Data Entry Form

PERMIT #: **D 0 2 2 7 7 4**

PIN #: **0 6 5 7 0 3 5 7 9 5**

OP DATE: **0 3 / 0 7 / 2 0 0 2**

SYSTEM USE:

- ☒ House
☐ Mobile Home
☐ Business
☐ Other

SEWAGE TYPE:

- ☒ Domestic
☐ Industrial

PUMP/SIPHON?:

- ☐ Yes
☒ No

PRESSURE MANIFOLD:

- ☐ Yes
☒ No

SYSTEM TYPE:

- ☐ I
☒ II
☐ III
☐ IV
☐ V
☐ VI
☐ Other

SUB TYPE:

- ☐ A
☒ B
☐ C
☐ D
☐ E
☐ F
☐ G

NBR BEDROOMS:

- ☐ 1
☐ 2
☒ 3
☐ 4
☐ 5
☐ 6
☐ Other

MAINT. SCHEDULE:

- ☐ Yes
☒ No

CERT. OPERATOR

- ☐ Yes
☒ No

GT ST PT

- | | | | |
|-------------------------------------|-------------------------------------|-------------------------------------|------------------|
| ☐ | ☐ | | 750 |
| ☐ | ☐ | ☐ | 900 |
| ☐ | ☒ | ☐ | 1,000 |
| ☐ | ☐ | ☐ | 1,200 |
| ☐ | ☐ | ☐ | 1,500 |
| ☐ | ☐ | ☐ | 1,800 |
| ☐ | ☐ | ☐ | 2,100 |
| ☐ | ☐ | ☐ | 2,500 |
| ☐ | ☐ | ☐ | 3,000 |
| ☐ | ☐ | ☐ | 4,000 |
| ☐ | ☐ | ☐ | 5,000 |
| ☐ | ☐ | ☐ | 8,000 |
| ☐ | ☐ | ☐ | 10,000 |
| ☐ | ☐ | ☐ | Other |
| ☒ | | ☒ | None/NA GT or PT |

DRAINFIELD SIZE(SQ. FT.)

0 0 9 6 0

DRAIN TYPE:

- ☐ Stone
☒ EZ Flow
☐ Infiltrator
☐ Biodiffuser
☐ Cultec
☐ Drip
☐ Hancor
☐ Large Dia. Pipe
☐ Multi-Pipe
☐ Other

MAX DEPTH (IN.):

- ☐ 12 in. or less
☒ 18 in. or less
☐ 24 in. or less
☐ 26 in. or less
☐ 28 in. or less
☐ 30 in. or less
☐ 32 in. or less
☐ 36 in. or less
☐ Other

STONE DEPTH (IN.):

- ☐ 8 in. or less
☒ 12 in. or less
☐ 18 in. or less
☐ 24 in. or less
☐ Other

TRENCHES:

- ☒ Individual
☐ Bed

TRENCH WIDTH (IN.):

- ☐ 12 in. or less
☐ 18 in.
☐ 24 in.
☒ 36 in.
☐ 6 ft. or less
☐ 9 ft. or less
☐ Other

WAKE COUNTY DEPARTMENT OF ENVIRONMENTAL SERVICES WELL AND SEWAGE SITE LOCATION PERMIT
NO PERMIT(S) FOR CONSTRUCTION, LOCATION OR RELOCATION ACTIVITY SHALL BE ISSUED
UNTIL AN AUTHORIZATION FOR WASTEWATER SYSTEM CONSTRUCTION HAS BEEN ISSUED

PERMIT VOID IF NOT IN COMPLIANCE WITH ZONING REGULATIONS AND/ OR IF SITE IS ALTERED OR INTENDED USE CHANGED

PERMIT#: D022774 STATUS: A APP. DATE: 09/28/2001 BLDG. PERMIT#: 0021008
PIN: 0657.03 03 6592 000 TAX MAP: 0836 0004 RECORDED: Y ORIG. PERMIT#:
TOWNSHIP: 06 HOLLY SPRINGS JURISDICTION: WC ZONING: R30
APPLICANT: ANDERSON, BILLY
111 S. MAIN STREET
FUQUAY-VARINA, NC 27526
(919) 552 - 6914
USE: HD USE: 101 ONE-FAMILY HOUSE
EXIST USE:
DISPOSAL: N BEDROOMS: 3 BASEMENT: N #EMPLOYEES: 0
SITE: ADDRESS: 5616 MAGGIE RUN LN
SUBDIVISION: MAGGIE RUN LOT: 30 ACRES: 0.99
DIRECTION: HWY 55 S. THROUGH HOLLY SPRINGS TR WILBON RD
S/D ON RIGH JUST PAST OLD POWELL RD

Well System: WATER: INDIVIDUAL - TYPE: NEW

WELL LOG INFORMATION: DEPTH: 185 CASING DEPTH: 118 YIELD: 20 STATIC LEVEL: 120
WELLI CONTRACTOR: Reliance REG.# 1715 PUMP CONTRACTOR: Boundaries REG.# 1450
Construction Compliance GROUT APPROVED ☒ DATE: 3-7-02 EHS: Boundaries
WELLHEAD APPROVED ☒ DATE: 3-7-02 EHS: Boundaries
SYSTEM FINALIZED ☒ DATE: 5-30-02 EHS: Boundaries

COMMENTS:

Operation Permit

DESIGN FLOW: _____ gal./min. ACTUAL FLOW: _____ INNOVATIVE LETTER: _____

INSTALLED BY: Johnny Jones

INSTALLATION APPROVED BY: MTB

PROPRIETARY SYSTEM: _____

FILTER NO: _____

COMMENTS:

OPERATIONS PERMIT ISSUED? yes

OP DATE: 3-7-02

BY: MTB

This permit is based in part on information provided by the homeowner or his/her representative in the application submitted for this permit. The Environmental Health Specialist is not responsible for false or misleading information contained in the application. The Environmental Health Specialist is also not responsible for concealed conditions on the property or for statements in this report that may have resulted from false or misleading statements provided to him in the application. Neither Wake County nor the Environmental Health Specialist warrants that the septic tank system will continue to function satisfactorily in the future or that the water supply will remain potable.

BTS 103
12/4/01
1000 gall.

WAKE COUNTY DEPARTMENT OF ENVIRONMENTAL SERVICES WELL AND SEWAGE SITE LOCATION PERMIT

NO PERMIT(S) FOR CONSTRUCTION, LOCATION OR RELOCATION ACTIVITY SHALL BE ISSUED

UNTIL AN AUTHORIZATION FOR WASTEWATER SYSTEM CONSTRUCTION HAS BEEN ISSUED

PERMIT VOID IF NOT IN COMPLIANCE WITH ZONING REGULATIONS AND/ OR IF SITE IS ALTERED OR INTENDED USE CHANGED

PERMIT#: D022774 STATUS: A APP. DATE: 09/28/2001 BLDG. PERMIT#: 0021008
PIN: 0657.03 03 6592 000 TAX MAP: 0836 0004 RECORDED: Y ORIG. PERMIT#:
TOWNSHIP: 06 HOLLY SPRINGS JURISDICTION: WC ZONING: R30
APPLICANT: ANDERSON, BILLY
111 S. MAIN STREET
FUQUAY-VARINA, NC 27526
(919) 552 - 6914
USE: HD USE: 101 ONE-FAMILY HOUSE
EXIST USE:
DISPOSAL: N BEDROOMS: 3 BASEMENT: N #EMPLOYEES: 0 FOUND DRAIN: Y
SITE: ADDRESS: 5616 MAGGIE RUN LN
SUBDIVISION: MAGGIE RUN LOT: 30 ACRES: 0.99
DIRECTION: HWY 55 S. THROUGH HOLLY SPRINGS TR WILBON RD
S/D ON RIGH JUST PAST OLD POWELL RD

IMPROVEMENT PERMIT

TANK SIZE: 1000 gal. PUMP Tank: ____ gal. SQ FT: 960 STONE DEPTH: 12 in. MAX DEPTH LINE: 18 in.
WASTEWATER: INDIVIDUAL SEWAGE: DOMESTIC TYPE SYSTEM: II B PUMP: N P/M: N
DAILY FLOW: 360 gal/day DESIGN FEE REQ?: N PAID?: WATER: INDIVIDUAL

COMMENTS:

IP ISSUED? Y DATE: 10/16/2001 BY: (MTB) MTB PHONE#: 856-7433

AUTHORIZATION FOR WASTEWATER/WATER SYSTEM CONSTRUCTION

VOID SIXTY (60) MONTHS FROM DATE OF ISSUANCE

AUTHORIZATION CONDITIONS:

Contractors shall install system on contours, see attached site plan for wastewater system design and well location. No underground utilities, water lines or sprinkler systems may be located in the original system or repair areas. A septic tank filter with a riser for access is required. The wastewater system shall not be covered or placed into use until inspected by the Wake County Department of Environmental Services and an Operation Permit issued. **OTHER CONDITIONS:**

INSTALL LINES AS SHOWN WITHOUT STEP DOWNS. HOUSE MUST BE CONTAINED WITHIN GIVEN FOOTPRINT. DO NOT GRADE SYSTEM OR REPAIR AREA. DO NOT DRIVE ON SYSTEM OR REPAIR AREA. CALL PRIOR TO INSTALLATION WITH ANY QUESTIONS OR CHANGES.

TANK SIZE: 1000 gal. PUMP TANK: ____ gal. SQ FT: 960 STONE DEPTH: 12 in. MAX DEPTH LINE: 18 in.
MAINT: N OPER: N L/O: Y TRENCH#: 3 LENGTH: 120 ft. WIDTH: 36 in. DESIGNER: ____
SUBFIELDS: ____ DESIGN HEAD PRESSURE: ____ DESIGN FLOW: ____ gal/min DOSE VOLUME: ____ gal.

CA ISSUED? Y DATE: 10/16/2001 BY: (MTB) MTB PHONE#: 856-7433

Billy Anderson
Lot 30 Maggie Run

Calculations

Total Lot Size / 43,274 SF

11.337%


Proposed Impervious / 4,906 SF OR ~~Percent~~ of Total Area

House SQ. FT. = 2,500
Driveway SQ. FT. = 2,306
Walk SQ. FT. = 100

0021008
D-022774

.99 Ac.

3-120' (CAVE) lines
.18" max depth
1000 GALL TANK

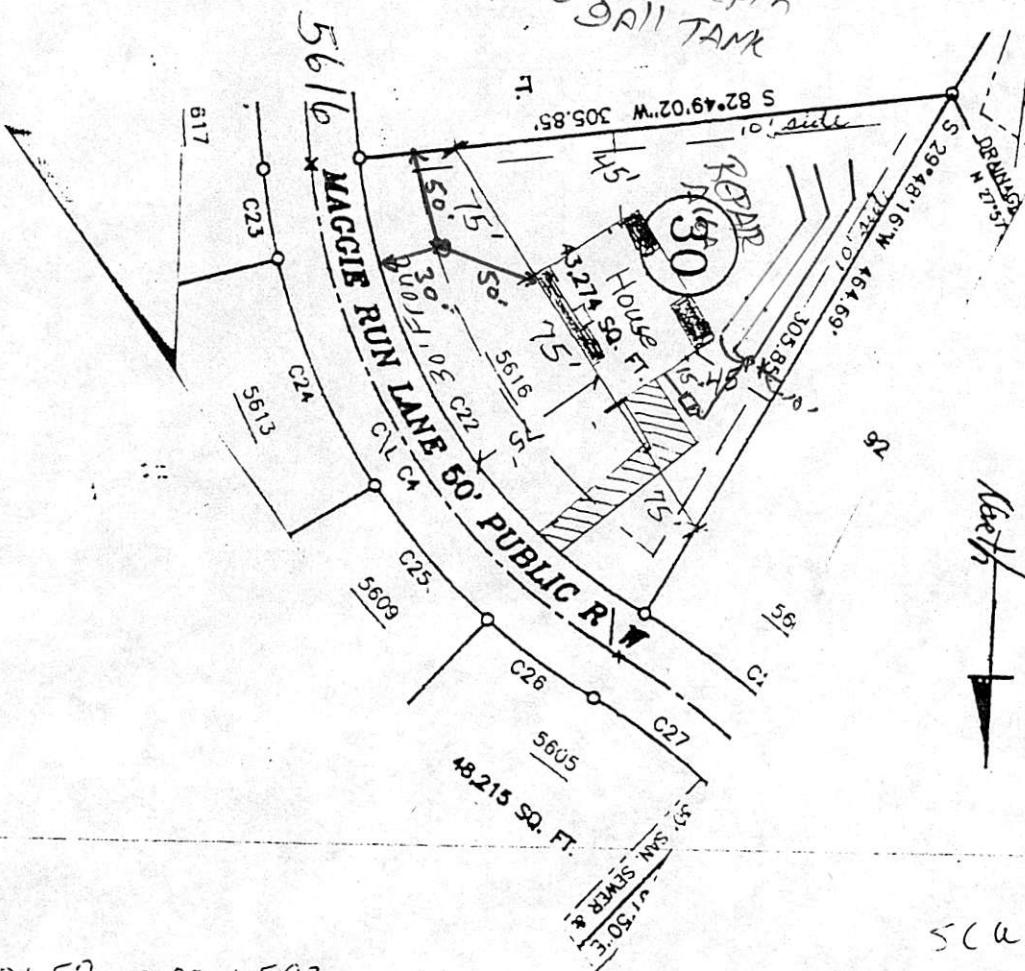

scale 1" = 100'

PIN: 0657, 03-03-6592

I certify that the location of planned or existing structure(s) are accurately shown. I understand failure to locate structures in accordance with this plot plan may require the relocation of structure(s) regardless degree of completion. I hereby grant permission to Municipal/County Representatives the right of entry to make evaluations or inspections on this property.

Billy Anderson
Signature of Owner or Authorized Agent

Approve R30 SBC
Date 10-1-01
Revise V Use 101
Reject MBL
Front 30' Rear 30'
Side 10' Corner 30'
Comments:

Billy Anderson
LOT 30 MAGGIE RUN

Calculations


Total Lot Size / 43,274 SF

11.337%

Proposed Improvements / 4,906 SF OR ~~Percent~~ of Total Area

House SQ. FT. = 2,500
DRIVEWAY SQ. FT. = 2,306
WALK SQ. FT. = 100

* Entire lot
is Area

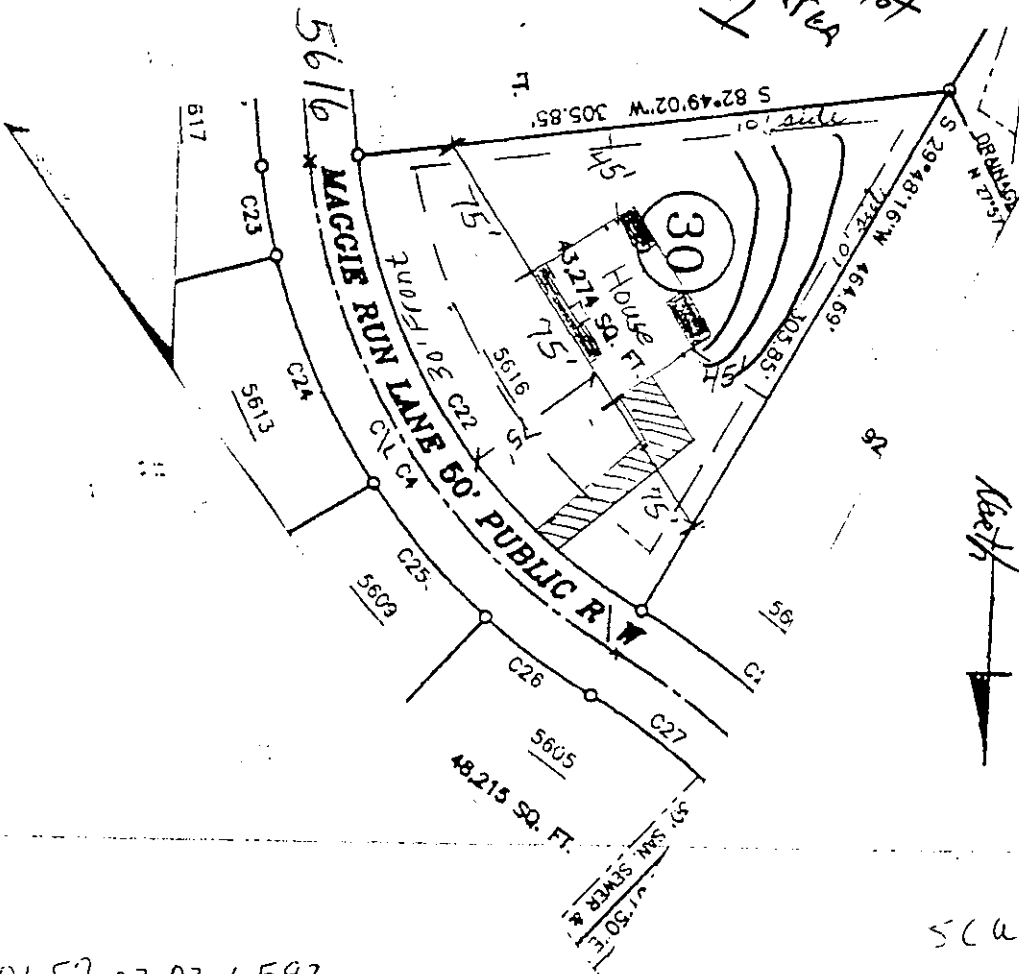

scale 1" = 100'

PIN: 0657, 03-03-6592

I certify that the location of planned or existing structure(s) are accurately shown. I understand failure to locate structures in accordance with this plot plan may require the relocation of structure(s) regardless degree of completion. I hereby grant permission to Municipal/County Representatives the right of entry to make evaluations or inspections on this property.

Billy Anderson
Signature of Owner or Authorized Agent

R30 SBC
V Date 10-1-01
Use 101
Select MBL
Front 30' Rear 30'
Side 10' Corner 30'
Comments: