


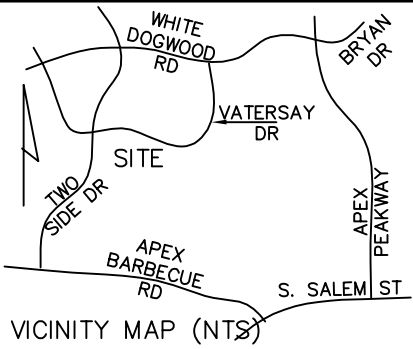


- LEGEND:**
- R/W = RIGHT OF WAY
 - C/L = CENTER LINE
 - EIP = EXISTING IRON PIPE
 - () = FIELD MEASUREMENTS
 - TOB = TOP OF BANK
 - [Symbol] = CABLE TV PEDESTAL
 - [Symbol] = CLEAN OUT (SEWER)
 - [Symbol] = TELECOM PEDESTAL
 - [Symbol] = ELECTRIC PEDESTAL
 - [Symbol] = FIRE HYDRANT
 - [Symbol] = MANHOLE
 - [Symbol] = WATER METER
 - CP = CALCULATED POINT
 - IPS = IRON PIPE SET

NOTES:

NOT FOR RECORDATION, CONVEYANCES, OR SALE.
PROPERTY SUBJECT TO ANY EASEMENTS OF RECORD.
TITLE SEARCH NOT PERFORMED BY THIS OFFICE.
FIELD CLOSURE > 1/10000.
THIS OFFICE MADE NO DETERMINATION WITH REGARDS TO
FLOOD, RIPARIAN/STREAM BUFFERS, AND/OR CONFORMANCE TO
ORDINANCES
PROPERTY IS IN THE JORDAN LAKE WATER SUPPLY WATERSHED.
PIN: 0732705111. PROPERTY IS ZONED MD-CU.

SETBACKS PER RECORDED PLAT:

FRONT	= 15'
REAR	= 20'
SIDE	= 5'
CORNER	= 10'
DETACHED GARAGE-SIDE	= 0'
DETACHED GARAGE-REAR	= 5'

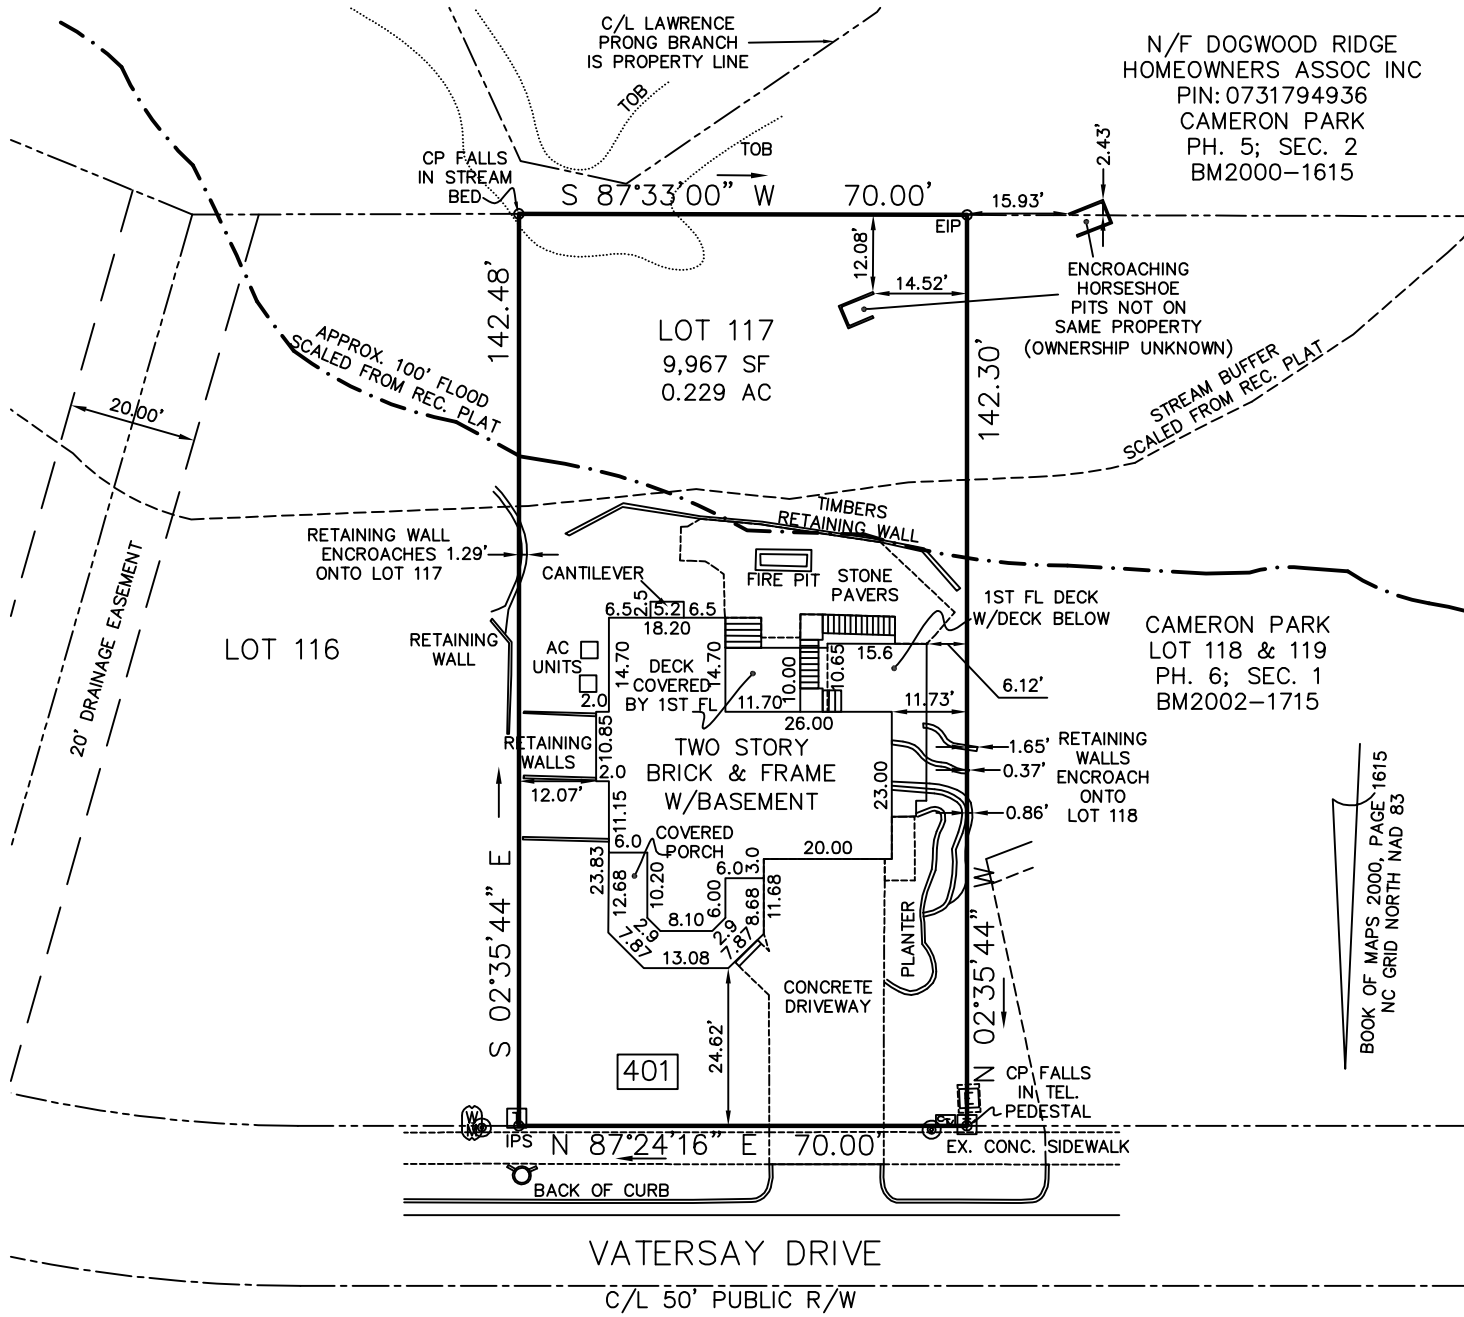

N/F DOGWOOD RIDGE
HOMEOWNERS ASSOC INC
PIN: 0731794936
CAMERON PARK
PH. 5; SEC. 2
BM2000-1615

CAMERON PARK
LOT 118 & 119
PH. 6; SEC. 1
BM2002-1715

BOOK OF MAPS 2000, PAGE 1615
NC GRID NORTH NAD 83

THIS PROPERTY IS NOT LOCATED IN AN AREA DESIGNATED AS HAVING SPECIAL FLOOD HAZARDS ACCORDING TO
FLOOD INSURANCE RATE MAP #3720073200 J . EFFECTIVE DATE: MAY 2, 2006.

LOT 117 BLOCK _____ SECTION 2
SUBDIVISION CAMERON PARK - PHASE 5
RECORDED IN BOOK OF MAPS 2000 PAGE 1615 WAKE COUNTY REGISTRY
AS-BUILT
SAW/MW
2020222

I, SONJA M. CARLEY, CERTIFY
THAT THIS MAP IS CORRECT, THAT
THE BUILDINGS ARE WHOLLY ON THE
LOT, AND THAT THERE ARE NO
ENCROACHMENTS OF OTHER BUILDINGS
ON THE SAID LOT, EXCEPT AS SHOWN
ON THIS SURVEY.

SONJA M. CARLEY
LAND SURVEYOR
L-4017

SURVEY FOR:
STEPHEN and MARNI CORLEY

WHITE OAK TOWNSHIP WAKE COUNTY NC

SCALE: 1"=30'

DATE: 09/21/2020

BOOK #: 314p15

WARD SURVEYING SERVICES, PLLC
LAND SURVEYING & PLANNING
APEX, N.C. (919) 367-7858