

PERMIT IS SUBJECT TO REVOCATION IF SITE PLANS OR INTENDED USE CHANGE

WARREN COUNTY HEALTH DEPARTMENT

ENVIRONMENTAL HEALTH DIVISION

544 WEST RIDGEWAY STREET

WARRENTON, NC 27589

PHONE (252) 257-1538

FAX (252) 257-4460

Permit No. 5967

Fee 150.00

Paid 12/18/06

Tax Parcel ID#

- ☒ Provisionally Suitable
☐ Pump system
☐ Repair of existing system
☐ Upgrade

Name of original owner _____
Year _____

IMPROVEMENT PERMIT

Owner TONY & Nikia Wortham Phone #: 432-8840 "Paul"
Address 124 Crinkley St. Warrenton NC 27589
Subdivision Name _____ Lot # _____ Block # _____ Section # _____
Directions to lot (RPR#) "Just off Old Macon Hwy."

Application Date 12/18/06

IMPROVEMENT PERMIT APPROVAL

Date 12/18/06 Andy Smith, RS
Environmental Health Specialist

— Improvement permit with scale drawing on plat is valid without expiration

— Improvement permit with site plan is valid for 60 months

CONSTRUCTION AUTHORIZATION

Original Deed Date _____ Land Use Residential # of bedrooms 4 # of people 4
Water Supply Private Well Distance from well and/or water lines Min. 50'/10'
Well installed at time of inspection () Yes (☒) No Dist. from septic system _____
Design daily flow of sewage 480 gals. Kitchen garbage grinder NO Other _____
Septic tank capacity 1000 gals. Nitrification field 1680 Sq. Ft.
Maximum trench depth 30 inches Type system Conv.
Type repair IN NOV.

CONSTRUCTION AUTHORIZATION APPROVAL

Date 12/19/06 Andy Smith, RS
Environmental Health Specialist

*CONSTRUCTION AUTHORIZATION IS VALID FOR 5 YEARS FROM DATE OF ISSUE

EXACT SYSTEM MAY Vary
Slightly!

COMMENTS: (1) RUN TRENCHES 3' WIDE AND AT LEAST 9' ON CENTERS
(2) RUN LINES CONTOUR TO SLOPE (3) RUN LINES OF EQUAL LENGTH
(4) EFFLUENT FILTER REQUIRED (5) TANK MARKERS/RISERS NECESSARY
(6) IF TANK LOCATION IS SPECIFIED ON SITE PLAN SEPTIC PERMIT-
HOUSE, MH OR STRUCTURE TO BE PLUMBED ACCORDINGLY. (7) INSTALL INITIAL SYSTEM IN DESIGNATED AREA

THE SEPTIC TANK SYSTEM AND OTHER IMPROVEMENTS THAT ARE MADE SHALL BE INSTALLED AS SHOWN IN THE SITE SKETCH PLAN. NO CHANGES SHALL BE MADE WITHOUT APPROVAL FROM THE HEALTH DEPARTMENT.

ANY VARIATIONS FROM THE CONDITIONS AND REQUIREMENTS PREVIOUSLY DESCRIBED WILL VOID THE PERMIT. THIS IS AN OFFICIAL DOCUMENT. PLEASE RETAIN WITH

OTHER VALUABLE PAPERS.

*DO NOT LANDSCAPE LOT BEFORE HEALTH DEPARTMENT APPROVAL. DO NOT LOCATE DRIVEWAYS, PARKING AREAS, OR OTHER BUILDINGS OVER SEPTIC TANK SYSTEM. LANDSCAPE AREA OVER SEPTIC TANK SYSTEM TO PREVENT PONDING OF WATER. SEED WITH GRASS TO HELP PREVENT SOIL EROSION AND TO IMPROVE EVAPOTRANSPIRATION.

OPERATION PERMIT

OPERATION PERMIT APPROVAL

DATE 2/21/07 Andy Smith, RS
ENVIRONMENTAL HEALTH SPECIALIST

CONTRACTOR: Cole's Backhoe Service

NOTE: THE SEPTIC TANK, AND NITRIFICATION FIELD MUST BE INSPECTED BY A REPRESENTATIVE OF THE HEALTH DEPARTMENT BEFORE THEY ARE COVERED.

THE SIGNING OF THIS CERTIFICATE SHALL INDICATE THAT THIS SYSTEM HAS BEEN INSTALLED IN COMPLIANCE WITH THE CURRENT LAW & RULES FOR SANITARY SEWAGE COLLECTION, TREATMENT AND DISPOSAL SET FORTH IN ARTICLE 11 OF GENERAL STATUTE 130A. SECTION. 1900 OF THE NORTH CAROLINA ADMINISTRATIVE CODE TITLE 10, HEALTH SERVICES. ENVIRONMENTAL HEALTH SUBCHAPTER 10A SANITATION AND SHALL IN NO WAY BE A GUARANTEE THAT THE SEPTIC TANK SYSTEM WILL FUNCTION SATISFACTORILY FOR ANY GIVEN PERIOD OF TIME.


WHITE - OWNER'S COPY - YELLOW - HEALTH DEPT. COPY - PINK - INSPECTION DEPT. COPY

SITE PLAN/SYSTEM LAYOUT

Applicant Tony Worham Subdivision/Lot# _____

Authorized State Agent Andy Smith, RS Date 12/19/06

System components represent approximate contours only. The contractor must flag the system prior to beginning the installation to insure that proper grade is maintained.

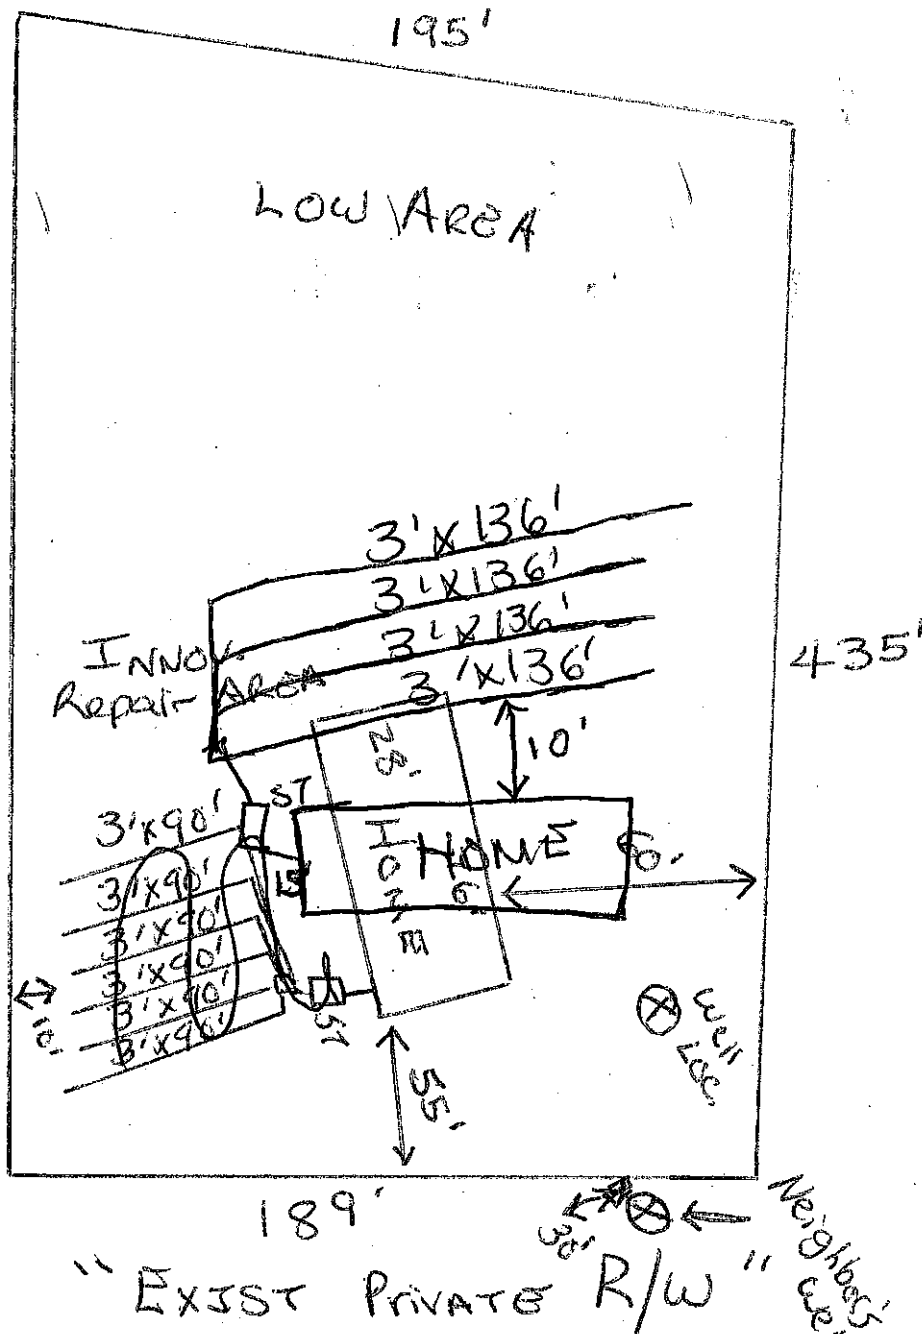

CONDITIONS OF THE PERMIT

Linear feet of conventional trench 540' Linear feet of 25% reduction trench _____ # of panels/bundles _____
 Maximum trench depth 30" SETBACKS: House foundation-5 ft; Basement-15ft; well- MIN 50ft
 Property line MIN 10ft; Stream/Lake-50ft; Gully-15ft; water pipe-10ft; Other _____
 Trenches on 9-ft centers, 3-ft wide, on contour, and installed in area shown.