

FRANKLIN COUNTY HEALTH DEPARTMENT

10.30

2000

PERMIT NUMBER: 77390 CONST IMPROVE PERMIT		DATE: 02.20.96	11201	SIZE: 2.26A
APPLICANT: DAVIDSON STEPHEN & STORM RT 3 BOX 430 LOUISBURG NC 27549		OWNER: DAVIDSON STEPHEN & STORM RT 3 BOX 430 LOUISBURG NC 27549		
TELEPHONE: 501-3189				
COMMENT: REPLACING SEPTIC SYSTEM Pearce				
LOCATION / DIRECTIONS: SR 1404 N 1/4 EAST OF SR 99 N 1/4 N 1/4 S 1/4				
FEE: 100.00 1475		SIGNATURE OR OWNER OR AUTHORIZED AGENT:		

THE ABOVE SIGNATURE INDICATES THAT I HAVE READ, UNDERSTAND, AND AGREE WITH ALL PROVISIONS AND INFORMATION AS OUTLINED ON THE BACK SIDE OF THIS FORM


TOPO <u>PS</u>	TEXTURE <u>S</u>	STRUCTURE <u>S</u>	DEPTH <u>PS</u>
R. HOR <u>PS</u>	SOIL. WET <u>PS</u>	AVAIL. SP <u>S</u>	OTHER <u>/</u>
MINRL <u>S</u>	OVERALL <u>PS</u>	LTAR <u>.4</u>	
#BEDRMS <u>3</u>	GPD <u>360</u>	DISPOSAL <u>/</u>	TYPE. SYS <u>C</u>
SZ. TANK <u>900</u>	SZ. CHAMB <u>/</u>	NITRIFI <u>3'x300'</u>	TYPE. WAT <u>P</u>
SITE. LOC <u>/</u>	MAX TRENCH DEP <u>30"</u>	TYP. FAC <u>SFD</u>	

REMARKS: STAY 50' FROM WELL AND 10' FROM PROPERTY LINES

* OLD SEPTIC TANK MUST BE PROPERLY ABANDONED (PUMPED, CRUSHED, AND FILLED)

ELLIS 900 12-11-95

INFILTRATOR INSTALLED WITH 25% REDUCTION = 225'x3'

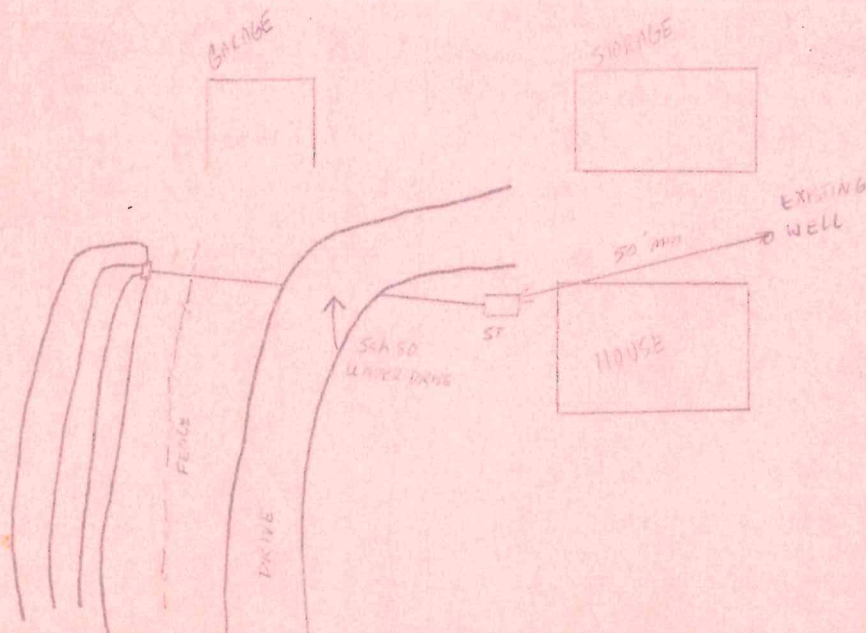

IMPROVEMENT PERMIT DATE: 2-20-96

ENV HEALTH SPEC: Glenn John

CONSTRUCTION AUTHORIZATION DATE: 2-20-96

ENV HEALTH SPEC: Glenn John

OPERATION PERMIT DATE: 3-4-96

ENV HEALTH SPEC: Glenn John

SEPTIC PERMIT APPLICATION
Franklin County Health Department
Phone 496-8100

TxREC# 11201
PIN#

SPermit# 0
BPermit# 6283
TMAP: 102 05 006

Township: Hayesville
Subdivision:
Prop.Address:

Zone: AR
Lot:
Lot Size: 2.26A
St.Road: 1404

Applicant: Davidson, Stephen & Storm
Address: Route 3, Box 430
C/S/Z: Louisburg, NC 27549
Phone: (919) 501-3189
SF/Building Permit: Y
Bedroom#: 3
Commercial: *NO*
Public Sewer: *NO*
Public Water: *NO*
Type Facility: *SFD*
SPermit \$: 100.00
Notes: pre-existing dwelling-replacing old
existing septic system

Owner: Davidson, Stephen & Storm
Address:
C/S/Z:
Mobile Home Permit:
Bath#: 1.0
Industrial:
Town:
Est.Daily Waste Flow: *360.5 gpd*
Date: 02/20/96 Rec#: 1475

ZONING PERMIT

Department of Planning & Development

Use of Property: pre-existing dwelling

Zoning District: AR

Setback Required: Front: 30

Rear: 25

Side: 10

B. W. Winstead

Zoning Administrator



I certify that all the statements made in this application and any attached documents are true, complete and correct to the best of my knowledge and belief and are made in good faith. I understand that false information may be grounds for rejection of this application. Authorized County representatives are granted right of entry to make evaluations or inspections and to release information upon public request.

Signature of Owner/Authorized Agent

Date


Stephen Davidson
Call the Health Department (496-8100) between 8:00 AM and 9:00 AM on Monday-Friday to schedule an appointment with an environmental health specialist to evaluate your lot. He/she will show you where to locate the well and septic system, in relation to the desired dwelling location and any property lines. If approved, an improvements permit will be issued. After the septic tank has been installed and approved, the Sanitarian will issue a certification of completion.

PER005B

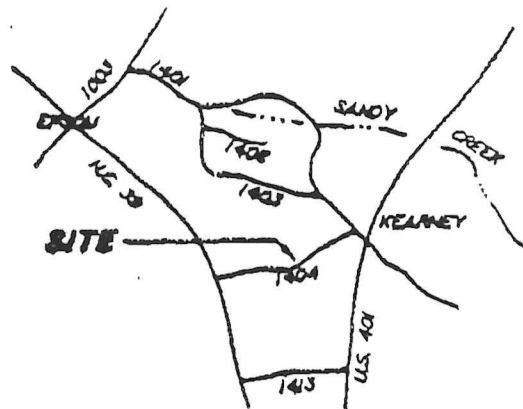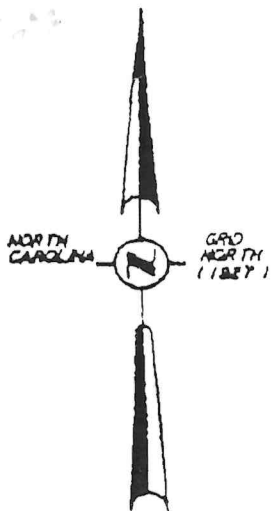

JOHN P. WILLIAMSON, Trustee
889-569

JOHN P. WILLIAMSON, Trustee
889-569

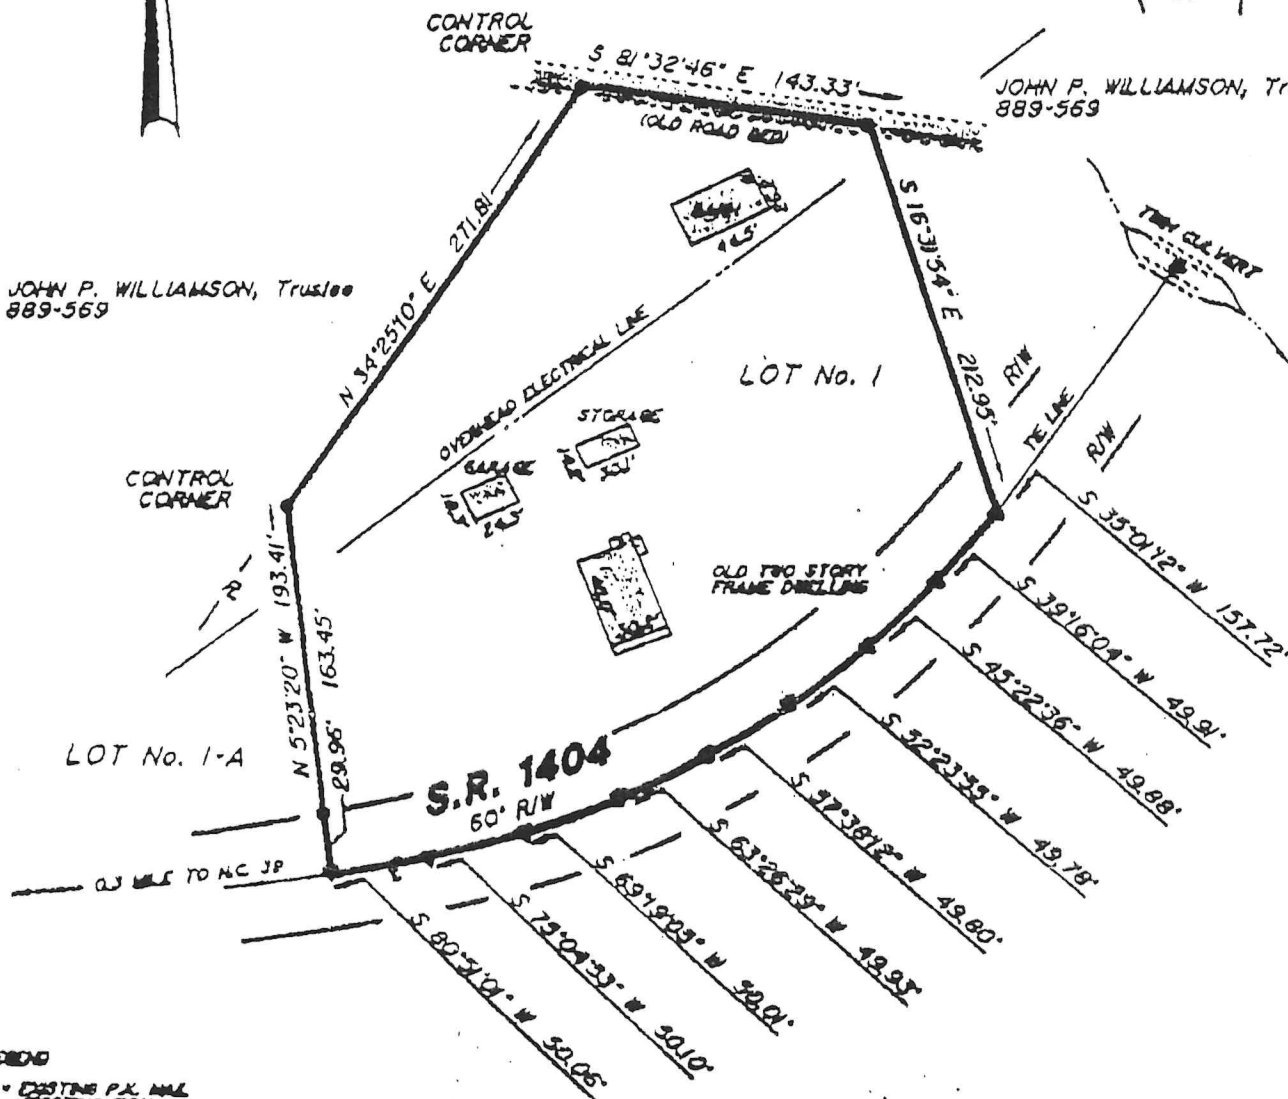

LEGEND

- EXISTING P.X. MARK
- EXISTING IRON

NOTE - THIS PROPERTY IS NOT LOCATED
IN A SPECIAL FLOOD HAZARD AREA

REFERENCE

- 1. PLAT RECORD FILE NO. 3, SLIDE 70-A
- 2. PLAT RECORD FILE NO. 3, SLIDE 11-C

AREA - 2.26 ACRES BY D.M.D.

STATE OF NORTH CAROLINA

COUNTY OF FRANKLIN

THE UNDERSIGNED CERTIFICATE OF BETTY M. WRENN, NOTARY PUBLIC, IS CERTIFIED TO BE CORRECT. THIS PLAT WAS PRESENTED FOR REGISTRATION IN THIS OFFICE THE _____ DAY OF _____, 19____, AT _____ O'CLOCK A.M.

REGISTER OF DEEDS.

I, MELVIN KEITH WRENN, CERTIFY THAT THIS PLAT WAS DRAWN UNDER MY SUPERVISION FROM AN ACTUAL SURVEY MADE UNDER MY SUPERVISION FROM DEED DESCRIPTION RECORDED IN BOOK 471, PAGE 817; THAT THE BOUNDARIES NOT SURVEYED ARE SHOWN AS BROKEN LINES PLOTTED FROM INFORMATION FOUND IN BOOK _____, PAGE _____; THAT THE RATIO OF PRECISION AS CALCULATED BY LATITUDES AND DEPARTURES IS 1: 60,000; THAT THIS PLAT WAS PREPARED IN ACCORDANCE WITH G.S. 41-12 AS AMENDED, WITH MY ORIGINAL SIGNATURE, REGISTRATION NUMBER AND SEAL THIS 23rd DAY OF MARCH, A.D. 19 99.

Melvin Keith Wrenn

SURVEYOR

L-2433

REGISTRATION NUMBER

NORTH CAROLINA, FRANKLIN COUNTY

I, A NOTARY PUBLIC OF THE COUNTY AND STATE AFORESAID, CERTIFY THAT M. KEITH WRENN, A REGISTERED LAND SURVEYOR, PERSONALLY APPEARED BEFORE ME THIS DAY AND ACKNOWLEDGED THE EXECUTION OF THE FOREGOING INSTRUMENT, WITH MY HAND AND OFFICIAL STAMP OR SEAL, THIS 23rd DAY OF MARCH, 19 99.

Betty M. Wrenn

NOTARY PUBLIC - MY COMMISSION EXPIRES PIPER

