

Environmental Services - Water Quality
Onsite Wastewater Scan Data Entry Form

PERMIT #: 0007846

PIN #: 0881961001

OP DATE: 0611611998

SYSTEM USE:

- ☒ House
☐ Mobile Home
☐ Business
☐ Other

SEWAGE TYPE:

- ☒ Domestic
☐ Industrial

PUMP/SIPHON?:

- ☐ Yes
☒ No

PRESSURE MANIFOLD:

- ☐ Yes
☒ No

SYSTEM TYPE:

- ☐ I
☒ II
☐ III
☐ IV
☐ V
☐ VI
☐ Other

SUB TYPE:

- ☒ A
☐ B
☐ C
☐ D
☐ E
☐ F
☐ G

NBR BEDROOMS:

- ☐ 1
☐ 2
☐ 3
☒ 4
☐ 5
☐ 6
☐ Other

MAINT. SCHEDULE:

- ☐ Yes
☒ No

CERT. OPERATOR

- ☐ Yes
☒ No

GT ST PT SIZE

- | | | | |
|-------------------------------------|-------------------------------------|-------------------------------------|------------------|
| ☐ | ☐ | | 750 |
| ☐ | ☐ | ☐ | 900 |
| ☐ | ☐ | ☐ | 1,000 |
| ☐ | ☒ | ☐ | 1,200 |
| ☐ | ☐ | ☐ | 1,500 |
| ☐ | ☐ | ☐ | 1,800 |
| ☐ | ☐ | ☐ | 2,100 |
| ☐ | ☐ | ☐ | 2,500 |
| ☐ | ☐ | ☐ | 3,000 |
| ☐ | ☐ | ☐ | 4,000 |
| ☐ | ☐ | ☐ | 5,000 |
| ☐ | ☐ | ☐ | 8,000 |
| ☐ | ☐ | ☐ | 10,000 |
| ☐ | ☐ | ☐ | Other |
| ☒ | | ☒ | None/NA GT or PT |

DRAINFIELD SIZE(SQ. FT.)

01440

DRAIN TYPE:

- ☒ Stone
☐ EZ Flow
☐ Infiltrator
☐ Biodiffuser
☐ Cultec
☐ Drip
☐ Hancor
☐ Large Dia. Pipe
☐ Multi-Pipe
☐ Other

MAX DEPTH (IN.):

- ☐ 12 in. or less
☐ 18 in. or less
☒ 24 in. or less
☐ 26 in. or less
☐ 28 in. or less
☐ 30 in. or less
☐ 32 in. or less
☐ 36 in. or less
☐ Other

STONE DEPTH (IN.):

- ☐ 8 in. or less
☒ 12 in. or less
☐ 18 in. or less
☐ 24 in. or less
☐ Other

TRENCHES:

- ☒ Individual
☐ Bed

TRENCH WIDTH (IN.):

- ☐ 12 in. or less
☐ 18 in.
☐ 24 in.
☒ 36 in.
☐ 6 ft. or less
☐ 9 ft. or less
☐ Other

DN

WAKE COUNTY ENVIRONMENTAL HEALTH WELL AND SEWAGE SITE LOCATION PERMIT

NO PERMIT(S) FOR CONSTRUCTION, LOCATION OR RELOCATION ACTIVITY SHALL BE ISSUED

UNTIL AN AUTHORIZATION FOR WASTEWATER SYSTEM CONSTRUCTION HAS BEEN ISSUED.

PERMIT VOID IF NOT IN COMPLIANCE WITH ZONING REGULATIONS AND/ OR IF SITE IS ALTERED OR INTENDED USE CHANGED

PERMIT#: D007846 STATUS: A APP DATE: 09/25/1997 BLDG PERMIT#: 0981029

APPLICANT: WRIGHT, MICHAEL BUILDER DAY PHONE: (919) 847 - 7653

ADDRESS: 5000 CELBRIDGE PL FAX#: (000) 000 - 0000

CITY: RALEIGH STATE: NC ZIP: 27613

OWNER: 27613RTNERS LLC DAY PHONE: (919) 999 - 9999

ADDRESS: 3620 RANLO DR FAX#: (000) 000 - 0000

CITY: RALEIGH STATE: NC ZIP: 27612

HD USE CD: 101 ONE-FAMILY HOUSE ORIG PERMIT#: REC?: Y

EXIST USE: TAX MAP#: 0185

BEDROOMS: 4 BSMT: N #EMPLOYEES: 0 WATER: C WASTEWATER: I GARB DISPOSAL: N

TOWNSHIP: 02 BARTON'S CREEK JURIS: WC ZON: 40W PIN: 0881.02 96 1001 000

SUBD#: S 000 000 00 SUBD NAME: LAKEFALL LOT-SEC: 23 ACRE: 1.15

IMPRV PRMT: ISSUED?: Y DATE: 10/09/1997 BY: ACP TYPE SYSTEM: II PUMP:

CNSTR AUTH: ISSUED?: Y DATE: 10/09/1997 BY: ACP DATE EXPIRED: 10/09/2002

RECEIPT#: 0020387 FEE: 145.00 OP DATE: BY:

WATR SAMPL: REQ?: APPROVED?: DATE: PROPRIETARY SYS:

ST#: 7413 MI: DIR: NAME: HEARTLAND DIR: TYP: DR

DIRECTIONS: 50 N TO L ON NC 98 HWY TO R INTO SUB GO TO HEAR

TLAND DR

IMPROVEMENT PERMIT

SIZE OF TANK 1200 ST PT GALS. TOTAL SQ. FT. 1440 DEPTH OF STONE 12 IN. MAX. DEPTH LINE 24 IN.

WASTEWATER: DOMESTIC ☒ INDUSTRIAL ☐I.P. ISSUED BY Andre C. Pierce, R.S.**AUTHORIZATION FOR WASTEWATER SYSTEM CONSTRUCTION**

VOID SIXTY (60) MONTHS FROM DATE OF ISSUANCE

AUTHORIZATION CONDITIONS

1. Wastewater system construction and installation must meet all conditions and specifications as set forth in the Improvement Permit and the attached site plan with system details. Construction and installation must also meet all requirements set forth in the "Regulations Governing Sanitary Sewage Collection, Treatment And Disposal In Wake County" and any other applicable rules and laws.
2. The wastewater system shall not be covered or placed into use until inspected by the Wake County Environmental Health Division and an Operation Permit issued.
3. Any alteration in site or soil conditions (including location of structures and appurtenances) or modification in use, design wastewater flow or wastewater characteristics as specified in the associated Improvement Permit and application, may void this authorization and associated permits.

OTHER CONDITIONS: Water and Sewer lines shall not cross each other. Keep minimum setbacks from the house and other features.SIZE OF TANK 1200 ST 4110198 PT GALS. TOTAL SQ. FT. 1440 DEPTH OF STONE 12 IN. MAX. DEPTH LINE 24 IN.

NUMBER OF TRENCHES 4 LENGTH OF TRENCHES 120 FT. WIDTH OF TRENCHES 3 FT.

Contractor To Follow Contours, See Attached Site Plan For Wastewater System Design And Well Location

C.A. ISSUED BY Andre C. Pierce, R.S. INSTALLED BY Brantley DATE 6/16/98

INSTALLATION APPROVED BY _____

WELL SYSTEM = PRIVATE ☐ SEMI-PUBLIC ☐ -//// NEW ☐ REPLACEMENT ☐

WELL LOG INFORMATION = DEPTH _____ CASING DEPTH _____ YIELD _____ STATIC LEVEL _____

WELL CONTRACTOR _____ REG.# _____ PUMP CONTRACTOR _____ REG.# _____

CONSTRUCTION COMPLIANCE = GROUT APPROVED _____ DATE _____ EHS _____

WCHD ID # _____ WELLHEAD APPROVED _____ DATE _____ EHS _____

NEGATIVE BACTERIOLOGICAL RESULTS _____ DATE _____ EHS _____

SYSTEM FINALIZED _____ DATE _____ EHS _____


COMMENTS: _____

This report is based in part on information provided by the homeowner or his/her representative in the application submitted for this permit. The Environmental Health Specialist is not responsible for false or misleading information contained in the application. The Environmental Health Specialist is also not responsible for concealed conditions on the property or for statements in this report that may have resulted from false or misleading statements provided to him in the application. Neither Wake County nor the Environmental Health Specialist warrants that the septic tank system will continue to function satisfactorily in the future or that the water supply will remain potable.

Zoning 40W By MT
 Approve _____ Date 9/25/97
 Revises _____
 Reject _____
 Front 30 Rear 30
 Side 15 Corner _____
 Comments:

I certify that the location of planned or existing structure(s) are accurately shown. I understand failure to locate structures in accordance with this plot plan may require the relocation of structure(s) regardless degree of completion. I hereby grant permission to Municipal/County Representatives the right of entry to make evaluations or inspections upon this property.


[Signature]
 Signature of Owner or Authorized Agent

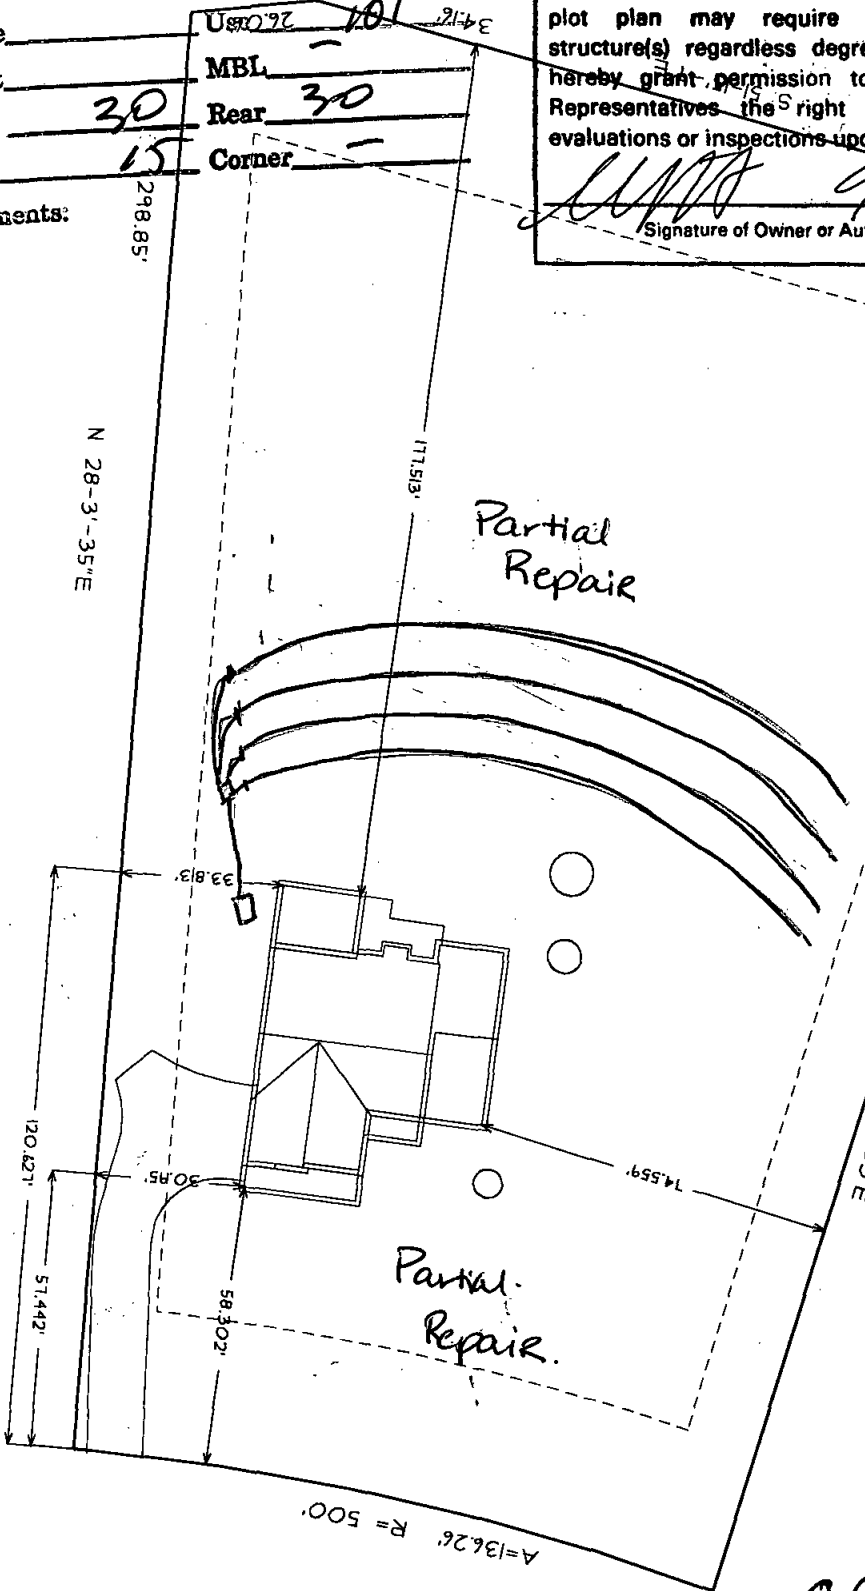

HAYNES & WELCH
 RESIDENTIAL DESIGN GROUP, L.L.C.
 6733 Falls of Neuse Road, Raleigh, NC 27615 919-847-8828

Michael Wright, Builder
 PARADE OF HOMES GRAND AWARD WINNER
 P.O. BOX 17575, RALEIGH, NC 27619
 919 - 847 - 7853

4-6%
 4(120x3)
 .33 gft
 Group 1A
 34'-36"
 CM > 36"

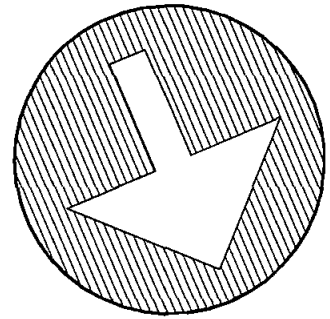

HEARTLAND DRIVE

0981029
 0-7846
 7413 HEARTLAND
 Dr.

LOT 23 LANDFALL SUBDIVISION
 7413 HEARTLAND DRIVE
 SCALE 1" = 40'