

Environmental Services - Water Quality
Onsite Wastewater Scan Data Entry Form

PERMIT #:

PIN #:

OP DATE:

SYSTEM USE:

- ☒ House
☐ Mobile Home
☐ Business
☐ Other

SEWAGE TYPE:

- ☒ Domestic
☐ Industrial

PUMP/SIPHON?:

- ☐ Yes
☒ No

PRESSURE MANIFOLD:

- ☐ Yes
☒ No

SYSTEM TYPE:

- ☐ I
☒ II
☐ III
☐ IV
☐ V
☐ VI
☐ Other

SUB TYPE:

- ☒ A
☐ B
☐ C
☐ D
☐ E
☐ F
☐ G

NBR BEDROOMS:

- ☐ 1
☐ 2
☒ 3
☐ 4
☐ 5
☐ 6
☐ Other

MAINT. SCHEDULE:

- ☐ Yes
☒ No

CERT. OPERATOR

- ☐ Yes
☒ No

GT ST PT SIZE

- | | | | |
|-------------------------------------|-------------------------------------|-------------------------------------|------------------|
| ☐ | ☐ | ☐ | 750 |
| ☐ | ☐ | ☐ | 900 |
| ☐ | ☒ | ☐ | 1,000 |
| ☐ | ☐ | ☐ | 1,200 |
| ☐ | ☐ | ☐ | 1,500 |
| ☐ | ☐ | ☐ | 1,800 |
| ☐ | ☐ | ☐ | 2,100 |
| ☐ | ☐ | ☐ | 2,500 |
| ☐ | ☐ | ☐ | 3,000 |
| ☐ | ☐ | ☐ | 4,000 |
| ☐ | ☐ | ☐ | 5,000 |
| ☐ | ☐ | ☐ | 8,000 |
| ☐ | ☐ | ☐ | 10,000 |
| ☐ | ☐ | ☐ | Other |
| ☒ | | ☒ | None/NA GT or PT |

DRAINFIELD SIZE(SQ. FT.)

DRAIN TYPE:

- ☒ Stone
☐ EZ Flow
☐ Infiltrator
☐ Biodiffuser
☐ Cultec
☐ Drip
☐ Hancor
☐ Large Dia. Pipe
☐ Multi-Pipe
☐ Other

MAX DEPTH (IN.):

- ☐ 12 in. or less
☐ 18 in. or less
☒ 24 in. or less
☐ 26 in. or less
☐ 28 in. or less
☐ 30 in. or less
☐ 32 in. or less
☐ 36 in. or less
☐ Other

STONE DEPTH (IN.):

- ☒ 8 in. or less
☒ 12 in. or less
☐ 18 in. or less
☐ 24 in. or less
☐ Other

TRENCHES:


- ☒ Individual
☐ Bed

TRENCH WIDTH (IN.):

- ☐ 12 in. or less
☐ 18 in.
☐ 24 in.
☒ 36 in.
☐ 6 ft. or less
☐ 9 ft. or less
☐ Other

SLP

As Built Copy

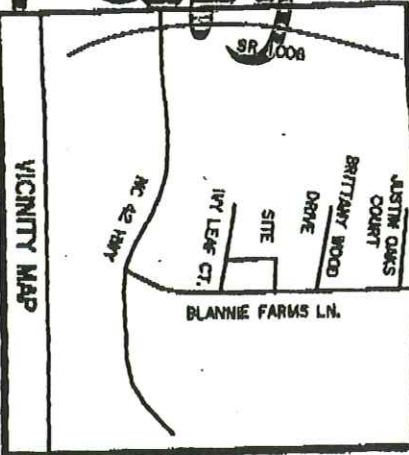

VICINITY MAP

LOT 10 OF BOM 2002, PG. 1906

LOT 9 OF BOM 2002, PG. 1906

PERCENTAGE OF LOT COVERED - 8%

IMPERVIOUS SURFACE COVERAGE:
 2250 SQ.FT. - HOUSE & GARAGE
 1135 SQ.FT. - DRIVEWAY
 75 SQ.FT. - WALK & STEPS
 3458 TOTAL SQ.FT. - PROPOSED COVERAGE

NOTE: BEING LOT 8 OF LEGACY AT FORTY TWO, CLUSTER UNIT DEVELOPMENT, RECORDED IN BOOK OF MAPS 2002, PG. 1905.

NOTE: AREA COMPUTED BY COORDINATE METHOD.

NOTE: RECORDED MAP HAS BEEN PREVIOUSLY TIED TO GRID.

NOTE: A 15' CONSTRUCTION EASEMENT SHALL BE RESERVED ON BOTH SIDES OF ALL PROPOSED STREETS.

NOTE: THIS PROPERTY IS SUBJECT TO EASEMENTS AND RESTRICTIONS OF RECORD.


There shall be no filling or the erection of permanent structure in the area of Wake County Flood Hazard Soils or Federal Emergency Management Agency (FEMA) 100 year flood zones until a flood study is approved by Wake County and/or FEMA.

Before acquiring a building permit for lots marked by an "M" (watermark) the builder may need to obtain a Flood Hazard Area Use Permit from Wake County Environmental Services. The builder's engineer, or architect and/or surveyor (as appropriate) must certify that all flood hazard requirements are met.

I, CLYDE E. PEARCE, hereby certify that under my direct supervision and control, I have caused to be made and recorded this plat of land, and that the same is a true and correct copy of the original as shown to me by the owner, and that the same is a true and correct copy of the original as shown to me by the owner, and that the same is a true and correct copy of the original as shown to me by the owner.

P. L. S. L-2481

WILLIAMS - PEARCE & ASSOC., P.A.
 P. O. BOX 892
 ZEBULON, N. C.
 PHONE: 269-9605

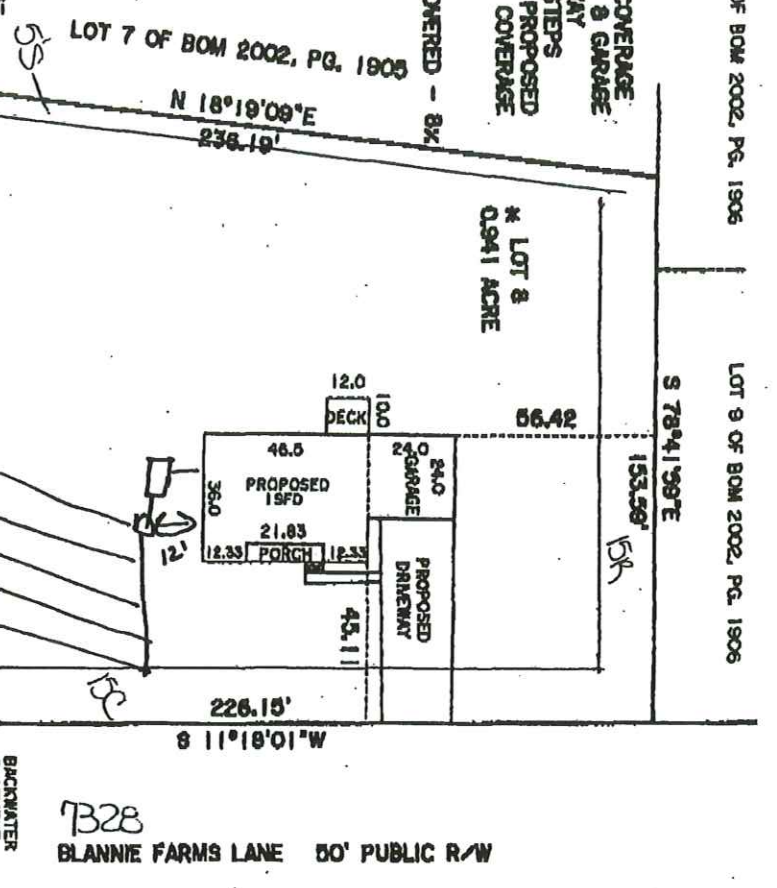

PRELIMINARY PLAT - NOT FOR CONVEYANCES, OR SALES.

ADOPTED BOM 2002, PG. 1906

NC GRID NORTH MAP

PLANNED DEVELOPMENT


COMFORT PLOT PLAN

PANTHER BRANCH WAKE COUNTY NORTH CAROLINA



DRAWN BY: CTP & E
CHECKED BY: CTP
DATE: 12-27-11
SCALE: 1" = 50'
JOB: CTP2578 CF
FB:

CA Site Plan

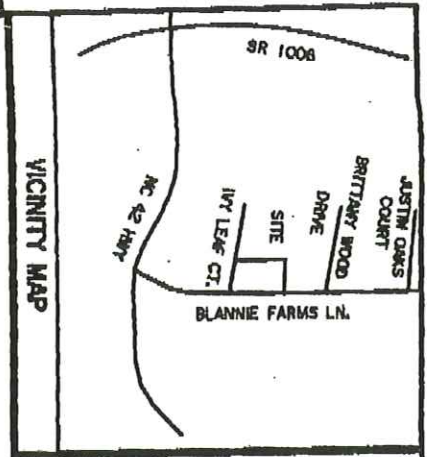

LOT 10 OF BOM 2002, PG. 1905

LOT 9 OF BOM 2002, PG. 1906

IMPERVIOUS SURFACE COVERAGE
2250 SQ. FT. - HOUSE & GARAGE
1133 SQ. FT. - DRIVEWAY
75 SQ. FT. - WALK & STEPS
3459 TOTAL SQ. FT. - PROPOSED COVERAGE

40999 SQ. FT. IN LOT

PERCENTAGE OF LOT COVERED - 8%

VICINITY MAP

NOTE: BEING LOT 8 OF LEGACY AT FORTY TWO, CLUSTER UNIT DEVELOPMENT, RECORDED IN BOOK OF MAPS 2002, PG. 1905.

NOTE: AREA COMPUTED BY COORDINATE METHOD.

NOTE: RECORDED MAP HAS BEEN PREVIOUSLY TIED TO GRID.

NOTE: A 15' CONSTRUCTION EASEMENT SHALL BE RESERVED ON BOTH SIDES OF ALL PROPOSED STREETS.

NOTE: THIS PROPERTY IS SUBJECT TO EASEMENTS AND RESTRICTIONS OF RECORD.

There shall be no filling or the erection of permanent structures in the area of Wake County Flood Hazard Soils or Federal Emergency Management Agency (FEMA) 100 year flood zones until a flood study is approved by Wake County and/or FEMA.

Before acquiring a building permit for lots marked by an 'M' (material) the builder may need to obtain a Flood Hazard Map Use Permit from Wake County Environmental Services. The builder's engineer, architect and/or surveyor (an appropriate professional) certifying that all flood hazard requirements are met.

L. DAVIS L. REYNOLDS, certifying that under my direction and supervision the work shown on this plan was done in accordance with the provisions of the North Carolina General Statutes and the rules and regulations of the State Board of Engineering and Surveying. My commission expires on 12-27-2012.


P. L. S. L-2481

WILLIAMS - PEARCE & ASSOC., P.A.

P. O. BOX 892

ZEBULON, N. C.

PHONE: 269-9605

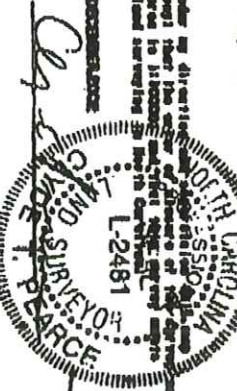

LOT 7 OF BOM 2002, PG. 1905

N 18°19'09"E
238.19'

* LOT 8
0.941 ACRE

06.42

S 78°41'39"E
153.58'

IVY LEAF COURT 30' PUBLIC R/W

N 72°34'39"W
153.67'

10' X 70' SIGN TRIANGLE


BACKWATER EASEMENT
ELEV. 318.81

B28

BLANNIE FARMS LANE 50' PUBLIC R/W

228.15'

S 11°18'01"W

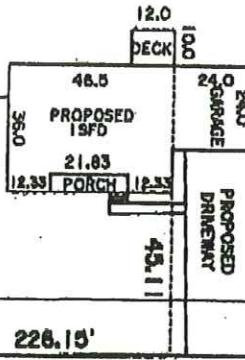

Lot 3
4x90x3'
1000 gallon ST.
max depth 24"

PRELIMINARY PLAN - NOT FOR CONVEYANCES, OR SALES.

47112 JSC



DRAWN BY: CTP & B
CHECKED BY: CTP
DATE: 12-27-2012
SCALE: 1" = 50'
JOB: CTP2578 CF
FB:

PLOT PLAN
COMFORT
PANTHER BRANCH
WAKE COUNTY
NORTH CAROLINA

