

Environmental Services - Water Quality
Onsite Wastewater Scan Data Entry Form

PERMIT #: **W A I 6 2 3 1**

PIN #: **0 7 8 9 7 1 8 8 8 9**

OP DATE: **0 8 / 3 0 / 2 0 1 7**

SYSTEM USE:

- ☒ House
☐ Mobile Home
☐ Business
☐ Other

SEWAGE TYPE:

- ☒ Domestic
☐ Industrial

PUMP/SIPHON?:

- ☐ Yes
☒ No

PRESSURE MANIFOLD:

- ☐ Yes
☒ No

SYSTEM TYPE:

- ☐ I
☒ II
☐ III
☐ IV
☐ V
☐ VI
☐ Other

SUB TYPE:

- ☒ A
☐ B
☐ C
☐ D
☐ E
☐ F
☐ G

NBR BEDROOMS:

- ☐ 1
☐ 2
☐ 3
☒ 4
☐ 5
☐ 6
☐ Other

MAINT. SCHEDULE:

- ☐ Yes
☒ No

CERT. OPERATOR

- ☐ Yes
☒ No

GT ST PT

- | | | | |
|-------------------------------------|-------------------------------------|-------------------------------------|------------------|
| ☐ | ☐ | | 750 |
| ☐ | ☐ | ☐ | 900 |
| ☐ | ☐ | ☐ | 1,000 |
| ☐ | ☒ | ☐ | 1,200 |
| ☐ | ☐ | ☐ | 1,500 |
| ☐ | ☐ | ☐ | 1,800 |
| ☐ | ☐ | ☐ | 2,100 |
| ☐ | ☐ | ☐ | 2,500 |
| ☐ | ☐ | ☐ | 3,000 |
| ☐ | ☐ | ☐ | 4,000 |
| ☐ | ☐ | ☐ | 5,000 |
| ☐ | ☐ | ☐ | 8,000 |
| ☐ | ☐ | ☐ | 10,000 |
| ☐ | ☐ | ☐ | Other |
| ☒ | | ☒ | None/NA GT or PT |

DRAINFIELD SIZE(SQ. FT.)

0 1 5 0 0

DRAIN TYPE:

- ☒ Stone
☐ EZ Flow
☐ Infiltrator
☐ Biodiffuser
☐ Cultec
☐ Drip
☐ Hancor
☐ Large Dia. Pipe
☐ Multi-Pipe
☐ Other

MAX DEPTH (IN.):

- ☐ 12 in. or less
☐ 18 in. or less
☒ 24 in. or less
☐ 26 in. or less
☐ 28 in. or less
☐ 30 in. or less
☐ 32 in. or less
☐ 36 in. or less
☐ Other

STONE DEPTH (IN.):

- ☐ 8 in. or less
☒ 12 in. or less
☐ 18 in. or less
☐ 24 in. or less
☐ Other

TRENCHES:

- ☒ Individual
☐ Bed

TRENCH WIDTH (IN.):

- ☐ 12 in. or less
☐ 18 in.
☐ 24 in.
☒ 36 in.
☐ 6 ft. or less
☐ 9 ft. or less
☐ Other

REVISED 5-25-2017
ADDED IMPERVIOUS AREAS FOR LOT
CONCRETE DRIVE AND WALKS-2872 SF±
DECK-199.2 SF±
HOUSE AND PORCH-1987 SF±

PLAT NORTH

BM 1986, PG 364

Zoning R 40W By CSP
Approve ☒ Date 8/29/17
Revise ☒ Use 434
Reject ☐ MBL 4341
Front 30 Rear 30
Side 15 Corner

Comments: Amend to add fire pit & trenching.

VICINITY MAP
(NOT TO SCALE)

-271-
986, PG 364

-273-
BM 1986, PG 364

I certify that the location of planned or existing structures are accurately shown. I understand failure to locate structures in accordance with this plot plan may require the relocation of structure(s) regardless degree of completion. I hereby grant permission to Municipal/County Representatives the right of entry to make evaluations or inspections upon this property.

Signature of Owner or Authorized Agent

-268-
BM 1986, PG 364

-274-
1.477 Acres
64,328 SF
BM 1986, PG 364

-26-
BM 1986, PG 364

-282-
BM 1987, PG 2051

-284-
BM 1987, PG 2051

ET ADDRESS:
10609 OLD PINE COURT
RALEIGH, NC 27613

GRAPHIC SCALE

0 30 60 120


AREA BY COORDINATE METHOD

I certify that this map was drawn under my supervision from an actual survey made under my supervision (deed description recorded in Deed Book 13838 Page 2276 or other referenced source BM 1986, PG 364) that the ratio of precision or positional accuracy is 1:1000. I further certify that this map meets the requirements of the STANDARD PRACTICE for LAND SURVEYING in North Carolina (N.C. NCAC 56. 1600) This 24th day of May 2017.

Jimmy C. Barbour, Professional Land Surveyor
North Carolina License Number 2854

DEED REFERENCE
DB 13838 PG 2276
PARCEL ID NO. 0151627
SURVEYED BY JS
FIELD BOOK 143
DATE 5-19-2017
DRAWN BY CM
SCALE 1"=60'
DWG NO. 17-149

CHRISTOPHER ALL
KAREN ALLEN
LOT 274
WOODVALLEY S/D SECTION 9
AS RECORDED IN BOOK OF MAPS 1986, PG 364
LEESVILLE TWP. WAKE CO. NC
JIMMY BARBOUR SURVEYING, PA
JIMMY C. BARBOUR, PLS, CSI
C-3109
213 South Second Street
P.O. BOX 26
SMITHFIELD, N.C. 27577
(919) 969-6542 PHONE (919) 969-6543 FAX

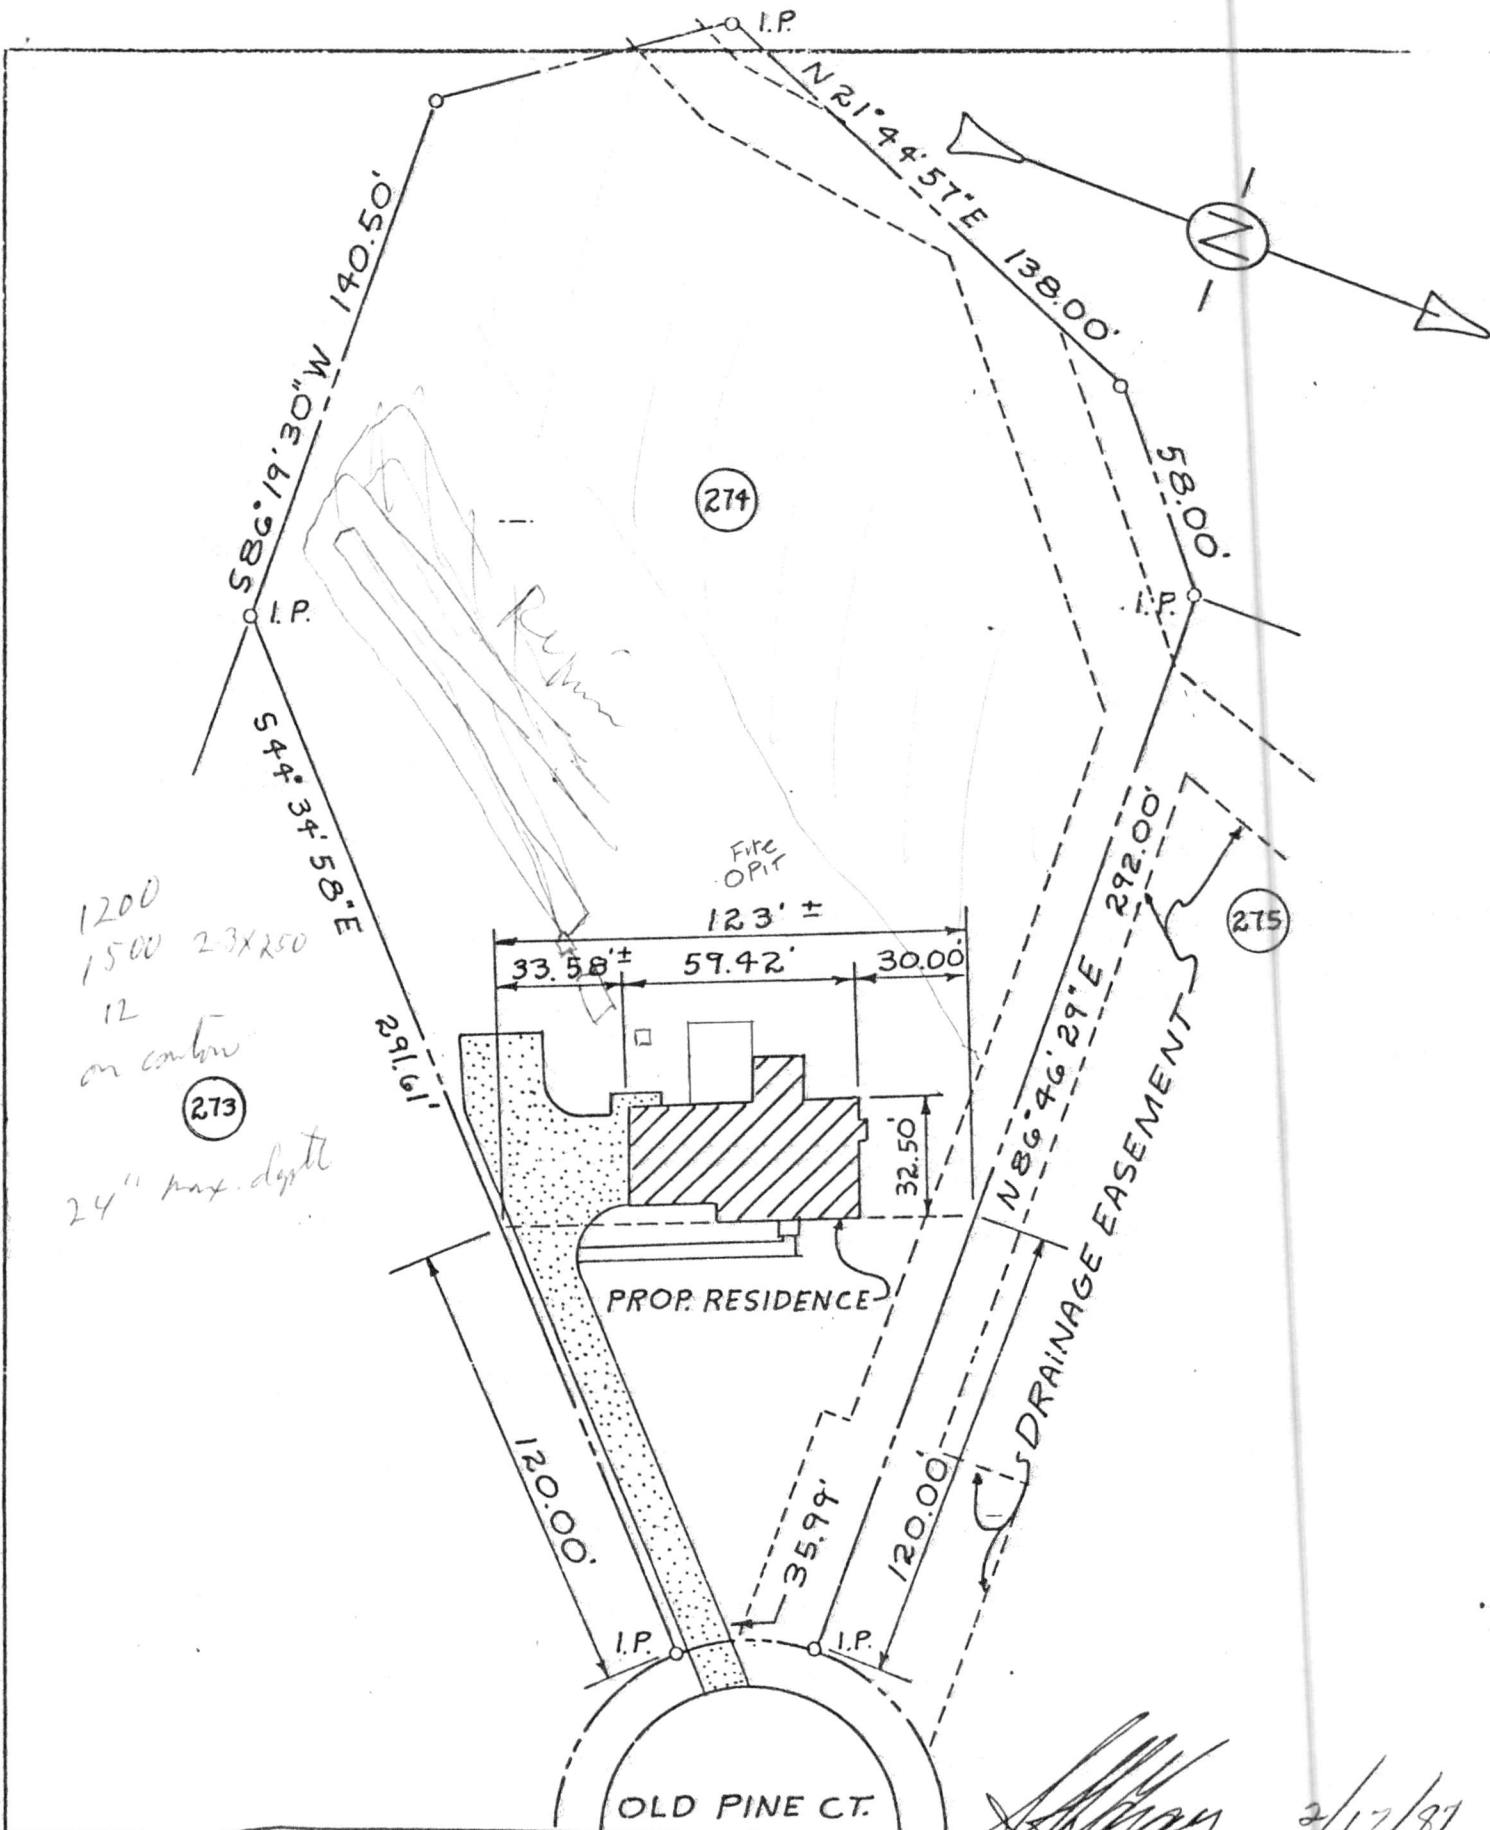

LOT NO. **STEVE GRAY BUILDER, INC**
COLLINS & GRAY BUILDERS
 5840 FARINGDON PLACE
 BOX 20022 RALEIGH, N.C.

LOT 274 WOODVALLEY
 SCALE: 1" = 50'-0"
 DATE: 2-16-87
 DRAWN BY: RLA

