

Environmental Services - Water Quality
Onsite Wastewater Scan Data Entry Form

PERMIT #: 0017636

PIN #: 1608719158

OP DATE: 0813011993

SYSTEM USE:

- ☒ House
☐ Mobile Home
☐ Business
☐ Other

SEWAGE TYPE:

- ☒ Domestic
☐ Industrial

PUMP/SIPHON?:

- ☐ Yes
☒ No

PRESSURE MANIFOLD:

- ☐ Yes
☒ No

SYSTEM TYPE:

- ☐ I
☒ II
☐ III
☐ IV
☐ V
☐ VI
☐ Other

SUB TYPE:

- ☒ A
☐ B
☐ C
☐ D
☐ E
☐ F
☐ G

NBR BEDROOMS:

- ☐ 1
☐ 2
☒ 3
☐ 4
☐ 5
☐ 6
☐ Other

MAINT. SCHEDULE:

- ☐ Yes
☒ No

CERT. OPERATOR

- ☐ Yes
☒ No

GT	ST	PT	SIZE
☐	☐	☐	750
☐	☐	☐	900
☐	☒	☐	1,000
☐	☐	☐	1,200
☐	☐	☐	1,500
☐	☐	☐	1,800
☐	☐	☐	2,100
☐	☐	☐	2,500
☐	☐	☐	3,000
☐	☐	☐	4,000
☐	☐	☐	5,000
☐	☐	☐	8,000
☐	☐	☐	10,000
☐	☐	☐	Other
☒		☒	None/NA GT or PT

DRAINFIELD SIZE(SQ. FT.)

01000

DRAIN TYPE:

- ☒ Stone
☐ EZ Flow
☐ Infiltrator
☐ Biodiffuser
☐ Cultec
☐ Drip
☐ Hancor
☐ Large Dia. Pipe
☐ Multi-Pipe
☐ Other

MAX DEPTH (IN.):

- ☐ 12 in. or less
☐ 18 in. or less
☐ 24 in. or less
☐ 26 in. or less
☒ 28 in. or less
☐ 30 in. or less
☐ 32 in. or less
☐ 36 in. or less
☐ Other

STONE DEPTH (IN.):

- ☐ 8 in. or less
☒ 12 in. or less
☐ 18 in. or less
☐ 24 in. or less
☐ Other

TRENCHES:

- ☒ Individual
☐ Bed

TRENCH WIDTH (IN.):

- ☐ 12 in. or less
☐ 18 in.
☐ 24 in.
☒ 36 in.
☐ 6 ft. or less
☐ 9 ft. or less
☐ Other

1608 71 9158

WAKE COUNTY HEALTH DEPARTMENT WELL AND SEWAGE SITE, LOCATION PERMIT

ALL PERMITS VOID 60 MONTHS FROM DATE OF ISSUANCE

2:00

Tax Map No. 808 Parcel No. 191Zoning R-30W Township Panther BranchOwner/Contractor: Roland Dodson IIILocation/Address: 908 Windrow LN.



Improvement Permit

Well Permit No. **C** 17636

Operation Permit []

Date: 3/17/93S.R. # 2727Subdivision Name: Keeland TrailsLot No. 21

Section or Block No. _____

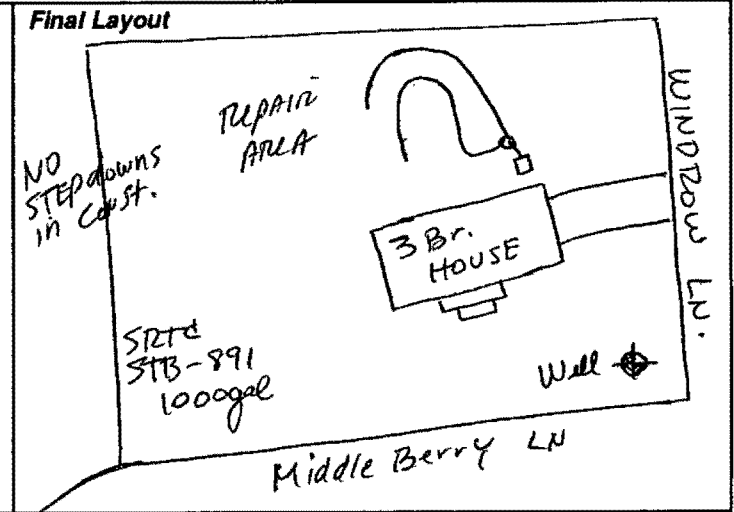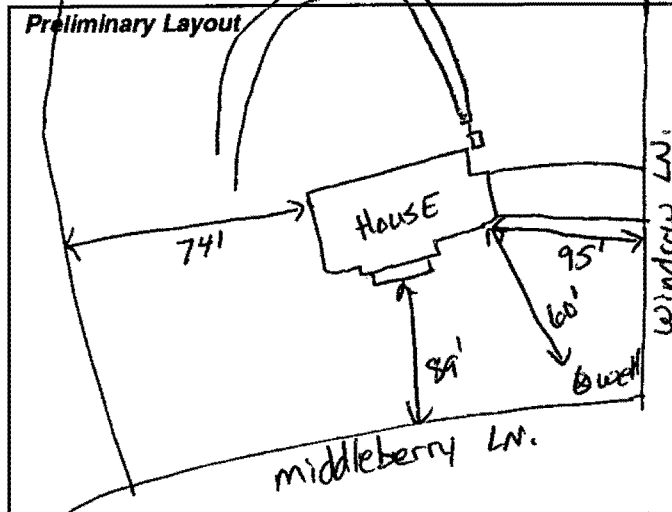

Sewage System Specifications

Repair [] Original Permit No. _____

Garbage Disposal Unit Yes [] No [✓]

House [✓] Mobile Home [] Business []

No. of Bedrooms 3 Lot Area 1.83 AcreSize of Tank 1000 gal.

Comments: _____

Nitrification Line (2) 167' x 3' 1000 sq. ft.Depth of Stone: 12" [✓] Max Depth of Trenches: 28 in.

Riser and Baffle Required [✓] Pump Required []

• Permit void if not in compliance with zoning regulations

• Permits may be voided if site is altered or intended use changed

Layout by: H. B. PhillipsDate: 6-3-93 Installed By: Don WilsonApproved By: Vincent Manzini RS

Well System

Individual [✓] Semi-Public [] Public []

New [✓] Replacement [] Repair []

Fee Paid: Yes [✓] No []

Construction Compliance Yes [✓] No []

Site Approved [✓] []

Well Head Approved [✓] []

Grouting Approved [✓] []

Date Inspected 5/18/93Sanitarian [Signature]

Bacteriological Results

Initial Sample: pos Date: 8/24/93* Re-Sample #1 pos Date: 8/27/93* Re-Sample #2 pos Date: _____

* Re-chlorination as required [] Yes [] No

* Fees for all resamples

All checks payable to: **Wake County Health Department**

Final Inspection

Yes No

Required Slab [✓] []

Chlorinated [✓] []

Required Certificate [] []

Variance (Explain) [] [✓]

WCHD I.D. Affixed 3806 [✓] []

Sample Collected [✓] []

Comments: _____

Well Installed By: Grady PacyDate System Finalized 8/30/93Sanitarian [Signature]

This report is based in part on information provided by the homeowner or his/her representative in the application submitted for this permit. The sanitarian is not responsible for false or misleading information contained in the application. The sanitarian is also not responsible for concealed conditions on the property or for statements in this report that may have resulted from false or misleading statements provided to him in the application. Neither Wake County nor the sanitarian warrants that the septic tank system will continue to function satisfactorily in the future or that the water supply will remain potable.

COPY TO HEALTH DEPARTMENT

3002.017 — 3/31/92