

Environmental Services - Water Quality
Onsite Wastewater Scan Data Entry Form

PERMIT #: 3028414

PIN #: 0799350122

OP DATE: 06/26/1985

SYSTEM USE:

- ☒ House
☐ Mobile Home
☐ Business
☐ Other

SEWAGE TYPE:

- ☒ Domestic
☐ Industrial

PUMP/SIPHON?:

- ☐ Yes
☒ No

PRESSURE MANIFOLD:

- ☐ Yes
☒ No

SYSTEM TYPE:

- ☐ I
☒ II
☐ III
☐ IV
☐ V
☐ VI
☐ Other

SUB TYPE:

- ☒ A
☐ B
☐ C
☐ D
☐ E
☐ F
☐ G

NBR BEDROOMS:

- ☐ 1
☐ 2
☐ 3
☒ 4
☐ 5
☐ 6
☐ Other

MAINT. SCHEDULE:

- ☐ Yes
☒ No

CERT. OPERATOR

- ☐ Yes
☒ No

GT ST PT

- | | | | |
|-------------------------------------|-------------------------------------|-------------------------------------|------------------|
| ☐ | ☐ | ☐ | 750 |
| ☐ | ☐ | ☐ | 900 |
| ☐ | ☐ | ☐ | 1,000 |
| ☐ | ☒ | ☐ | 1,200 |
| ☐ | ☐ | ☐ | 1,500 |
| ☐ | ☐ | ☐ | 1,800 |
| ☐ | ☐ | ☐ | 2,100 |
| ☐ | ☐ | ☐ | 2,500 |
| ☐ | ☐ | ☐ | 3,000 |
| ☐ | ☐ | ☐ | 4,000 |
| ☐ | ☐ | ☐ | 5,000 |
| ☐ | ☐ | ☐ | 8,000 |
| ☐ | ☐ | ☐ | 10,000 |
| ☐ | ☐ | ☐ | Other |
| ☒ | | ☒ | None/NA GT or PT |

DRAINFIELD SIZE(SQ. FT.)

01200

include permit
w-12065
w-12066

DRAIN TYPE:

- ☒ Stone
☐ EZ Flow
☐ Infiltrator
☐ Biodiffuser
☐ Cultec
☐ Drip
☐ Hancor
☐ Large Dia. Pipe
☐ Multi-Pipe
☐ Other

MAX DEPTH (IN.):

- ☐ 12 in. or less
☐ 18 in. or less
☐ 24 in. or less
☐ 26 in. or less
☐ 28 in. or less
☐ 30 in. or less
☐ 32 in. or less
☐ 36 in. or less
☒ Other

STONE DEPTH (IN.):

- ☐ 8 in. or less
☒ 12 in. or less
☐ 18 in. or less
☐ 24 in. or less
☐ Other

TRENCHES:

- ☒ Individual
☐ Bed

TRENCH WIDTH (IN.):

- ☐ 12 in. or less
☐ 18 in.
☐ 24 in.
☒ 36 in.
☐ 6 ft. or less
☐ 9 ft. or less
☐ Other

WAKE COUNTY HEALTH DEPARTMENT SEPTIC TANK LAYOUT AND PERMIT

TAX MAP NO. 240 PARCEL NO. 7(5)

PERMIT NO. B

28414

CONTRACTOR

Stuart Construction

OWNER

DATE

11-7-84

LOCATION

Vestry Way

S. R. NO.

1834

SUBDIVISION NAME

Byrum Woods - North

LOT NO.

22

SECTION OR BLOCK NO.

II

REPAIR ☐ ORIGINAL PERMIT NO. _____

GARBAGE DISPOSAL UNIT YES ☐ NO ☒

HOUSE ☒ MOBILE HOME ☐ BUSINESS ☐

NO. BEDROOMS 4 LOT AREA 40,000+

SIZE OF TANK _____ gal.

NITRIFICATION LINE 2 (200x3') lines 1200 sq. ft.

DEPTH OF STONE IN LINES: 12" ☒


RISER AND BAFFLE REQUIRED ☒ PUMP REQUIRED ☐

WATER SUPPLY: INDIVIDUAL ☐ PUBLIC ☒ OTHER ☐

- * PERMIT VOID 36 MONTHS FROM DATE OF ISSUANCE.
- * PERMIT VOID IF NOT IN COMPLIANCE WITH ZONING REGULATIONS
- * PERMIT MAY BE VOIDED IF SITE ALTERATIONS MADE

LAYOUT BY

Michael S. Bennett

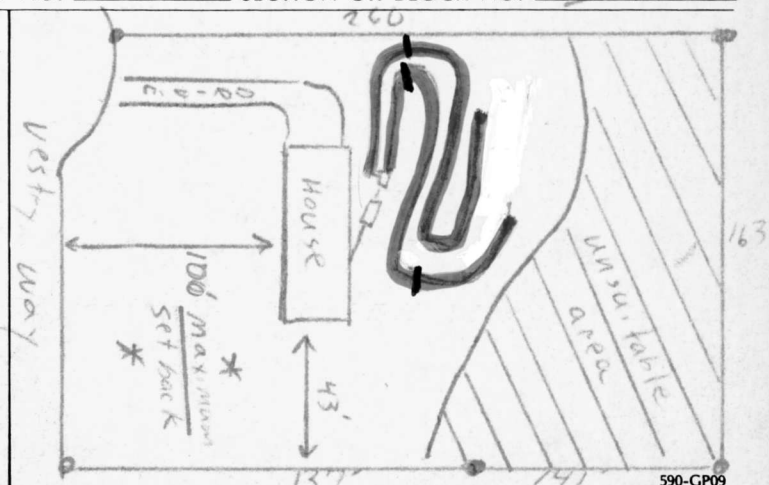

DATE

6-26-85

INSTALLED BY


Woody Wilson

APPROVED BY

Michael S. Bennett

GREG,

FOUR FLAGS MARK THE
CORNER OF THE HOUSE.
I MIGHT PUT A $\frac{1}{2}$ bH
IN THE $\frac{1}{2}$ BASEMENT.
(BASEMENT WOULD BE
ON THE RIGHT $\frac{1}{2}$ OF HSE.)
WOULD THIS POSE A
PROBLEM? I WOULD
LIKE TO AVOID A
LIFT PUMP. S

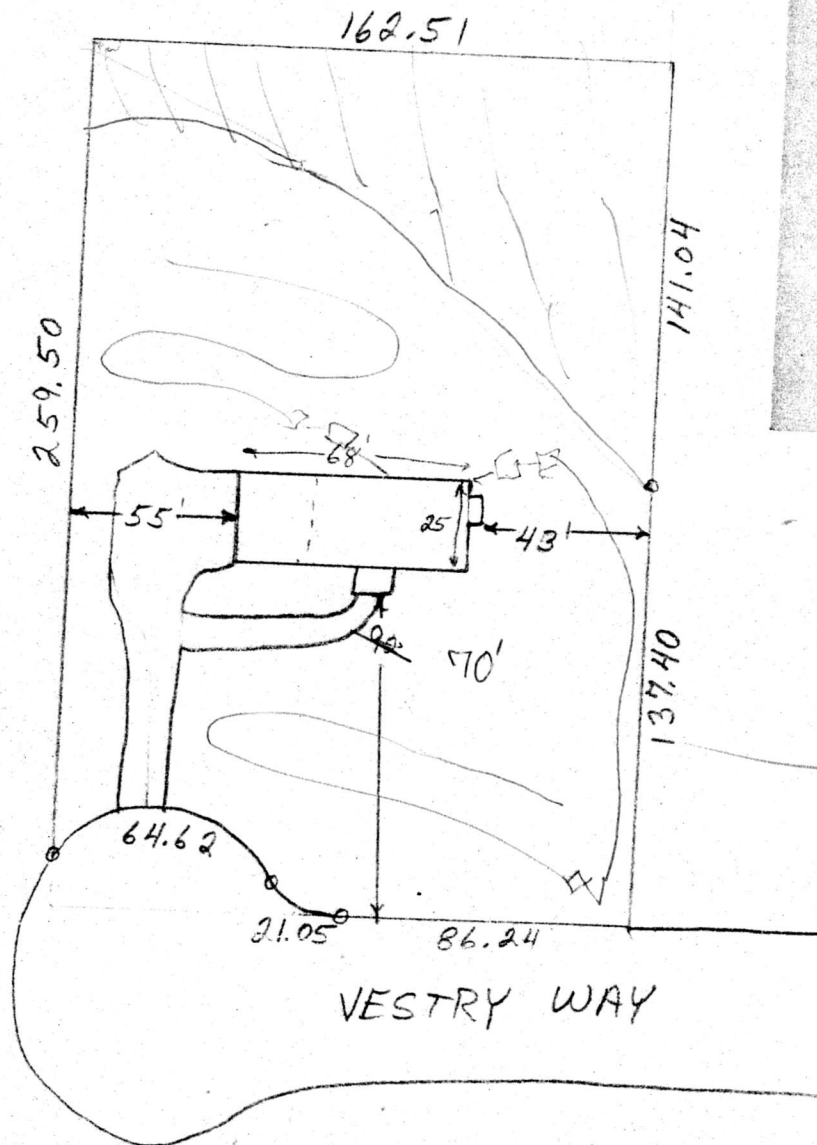


STUART
CONSTRUCTION CO., INC.
OF RALEIGH
■ GENERAL CONTRACTORS ■


Stuart M. Jones

LOT 22 BYRUM WOODS

202 W. Millbrook Rd. Raleigh, NC 27609 (919) 848-4896 (O)
782-5651 (H)

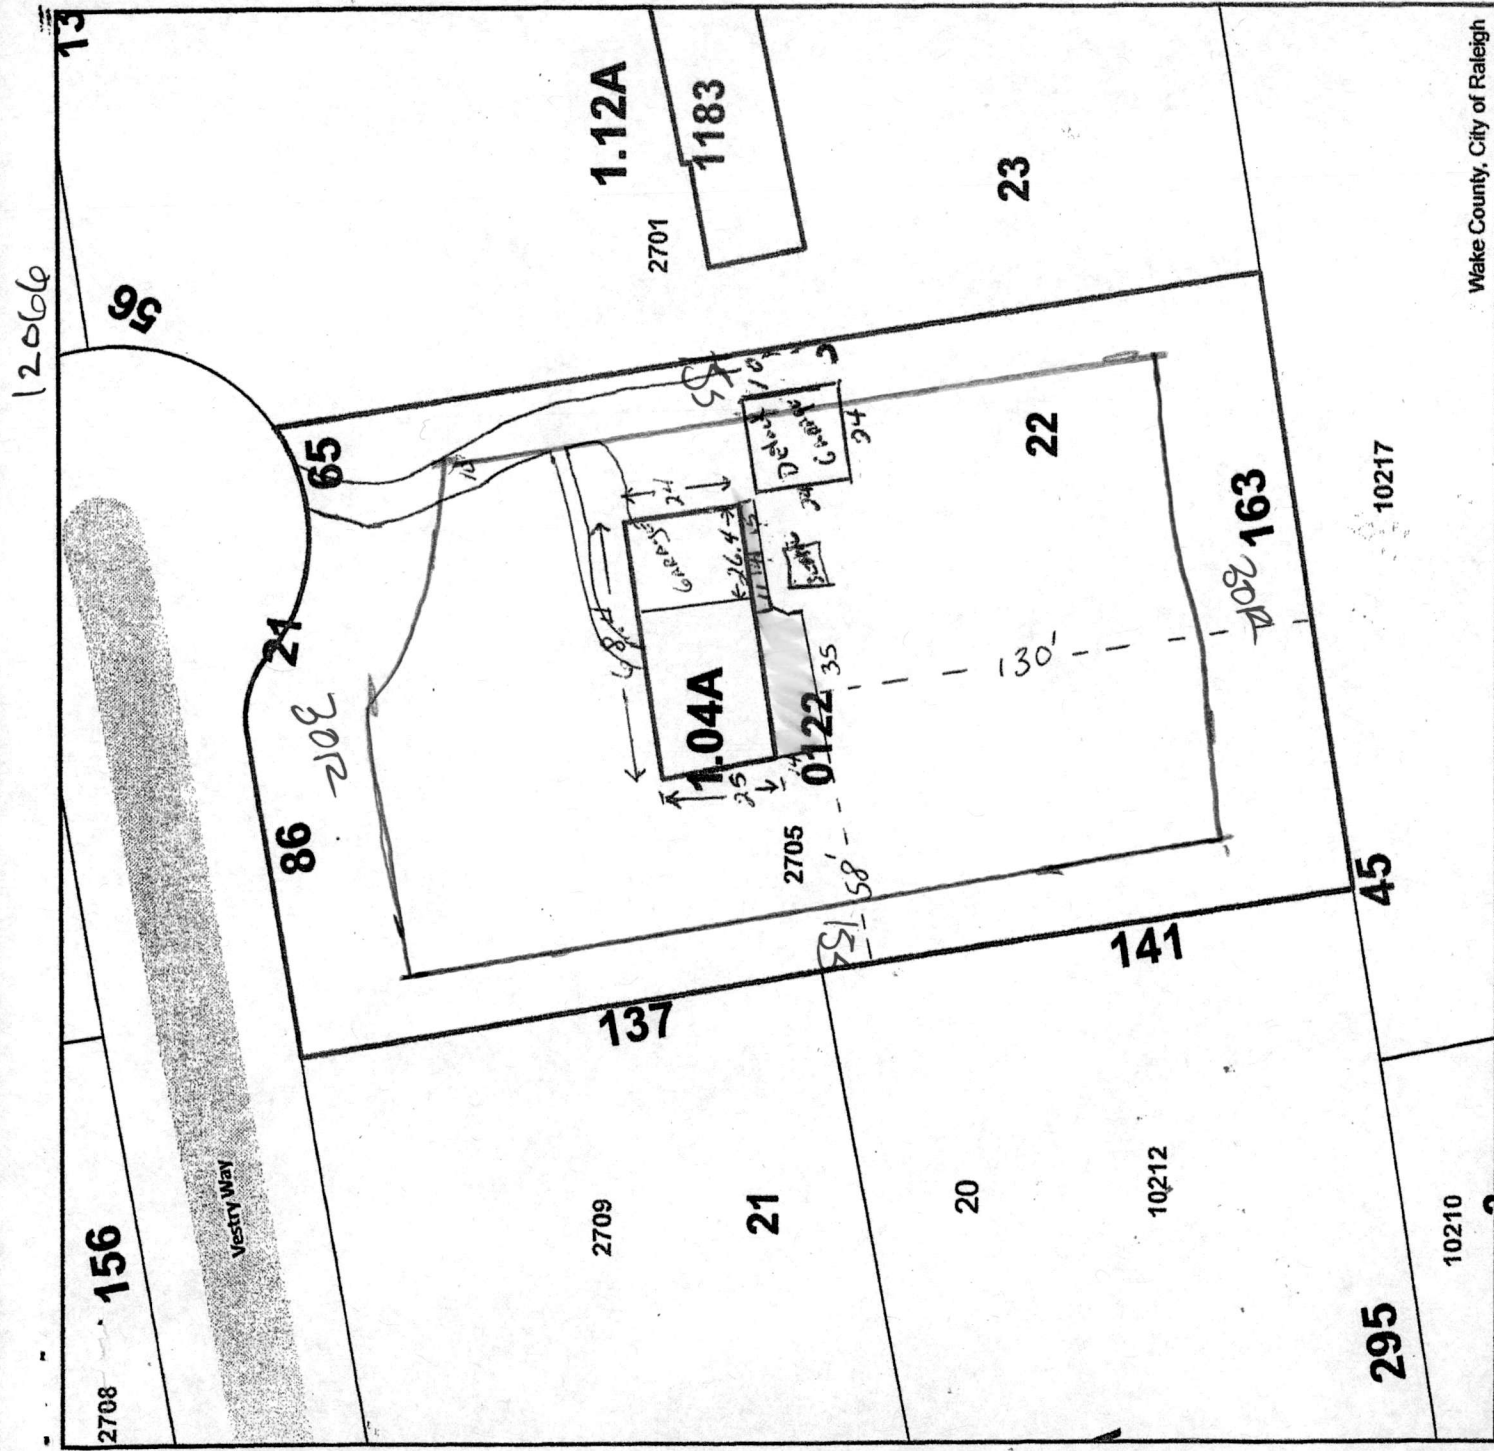

Wake County, City of Raleigh

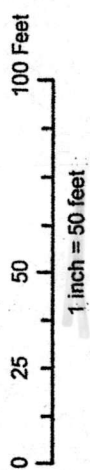

0799350122

certify that the location of planned or existing structures are accurately shown. I understand failure to locate structures in accordance with this plot plan may require the relocation of structure(s) regardless degree of completion. I hereby grant permission to Municipal/County Representatives the right of entry to make evaluations or inspections upon this property.

Signature of Owner or Authorized Agent

Zoning R40W By 6826
 Approve X Date 1-14-15
 Revise Use A3A.D
 Reject MBL 101A
 Front 30 Rear 30
 Side 15 Corner _____
 Comments: _____

0151836

Disclaimer
MapInfo makes every effort to produce and publish the most current and accurate information possible. However, the maps are produced for information purposes, and are NOT surveys. No warranties, expressed or implied, are provided for the data therein, its use or its interpretation.