

WAKE COUNTY DEPARTMENT OF ENVIRONMENTAL SERVICES WASTEWATER PERMIT

NO PERMIT(S) FOR CONSTRUCTION, LOCATION OR RELOCATION ACTIVITY SHALL BE ISSUED UNTIL AN
AUTHORIZATION FOR WASTEWATER SYSTEM CONSTRUCTION AUTHORIZATION HAS BEEN ISSUED
***PERMIT VOID IF NOT IN COMPLIANCE WITH ZONING REGULATIONS AND/OR IF SITE IS ALTERED OR
INTENDED USE CHANGED***

OPERATIONS PERMIT

PERMIT # WREP-143989-2025

APPLICATION DATE: 03/30/2025

BLDG. PERMIT#:

PIN: 0883983092

RECORDED: Yes

TOWNSHIP: 14 - New Light

JURISDICTION: Wake County

ZONING: R-80W

APPLICANT: Grace Shaughnessy
14928 Creedmoor RD

BUSINESS PHONE: (919) 414-0421

HOME PHONE: (919) 414-0421

MOBILE PHONE: (919) 414-0421

HD USE: 0001 REPAIR/EXISTING SYSTEM

EXISTING USE: 101A CONVENTIONAL ONE-FAMILY HOUSE

SITE ADDRESS: 14928 CREEDMOOR RD

SUBDIVISION: KEITH LD

LOT:

ACRES: 0.28

DIRECTIONS: TAKE CAPITAL BLVD TO 540 W, EXIT TO CREEDMOOR RD, PROPERTY ON RIGHT

Systems defined as either type III-b, III-g with a pump, IV, V or VI, in accordance with the North Carolina administrative code 15A NCAC 18a .1961, table V as adopted by reference in the "Regulations Governing Wastewater Treatment Dispersal Systems in Wake County", requires Wake County Environmental Services to conduct periodic inspections of the system type pursuant to 15A NCAC 18a. 1961 (j). Fees for these inspections will be charged as per the approved Fee Schedule. In addition, all systems are to be operated and maintained as specified in 15A NCAC 18A .1961. This permit is based in part on information provided by the homeowner and/or his/her representative in the application submitted for this permit. The Environmental Health Specialist is not responsible for false or misleading information contained in the application. The environmental health specialist is also not responsible for concealed conditions on the property or for statements in this report that may have resulted from false or misleading statements provided to him/her in the application. Neither Wake County nor the Environmental Health Specialist warrants that the septic tank system will continue to function satisfactorily in the future or that the water supply will remain potable.

OPERATION PERMIT VALID FOR: No Expiration

INSTALLED BY: OTHER - KEITH CLEMMONS

PROPRIETARY SYSTEM: IQ4P - Infiltrator Quick 4 Plus

PRETREATMENT SYSTEM:

Low Profile

SYSTEM TYPE INSTALLED: III G

OPERATION PERMIT: STATUS: Issued

ISSUED BY: Amanda Cabiness

ISSUED DATE: 06/24/2025

SEPTIC TANK: Infiltrator - IM-1060 - 1094
gallons

DATE OF MANUFACTURE:

FILTER: Polylok - PL-68

GREASE TRAP:

DATE OF MANUFACTURE:

FILTER:

DOSING PUMP TANK:

DATE OF MANUFACTURE:

FILTER:

CC1: ETM1:

CC2:

ETM2:

RECIRCULATION TANK:

DATE OF MANUFACTURE:

CC1: ETM1:

CC2:

ETM2:

SEPTIC TANK ELEVATION: 6.40

GREASE TRAP ELEVATION:

DOSING PUMP TANK ELEVATION:

RECIRCULATION TANK ELEVATION:

DISTRIBUTION DEVICE ELEVATION: 7

INSTALLED TRENCH DEPTH	INSTALLED AGGREGATE DEPTH	INSTALLED TRENCH LENGTH	INSTALLED TRENCH BOTTOM ELEVATION
12	8	60	9.1
12	8	60	8.7
12	8	60	7.5
12	8	50	7.2
12	8	46	7

ACTUAL PRESSURE HEAD:

ACTUAL FLOW RATE:

ACTUAL DOSE VOLUME: 0

SPECIFIC OPERATION REQUIREMENTS:

SYSTEM INSTALLED TO SERVE AN EXISTING 2 BEDROOM SINGLE FAMILY DWELLING WITH A MAXIMUM OCCUPANCY OF 4 PEOPLE AND A DESIGNED FLOW RATE OF 240 GALLONS PER DAY.


ISSUED BY:



DATE: 06/24/2025



14928 CREEDMOOR RD
 WREP-143989-2025
 OPERATION PERMIT
 AHC - 6/24/2025

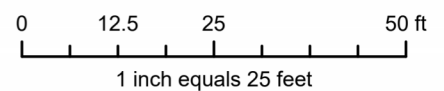

Disclaimer
 iMaps makes every effort to produce and publish the most current and accurate information possible. However, the maps are produced for information purposes, and are **NOT** surveys. No warranties, expressed or implied, are provided for the data therein, its use, or its interpretation.