

Environmental Services - Water Quality
Onsite Wastewater Scan Data Entry Form

PERMIT #: D 0 1 0 6 4 3

PIN #: 1 7 8 5 1 3 7 7 0 9

OP DATE: 1 0 1 0 6 1 2 0 0 0

SYSTEM USE:

- ☒ House
☐ Mobile Home
☐ Business
☐ Other

SEWAGE TYPE:

- ☒ Domestic
☐ Industrial

PUMP/SIPHON?:

- ☒ Yes
☐ No

PRESSURE MANIFOLD:

- ☐ Yes
☒ No

SYSTEM TYPE:

- ☐ I
☐ II
☒ III
☐ IV
☐ V
☐ VI
☐ Other

SUB TYPE:

- ☐ A
☒ B
☐ C
☐ D
☐ E
☐ F
☐ G

NBR BEDROOMS:

- ☐ 1
☐ 2
☐ 3
☒ 4
☐ 5
☐ 6
☐ Other

MAINT. SCHEDULE:

- ☐ Yes
☒ No

CERT. OPERATOR

- ☐ Yes
☒ No

GT	ST	PT	SIZE
☐	☐		750
☐	☐	☐	900
☐	☒	☒	1,000
☐	☐	☐	1,200
☐	☐	☐	1,500
☐	☐	☐	1,800
☐	☐	☐	2,100
☐	☐	☐	2,500
☐	☐	☐	3,000
☐	☐	☐	4,000
☐	☐	☐	5,000
☐	☐	☐	8,000
☐	☐	☐	10,000
☐	☐	☐	Other
☒		☐	None/NA GT or PT

DRAINFIELD SIZE(SQ. FT.)

0 1 2 0 0

DRAIN TYPE:

- ☐ Stone
☒ EZ Flow
☐ Infiltrator
☐ Biodiffuser
☐ Cultec
☐ Drip
☐ Hancor
☐ Large Dia. Pipe
☐ Multi-Pipe
☐ Other

MAX DEPTH (IN.):

- ☐ 12 in. or less
☒ 18 in. or less
☐ 24 in. or less
☐ 26 in. or less
☐ 28 in. or less
☐ 30 in. or less
☐ 32 in. or less
☐ 36 in. or less
☐ Other

STONE DEPTH (IN.):

- ☐ 8 in. or less
☐ 12 in. or less
☐ 18 in. or less
☐ 24 in. or less
☒ Other

TRENCHES:

- ☒ Individual
☐ Bed

TRENCH WIDTH (IN.):

- ☐ 12 in. or less
☐ 18 in.
☐ 24 in.
☒ 36 in.
☐ 6 ft. or less
☐ 9 ft. or less
☐ Other

WAKE COUNTY DEPARTMENT OF ENVIRONMENTAL SERVICES WELL AND SEWAGE SITE LOCATION PERMIT

NO PERMIT(S) FOR CONSTRUCTION, LOCATION OR RELOCATION ACTIVITY SHALL BE ISSUED
UNTIL AN AUTHORIZATION FOR WASTEWATER SYSTEM CONSTRUCTION HAS BEEN ISSUED
PERMIT VOID IF NOT IN COMPLIANCE WITH ZONING REGULATIONS AND/ OR IF SITE IS ALTERED OR INTENDED USE CHANGED

PERMIT#: D010643 STATUS: A APP DATE: 05/14/1998 BLDG PERMIT#: 0984077
APPLICANT: ANDERSON HOMES, INC DAY PHONE: (919) 828 - 6030
ADDRESS: 5443 PYLON DR FAX#: (919) 828 - 7516
CITY: RALEIGH STATE: NC ZIP: 27606
OWNER: KEY WEST ENTERPRISES INC DAY PHONE: (000) 000 - 0000
ADDRESS: P O BOX 1859 FAX#: (000) 000 - 0000
CITY: WAKE FOREST STATE: NC ZIP: 27588
HD USE CD: 101 ONE-FAMILY HOUSE ORIG PERMIT#: REC?: Y
EXIST USE: TAX MAP#: 0475 0000
BEDROOMS: 4 BSMT: N #EMPLOYEES: 0 WATER: C WASTEWATER: I GARB DISPOSAL: N
TOWNSHIP: 10 MARKS CREEK JURIS: WC ZON: R40 PIN: 1785-03-13-9782-000 1785137709
SUBD#: S 000 000 00 SUBD NAME: HUNTDOLL LOT-SEC: 41 ACRE: 2.25
MPRV PRMT: ISSUED?: Y DATE: 07/13/1998 BY: SES TYPE SYSTEM: III G PUMP: Y
NSTR AUTH: ISSUED?: Y DATE: 05/13/2000 BY: DWW MAINT: OPER:
RECEIPT#: 0028432 FEE: 145.00 OP DATE: BY:
ATR SAMPL: REQ?: N APPROVED?: DATE: PROPRIETARY SYS: E E-Z LAY
ST#: 1464 MI: DIR: NAME: HUNTDOLL MAIN DIR: TYP: DR
DIRECTIONS: 64 BUSINESS L NC97 HWY L 2405 R HUNTDOLL MAIN D
R LOT 41 MARKED SFD FLOOD CK REQ'D

IMPROVEMENT PERMIT

SIZE OF TANK 1000 ST 1000 PT GALS. TOTAL SQ. FT. 1200 DEPTH OF STONE PSA IN. MAX. DEPTH LINE 22 IN.

WASTEWATER: DOMESTIC ☒ INDUSTRIAL ☐

I.P. ISSUED BY

SES (De W...

AUTHORIZATION FOR WASTEWATER SYSTEM CONSTRUCTION

VOID SIXTY (60) MONTHS FROM DATE OF ISSUANCE

AUTHORIZATION CONDITIONS

Contractor To Follow Contours, See Attached Site Plan For Wastewater System Design And Well Location. The wastewater system shall not be covered or placed into use until inspected by the Wake County Department of Environmental Services and an Operation Permit issued.

OTHER CONDITIONS: System should be installed without stepdowns, layout system first before excavating, if any change in system or layout is desired, call Steve Smith at 856-7441 to approve change, note trench depth.

SIZE OF TANK 1000 ST 1000 PT GALS. TOTAL SQ. FT. 1200 DEPTH OF STONE PSA IN. MAX. DEPTH LINE 22 IN.

ST FILTER REQUIRED ☒ NUMBER OF TRENCHES 03 LENGTH OF TRENCHES 133 FT. WIDTH OF TRENCHES 3 FT.

C.A. ISSUED BY SES De W... INSTALLED BY David Brantley & Sons CTR. I.D. #

SEPTIC TANK FILTER USED Zabul

INNOV. APPRL. #: IWW- DATE 12-6-00 INSTALLATION APPROVED BY Everett J. Conner, Jr., S.

WELL SYSTEM = PRIVATE ☐ SEMI-PUBLIC ☐ NEW ☐ REPLACEMENT ☐ EXISTING ☐

WELL LOG INFORMATION = DEPTH _____ CASING DEPTH _____ YIELD _____ STATIC LEVEL _____

WELL CONTRACTOR _____ REG.# _____ PUMP CONTRACTOR _____ REG.# _____

CONSTRUCTION COMPLIANCE = GROUT APPROVED ☐ DATE _____ EHS

WCHD ID # _____ WELLHEAD APPROVED ☐ DATE _____ EHS

NEGATIVE BACTERIOLOGICAL RESULTS ☐ DATE _____ EHS

SYSTEM FINALIZED ☐ DATE _____ EHS

COMMENTS:

This permit is based in part on information provided by the homeowner or his/her representative in the application submitted for this permit. The Environmental Health Specialist is not responsible for false or misleading information contained in the application. The Environmental Health Specialist is also not responsible for concealed conditions on the property or for statements in this report that may have resulted from false or misleading statements provided to him in the application. Neither Wake County nor the Environmental Health Specialist warrants that the septic tank system will continue to function satisfactorily in the future or that the water supply will remain potable.

ST: DB 1000 PT: DB 1000
STB 846 PT 237
7-20-00 3-29-00

PLOT PLAN FOR ANDERSON HOMES

Revised to
PSA -


As Built

REF: B. M.

D10643

1785.03 139782

225AC

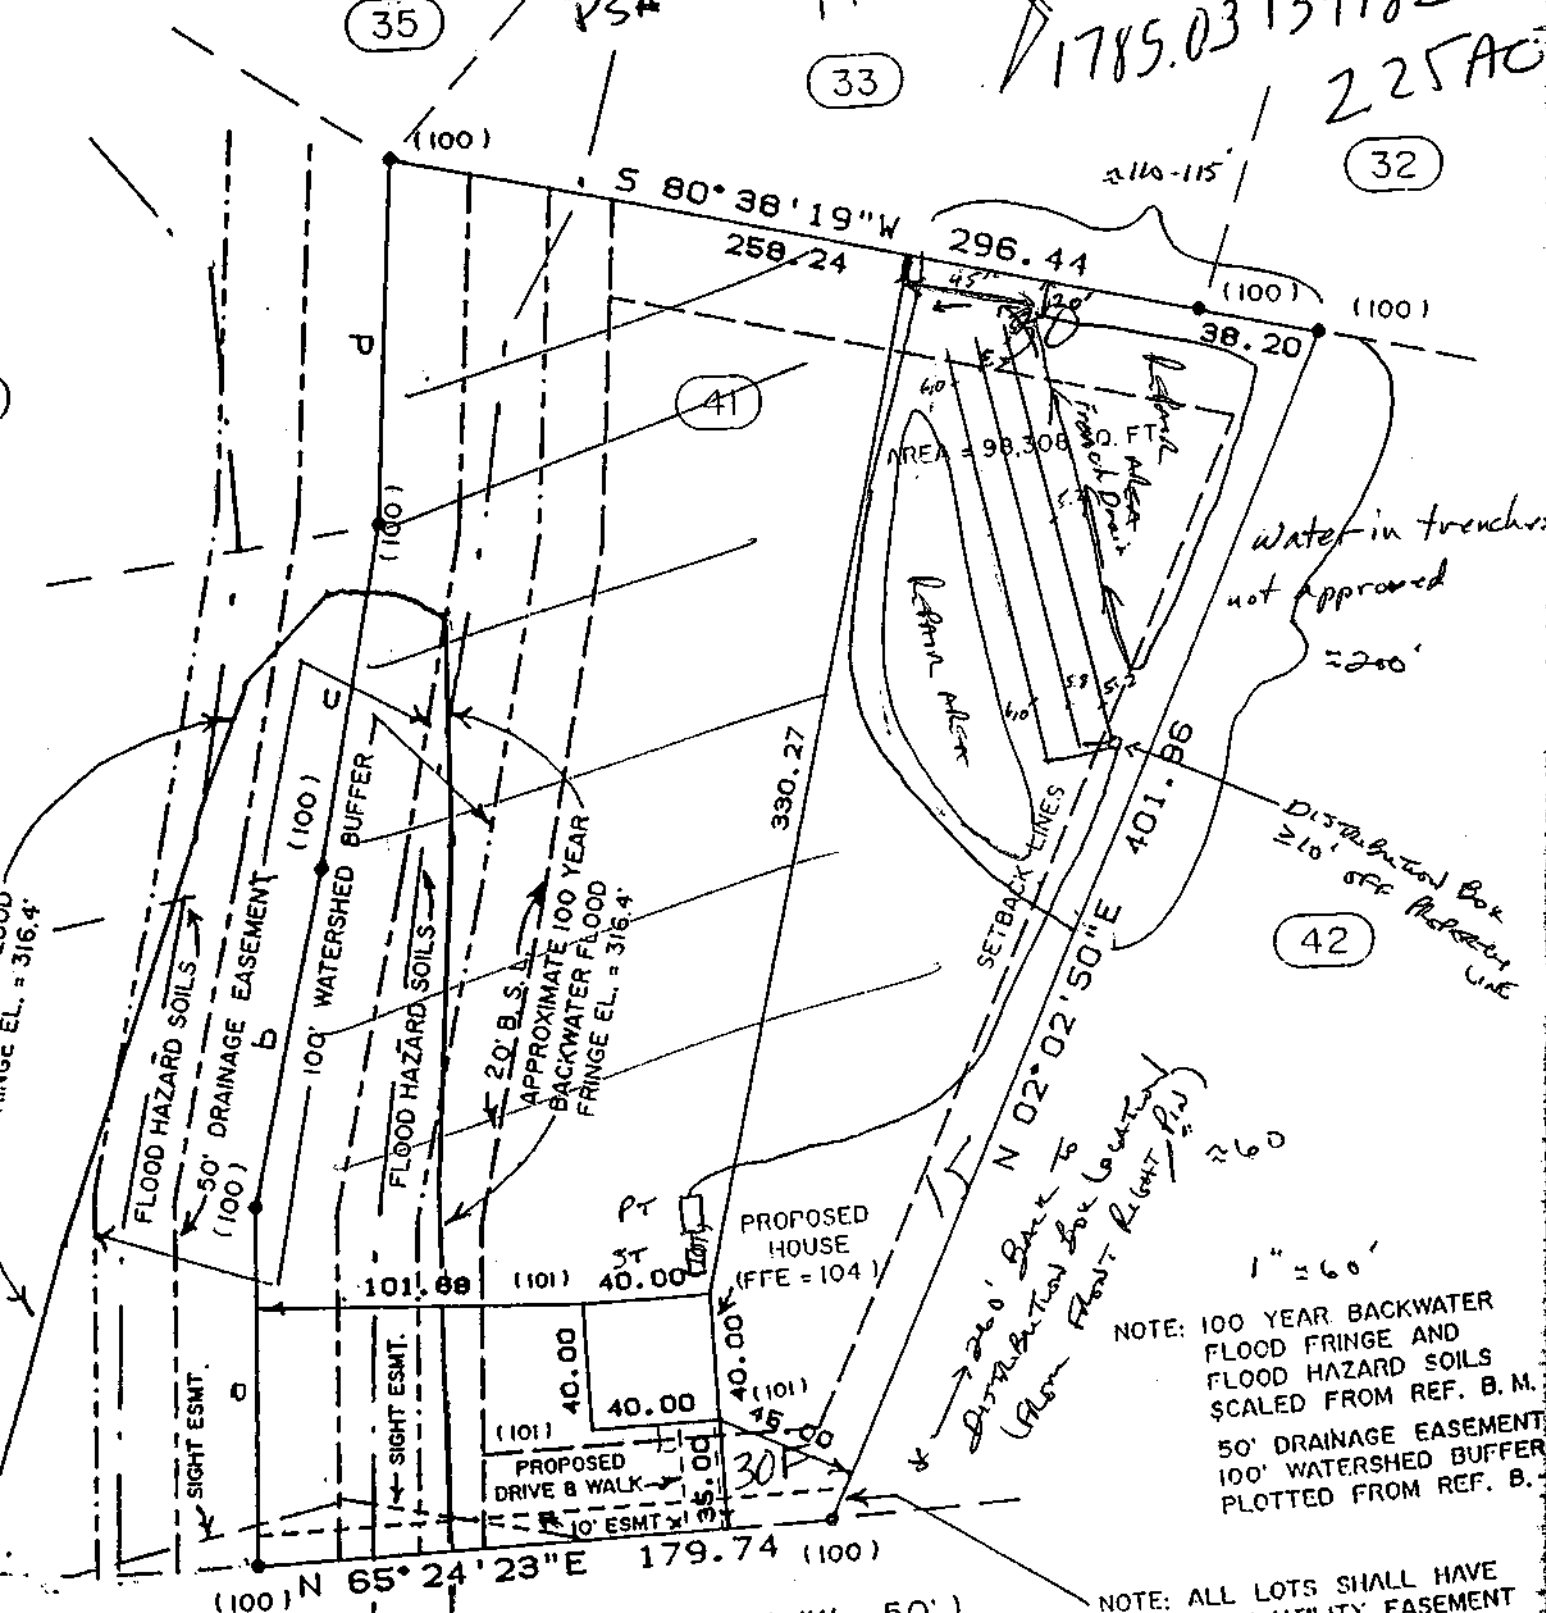

164 HUNTDALL MAIN DRIVE (PUBLIC, R/W = 50')

NOTE: ALL LOTS SHALL HAVE
A 10' UTILITY EASEMENT
ALONG A.J. ROAD RIGHTS
OF - WAYS. (PER REF. B. M.)

LINE TABLE
OF DISTANCE