



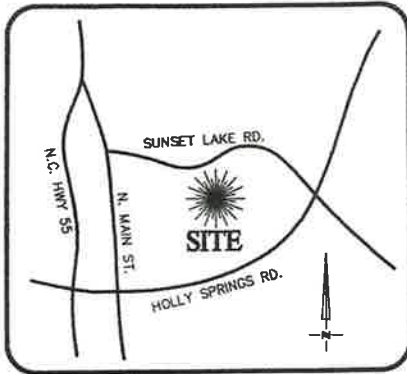


VICINITY MAP
Not To Scale

IMPERVIOUS SURFACE AREA	
DESCRIPTION	AREA
HOUSE w/ PORCH	2,290 S.F.
DECK/PATIO/HVAC	9 S.F.
DRIVEWAY & WALKS	1,167 S.F.
TOTAL (PROPOSED)=	3,466 S.F.
LOT AREA =	12,865 S.F.
% IMPERVIOUS AREA	=26.9%

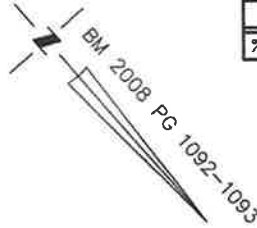

COV'S
Doing
HARDSCAPE

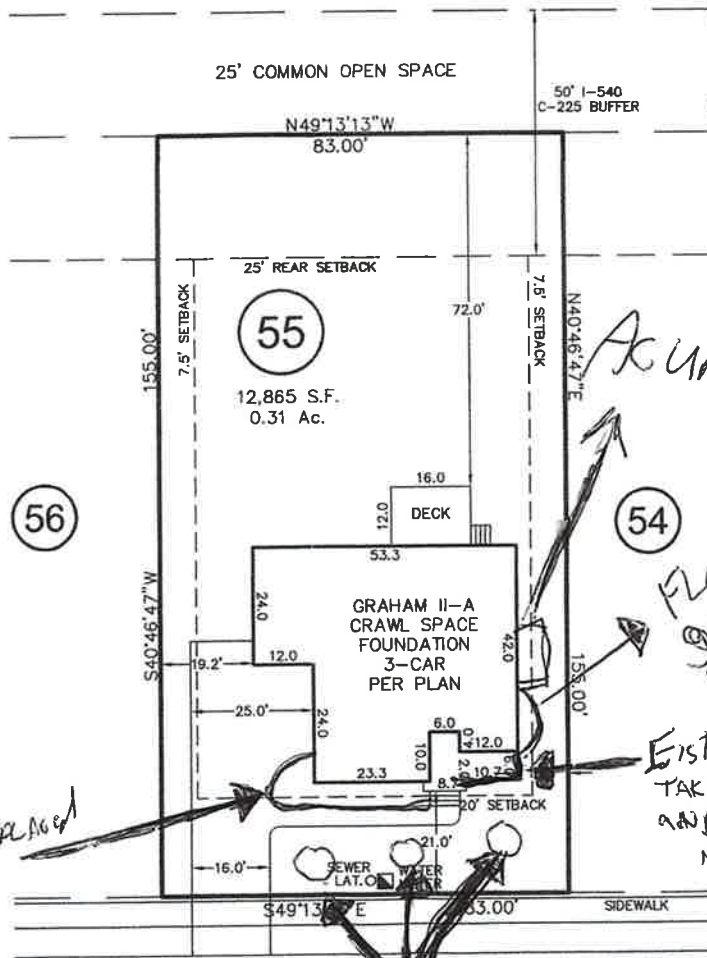

Edged AROUND with NATURAL from EXISTING WALL
ACTIVITIES
FLOWER Bed GETTING NEW WALL 1 FT HIGH with MATTERIAL I TAKE from EXISTING WALL
EXISTING WALL TAKING DOWN, AND RELACING NEW WALL SAME HEIGHT

Edging REPLACED with WALL 1 FT HIGH

RESTONWOOD DRIVE

51' PUBLIC R/W

NOTE:
STEPS SHALL BE 6 FT. OR LESS IN WIDTH AND MAY PROJECT INTO THE FRONT SETBACK.

THIS PROPERTY MAY BE SUBJECT TO ANY AND ALL APPLICABLE RESTRICTIONS, EASEMENTS, RIGHT-OF-WAY, UTILITIES AND RESTRICTIVE COVENANTS WHICH MAY BE OF RECORD OR IMPLIED.

EXISTING TREE RINGS TAKEN OUT AND REPLACED WITH

THIS DRAWING DOES NOT REFLECT AS-BUILT INFORMATION

PRELIMINARY PLAT

NOT FOR RECORDATION, CONVEYANCES, OR SALES



SCALE: 1" = 30'

**RESIDENTIAL
LAND SERVICES, PLLC.**

1500 Piney Plains Road, Suite 102
Cary, North Carolina 27518
Phone (919) 977-1554
Firm License # P-0873

HOUSE LOCATION PLOT PLAN

NEW BLOCK LEFT RIGHT

LOT 55, WOODCREEK SUBDIVISION, TRACT A, PHASE 1
Holly Springs Township, Wake County, North Carolina

PROPERTY OF: M/I HOMES
PLAT BOOK 2008 PAGE 1092-1093 DEED REFERENCE

DRAWN BY: JWW

DATE: JANUARY 5, 2016