

Environmental Services - Water Quality
Onsite Wastewater Scan Data Entry Form

PERMIT #: 0015281

PIN #: 0675099960

OP DATE: 12/21/2000

SYSTEM USE:

- ☒ House
☐ Mobile Home
☐ Business
☐ Other

SEWAGE TYPE:

- ☒ Domestic
☐ Industrial

PUMP/SIPHON?:

- ☐ Yes
☒ No

PRESSURE MANIFOLD:

- ☐ Yes
☒ No

SYSTEM TYPE:

- ☐ I
☒ II
☐ III
☐ IV
☐ V
☐ VI
☐ Other

SUB TYPE:

- ☒ A
☐ B
☐ C
☐ D
☐ E
☐ F
☐ G

NBR BEDROOMS:

- ☐ 1
☐ 2
☒ 3
☐ 4
☐ 5
☐ 6
☐ Other

MAINT. SCHEDULE:

- ☐ Yes
☒ No

CERT. OPERATOR

- ☐ Yes
☒ No

GT	ST	PT	SIZE
☐	☐	☐	750
☐	☐	☐	900
☐	☒	☐	1,000
☐	☐	☐	1,200
☐	☐	☐	1,500
☐	☐	☐	1,800
☐	☐	☐	2,100
☐	☐	☐	2,500
☐	☐	☐	3,000
☐	☐	☐	4,000
☐	☐	☐	5,000
☐	☐	☐	8,000
☐	☐	☐	10,000
☐	☐	☐	Other
☒	☐	☒	None/NA GT or PT

DRAINFIELD SIZE(SQ. FT.)

01260

DRAIN TYPE:

- ☒ Stone
☐ EZ Flow
☐ Infiltrator
☐ Biodiffuser
☐ Cultec
☐ Drip
☐ Hancor
☐ Large Dia. Pipe
☐ Multi-Pipe
☐ Other

MAX DEPTH (IN.):

- ☐ 12 in. or less
☐ 18 in. or less
☒ 24 in. or less
☐ 26 in. or less
☐ 28 in. or less
☐ 30 in. or less
☐ 32 in. or less
☐ 36 in. or less
☐ Other

STONE DEPTH (IN.):

- ☐ 8 in. or less
☒ 12 in. or less
☐ 18 in. or less
☐ 24 in. or less
☐ Other

TRENCHES:

- ☒ Individual
☐ Bed

TRENCH WIDTH (IN.):

- ☐ 12 in. or less
☐ 18 in.
☐ 24 in.
☒ 36 in.
☐ 6 ft. or less
☐ 9 ft. or less
☐ Other

WAKE COUNTY DEPARTMENT OF ENVIRONMENTAL SERVICES WELL AND SEWAGE SITE LOCATION PERMIT

NO PERMIT(S) FOR CONSTRUCTION, LOCATION OR RELOCATION ACTIVITY SHALL BE ISSUED
UNTIL AN AUTHORIZATION FOR WASTEWATER SYSTEM CONSTRUCTION HAS BEEN ISSUED
PERMIT VOID IF NOT IN COMPLIANCE WITH ZONING REGULATIONS AND/ OR IF SITE IS ALTERED OR INTENDED USE CHANGED

PERMIT#: D015281 STATUS: P APP DATE: 07/22/1999 BLDG PERMIT#: 0000293
APPLICANT: ARMSTRONG HOMES INC DAY PHONE: (919) 999 - 9999
ADDRESS: 147 HIGH COUNTRY DR FAX#: (919) 999 - 9999
CITY: CARY STATE: NC ZIP: 27513
OWNER: WINSLOW PROPERTIES DAY PHONE: (919) 919 - 9999
ADDRESS: 1011 SCHAUB DR FAX#: (919) 999 - 9999
CITY: RALEIGH STATE: NC ZIP: 27606
HD USE CD: 101 ONE-FAMILY HOUSE ORIG PERMIT#: REC?: Y
EXIST USE: TAX MAP#: 0877 0003
BEDROOMS: 3 BSMT: N #EMPLOYEES: 0 WATER: I WASTEWATER: I GARB DISPOSAL: N
TOWNSHIP: 12 MIDDLE CREEK JURIS: WC ZON: R30 PIN: 0675.01 09 8733 000
SUBD#: S 000 000 00 SUBD NAME: HOLLAND HILLS LOT-SEC: 4 ACRE: 0.70
IMPRV PRMT: ISSUED?: Y DATE: 09/22/1999 BY: SFM TYPE SYSTEM: II A PUMP:
CNSTR AUTH: ISSUED?: Y DATE: 05/31/2000 BY: SFM MAINT: N OPER: N
RECEIPT#: 0044885 FEE: 290.00 OP DATE: BY:
WATR SAMPL: REQ?: Y APPROVED?: DATE: PROPRIETARY SYS:
ST#: 3412 MI: DIR: NAME: ARNHEM DIR: TYP: CT
DIRECTIONS: GO 401 S-LEFT HWY 55-RIGHT SR2767
(HOLLAND RD) -SUB DIV ON LEFT-LOT #

IMPROVEMENT PERMIT

SIZE OF TANK 1000 ST PT GALS. TOTAL SQ. FT. 960 DEPTH OF STONE 12 IN. MAX. DEPTH LINE 24 IN.

WASTEWATER: DOMESTIC ☒ INDUSTRIAL ☐

I.P. ISSUED BY

Steve Meyer, RS

**AUTHORIZATION FOR WASTEWATER SYSTEM CONSTRUCTION
VOID SIXTY (60) MONTHS FROM DATE OF ISSUANCE
AUTHORIZATION CONDITIONS**

Contractor To Follow Contours, See Attached Site Plan For Wastewater System Design And Well Location. The wastewater system shall not be covered or placed into use until inspected by the Wake County Department of Environmental Services and an Operation Permit issued.

OTHER CONDITIONS: 1260
INSTALL LINES ON CONTOUR WITH NO STEP DOWNS. DO NOT EXCEED MAXIMUM TRENCH DEPTH. CALL PRIOR TO INSTALLATION WITH ANY QUESTIONS OR CHANGES.

11/2/00 SIZE OF TANK 1000 ST PT GALS. TOTAL SQ. FT. 960 DEPTH OF STONE 12 IN. MAX. DEPTH LINE 24 IN.
ST FILTER REQUIRED ☒ NUMBER OF TRENCHES 4 LENGTH OF TRENCHES 80 FT. WIDTH OF TRENCHES 3 FT.

C.A. ISSUED BY Steve Meyer, RS INSTALLED BY Tony Carroll CTR. I.D. #
SEPTIC TANK FILTER USED 12/21/00
INNOV. APPL. #: IWWS- DATE 12/21/00 INSTALLATION APPROVED BY Clement J. Maurer, RS

WELL SYSTEM = PRIVATE ☒ SEMI-PUBLIC ☐ NEW ☒ REPLACEMENT ☐ EXISTING ☐

WELL LOG INFORMATION = DEPTH 24 CASING DEPTH 95 YIELD 20 STATIC LEVEL 20
WELL CONTRACTOR Dady, REG. # 479 PUMP CONTRACTOR Al Yarb REG. # 281

CONSTRUCTION COMPLIANCE = GROUT APPROVED ☒ DATE 4/18/00 EHS Heather Glasco, EHS
WCHD ID # WELLHEAD APPROVED ☒ DATE 5/3/00 EHS Heather Glasco, EHS
NEGATIVE BACTERIOLOGICAL RESULTS ☒ DATE 5/4/01 EHS Heather Glasco, EHS
SYSTEM FINALIZED ☒ DATE 5/19/01 EHS Heather Glasco, EHS

COMMENTS:

This permit is based in part on information provided by the homeowner or his/her representative in the application submitted for this permit. The Environmental Health Specialist is not responsible for false or misleading information contained in the application. The Environmental Health Specialist is also not responsible for concealed conditions on the property or for statements in this report that may have resulted from false or misleading statements provided to him in the application. Neither Wake County nor the Environmental Health Specialist warrants that the septic tank system will continue to function satisfactorily in the future or that the water supply will remain potable.

30 By cmpt
 Date 7-22-99
 Use 101

Reject _____ MBL _____
 Front 30 Rear 30
 Side 10 Corner 30

Comments:

Lot # 4
 Holland Hills Phase IV

000293
 D15281



Pin #
 0675.01098733

I certify that the location of planned or existing structure(s) are accurately shown. I understand failure to locate structures in accordance with this plot plan may require the relocation of structure(s) regardless degree of completion. I hereby grant permission to Municipal/County Representatives the right of entry to make evaluations or inspections upon this property.

V. King 7-20-99
 Signature of Owner or Authorized Agent

1" = 40' scale

30 By cmf
Date 7-22-99
Use 101

Lot # 4
Holland Hills Phase IV


Reject _____ MBL _____
Front 30 Rear 30
Side 10 Corner 30

Comments:

Revised 5/31/00

000293

15281

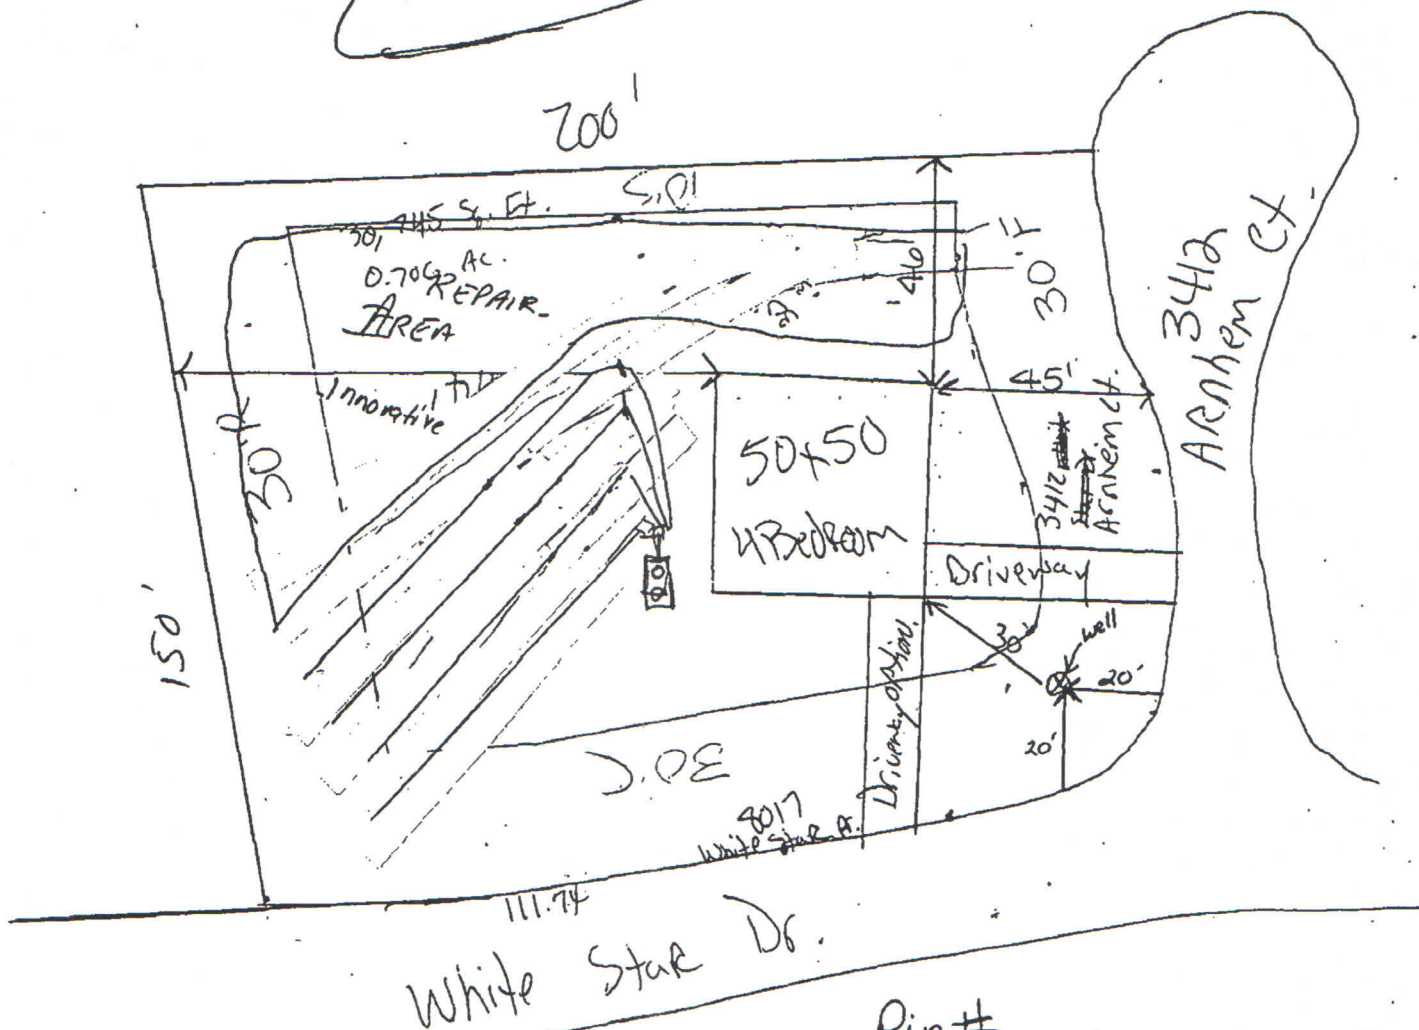

CA

- * 1200 gal ST
- * 960 SF. FT
- * 24' x 80' x 3'
- * 24" MCX T.D.
- * NO STEPDOWNS
- * Call Prior to Installation with any questions or changes!

Pin #

0675.01098733

I certify that the location of planned or existing structure(s) are accurately shown. I understand failure to locate structures in accordance with this plot plan may require the relocation of structure(s) regardless degree of completion. I hereby grant permission to Municipal/County Representatives the right of entry to make evaluations or inspections upon this property.

V. King

7-20-99

Signature of Owner or Authorized Agent