

Environmental Services - Water Quality
Onsite Wastewater Scan Data Entry Form

PERMIT #: B 0 1 5 0 8 4

PIN #: 1 7 1 0 8 7 7 6 2 8

OP DATE: 0 4 1 2 9 1 1 9 8 0

SYSTEM USE:

- ☒ House
☐ Mobile Home
☐ Business
☐ Other

SEWAGE TYPE:

- ☒ Domestic
☐ Industrial

PUMP/SIPHON?:

- ☐ Yes
☒ No

PRESSURE MANIFOLD:

- ☐ Yes
☒ No

SYSTEM TYPE:

- ☐ I
☒ II
☐ III
☐ IV
☐ V
☐ VI
☐ Other

SUB TYPE:

- ☒ A
☐ B
☐ C
☐ D
☐ E
☐ F
☐ G

NBR BEDROOMS:

- ☐ 1
☐ 2
☒ 3
☐ 4
☐ 5
☐ 6
☐ Other

MAINT. SCHEDULE:

- ☐ Yes
☒ No

CERT. OPERATOR

- ☐ Yes
☒ No

GT ST PT SIZE

- | | | | |
|-------------------------------------|-------------------------------------|-------------------------------------|------------------|
| ☐ | ☐ | ☐ | 750 |
| ☐ | ☐ | ☐ | 900 |
| ☐ | ☐ | ☐ | 1,000 |
| ☐ | ☒ | ☐ | 1,200 |
| ☐ | ☐ | ☐ | 1,500 |
| ☐ | ☐ | ☐ | 1,800 |
| ☐ | ☐ | ☐ | 2,100 |
| ☐ | ☐ | ☐ | 2,500 |
| ☐ | ☐ | ☐ | 3,000 |
| ☐ | ☐ | ☐ | 4,000 |
| ☐ | ☐ | ☐ | 5,000 |
| ☐ | ☐ | ☐ | 8,000 |
| ☐ | ☐ | ☐ | 10,000 |
| ☐ | ☐ | ☐ | Other |
| ☒ | | ☒ | None/NA GT or PT |

DRAINFIELD SIZE(SQ. FT.)

0 1 0 0 0

DRAIN TYPE:

- ☒ Stone
☐ EZ Flow
☐ Infiltrator
☐ Biodiffuser
☐ Cultec
☐ Drip
☐ Hancor
☐ Large Dia. Pipe
☐ Multi-Pipe
☐ Other

MAX DEPTH (IN.):

- ☐ 12 in. or less
☐ 18 in. or less
☐ 24 in. or less
☐ 26 in. or less
☐ 28 in. or less
☐ 30 in. or less
☐ 32 in. or less
☐ 36 in. or less
☒ Other

STONE DEPTH (IN.):

- ☐ 8 in. or less
☒ 12 in. or less
☐ 18 in. or less
☐ 24 in. or less
☐ Other

TRENCHES:

- ☐ Individual
☒ Bed

TRENCH WIDTH (IN.):

- ☐ 12 in. or less
☐ 18 in.
☐ 24 in.
☐ 36 in.
☒ 6 ft. or less
☐ 9 ft. or less
☐ Other

PERMIT VOID IF NOT IN COMPLIANCE WITH ZONING REGULATIONS PIN: 1710.08 87 7628

TAX MAP NO. 50

PARCEL NO. 74651

WAKE COUNTY HEALTH DEPARTMENT

SEPTIC TANK LAYOUT AND PERMIT

PERMIT NO. **B** 15084

OWNER OR CONTRACTOR

~~Pat Hayes~~ Jim + Brenda Hayes

DATE

5-1-79

LOCATION

OFF New Road Road in Gaines - next to Pinchurst Park 1/4
under ottot Wakefield Drive

S. R. NO. 25642

SUBDIVISION NAME

by Survey (Hayes Prop.)

LOT NO.

21

SECTION OR BLOCK NO.

GARBAGE DISPOSAL UNIT

YES ☐ NO ☒

HOUSE ☒

MOBILE HOME ☐

BUSINESS ☐

NO. BEDROOMS

3

LOT AREA

1.25 acres.

SIZE OF TANK

1200

700 gal.

NITRIFICATION LINE

(167' X 6')

1000 sq. ft.

DEPTH OF STONE IN LINES:

12" ☒ 18" ☐

WATER SUPPLY:

INDIVIDUAL ☐


PUBLIC ☒

* PERMIT VOID 12 MONTHS FROM DATE OF ISSUANCE.

* Town of Gaines water!

LAYOUT BY

David C. Nantz

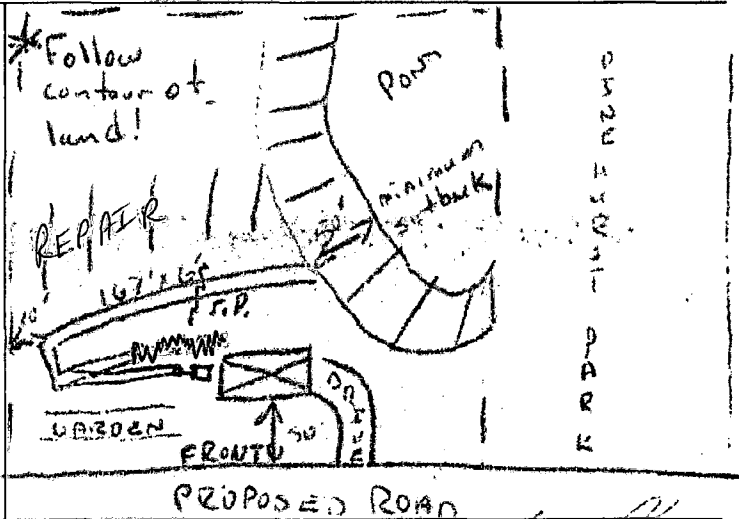

DATE

4-29-80

INSTALLED BY

W. Wilson

APPROVED BY

M. Frank