

Environmental Services - Water Quality
Onsite Wastewater Scan Data Entry Form

PERMIT #: **B 0 3 7 3 5 5**

PIN #: **1 7 4 8 0 5 4 8 1 9**

OP DATE: **1 1 / 1 4 / 1 9 8 6**

SYSTEM USE:

- ☒ House
☐ Mobile Home
☐ Business
☐ Other

SEWAGE TYPE:

- ☒ Domestic
☐ Industrial

PUMP/SIPHON?:

- ☐ Yes
☒ No

PRESSURE MANIFOLD:

- ☐ Yes
☒ No

SYSTEM TYPE:

- ☐ I
☒ II
☐ III
☐ IV
☐ V
☐ VI
☐ Other

SUB TYPE:

- ☒ A
☐ B
☐ C
☐ D
☐ E
☐ F
☐ G

NBR BEDROOMS:

- ☐ 1
☐ 2
☒ 3
☐ 4
☐ 5
☐ 6
☐ Other

MAINT. SCHEDULE:

- ☐ Yes
☒ No

CERT. OPERATOR

- ☐ Yes
☒ No

GT ST PT

- | | | |
|-------------------------------------|-------------------------------------|-------------------------------------|
| ☐ | ☐ | ☐ |
| ☐ | ☐ | ☐ |
| ☐ | ☒ | ☐ |
| ☐ | ☐ | ☐ |
| ☐ | ☐ | ☐ |
| ☒ | ☐ | ☒ |

SIZE

- 750
900
1,000
1,200
1,500
1,800
2,100
2,500
3,000
4,000
5,000
8,000
10,000
Other
None/NA GT or PT

DRAINFIELD SIZE(SQ. FT.)

0 1 0 0 0

DRAIN TYPE:

- ☒ Stone
☐ EZ Flow
☐ Infiltrator
☐ Biodiffuser
☐ Cultec
☐ Drip
☐ Hancor
☐ Large Dia. Pipe
☐ Multi-Pipe
☐ Other

MAX DEPTH (IN.):

- ☐ 12 in. or less
☐ 18 in. or less
☒ 24 in. or less
☐ 26 in. or less
☐ 28 in. or less
☐ 30 in. or less
☐ 32 in. or less
☐ 36 in. or less
☐ Other

STONE DEPTH (IN.):

- ☐ 8 in. or less
☒ 12 in. or less
☐ 18 in. or less
☐ 24 in. or less
☐ Other

TRENCHES:

- ☒ Individual
☐ Bed

TRENCH WIDTH (IN.):

- ☐ 12 in. or less
☐ 18 in.
☐ 24 in.
☒ 36 in.
☐ 6 ft. or less
☐ 9 ft. or less
☐ Other

MC

Wake

WAKE COUNTY HEALTH DEPARTMENT SEPTIC TANK LAYOUT AND PERMIT

37355

TAX MAP NO. 307 PARCEL NO. 3 ACS

PO. 37
16.07
W. 27093

PERMIT NO. B
OPERATION PERMIT ☐

WF

CONTRACTOR Charter Const.

OWNER

DATE 9/2/86

LOCATION 3101 Greenville Loop Rd.

S. R. NO. 2044

SUBDIVISION NAME Charterfield

LOT NO. 42

SECTION OR BLOCK NO. III

REPAIR ☐ ORIGINAL PERMIT NO. WELL PERMIT # C-315

GARBAGE DISPOSAL UNIT YES ☐ NO ☒

HOUSE ☒ MOBILE HOME ☐ BUSINESS ☐

NO. BEDROOMS 3 LOT AREA .95 ac.

SIZE OF TANK 1000 gal.

NITRIFICATION LINE 2-3' x 167' 1000 sq. ft.


DEPTH OF STONE IN LINES: 12" ☒

RISER AND BAFFLE REQUIRED ☒ PUMP REQUIRED ☐

WATER SUPPLY: INDIVIDUAL ☒ PUBLIC ☐ OTHER ☐

- PERMIT VOID 36 MONTHS FROM DATE OF ISSUANCE.
- PERMIT VOID IF NOT IN COMPLIANCE WITH ZONING REGULATIONS
- PERMIT MAY BE VOIDED IF SITE ALTERATIONS MADE

LAYOUT BY Kim A. Richardson P.E.

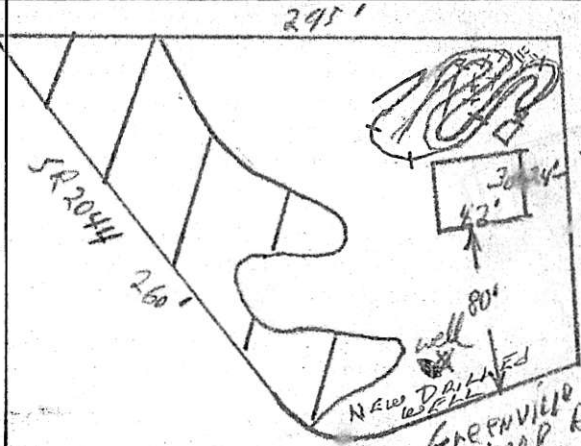

24" water trench depth
at carbon

DATE 11-14-86

INSTALLED BY J. H. Perry

APPROVED BY Sam M. Allen P.E.