

Environmental Services - Water Quality
Onsite Wastewater Scan Data Entry Form

PERMIT #: 0008491

PIN #: 1609177263

OP DATE: 01/12/1998

SYSTEM USE:

- ☒ House
☐ Mobile Home
☐ Business
☐ Other

SEWAGE TYPE:

- ☒ Domestic
☐ Industrial

PUMP/SIPHON?:

- ☐ Yes
☒ No

PRESSURE MANIFOLD:

- ☐ Yes
☒ No

SYSTEM TYPE:

- ☐ I
☒ II
☐ III
☐ IV
☐ V
☐ VI
☐ Other

SUB TYPE:

- ☒ A
☐ B
☐ C
☐ D
☐ E
☐ F
☐ G

NBR BEDROOMS:

- ☐ 1
☐ 2
☒ 3
☐ 4
☐ 5
☐ 6
☐ Other

MAINT. SCHEDULE:

- ☐ Yes
☒ No

CERT. OPERATOR:

- ☐ Yes
☒ No

GT ST PT SIZE

- | | | | |
|-------------------------------------|-------------------------------------|-------------------------------------|------------------|
| ☐ | ☐ | ☐ | 750 |
| ☐ | ☐ | ☐ | 900 |
| ☐ | ☒ | ☐ | 1,000 |
| ☐ | ☐ | ☐ | 1,200 |
| ☐ | ☐ | ☐ | 1,500 |
| ☐ | ☐ | ☐ | 1,800 |
| ☐ | ☐ | ☐ | 2,100 |
| ☐ | ☐ | ☐ | 2,500 |
| ☐ | ☐ | ☐ | 3,000 |
| ☐ | ☐ | ☐ | 4,000 |
| ☐ | ☐ | ☐ | 5,000 |
| ☐ | ☐ | ☐ | 8,000 |
| ☐ | ☐ | ☐ | 10,000 |
| ☐ | ☐ | ☐ | Other |
| ☒ | | ☒ | None/NA GT or PT |

DRAINFIELD SIZE(SQ. FT.)

01020

DRAIN TYPE:

- ☒ Stone
☐ EZ Flow
☐ Infiltrator
☐ Biodiffuser
☐ Cultec
☐ Drip
☐ Hancor
☐ Large Dia. Pipe
☐ Multi-Pipe
☐ Other

MAX DEPTH (IN.):

- ☐ 12 in. or less
☐ 18 in. or less
☒ 24 in. or less
☐ 26 in. or less
☐ 28 in. or less
☐ 30 in. or less
☐ 32 in. or less
☐ 36 in. or less
☐ Other

STONE DEPTH (IN.):

- ☐ 8 in. or less
☒ 12 in. or less
☐ 18 in. or less
☐ 24 in. or less
☐ Other

TRENCHES:

- ☒ Individual
☐ Bed

TRENCH WIDTH (IN.):

- ☐ 12 in. or less
☐ 18 in.
☐ 24 in.
☒ 36 in.
☐ 6 ft. or less
☐ 9 ft. or less
☐ Other

DA

WAKE COUNTY ENVIRONMENTAL HEALTH WELL AND SEWAGE SITE LOCATION PERMIT

NO PERMIT(S) FOR CONSTRUCTION, LOCATION OR RELOCATION ACTIVITY SHALL BE ISSUED

UNTIL AN AUTHORIZATION FOR WASTEWATER SYSTEM CONSTRUCTION HAS BEEN ISSUED

PERMIT VOID IF NOT IN COMPLIANCE WITH ZONING REGULATIONS AND/OR IF SITE IS ALTERED OR INTENDED USE CHANGED

PERMIT#: D008491 STATUS: A APP DATE: 12/02/1997 BLDG PERMIT#: 0981801
APPLICANT: DODSON, ROLAND A DAY PHONE: (919) 779 - 5998
ADDRESS: P O BOX 411 FAX#: (000) 000 - 0000
CITY: GARNER STATE: NC ZIP: 27529
OWNER: DODSON, ROLAND A & VIRGIN DAY PHONE: (919) 779 - 5998
ADDRESS: SAME FAX#: (000) 000 - 0000
CITY: GARNER STATE: NC ZIP: 27529
HD USE CD: 101 ONE-FAMILY HOUSE ORIG PERMIT#: REC?: Y
EXIST USE: TAX MAP#: 0747
BEDROOMS: 3 BSMT: N #EMPLOYEES: 0 WATER: C WASTEWATER: I GARB DISPOSAL: N
TOWNSHIP: 15 PANTHER BRANCH JURIS: WC ZON: 40W PIN: 1609.01 17 7263 000
SUBD#: S 000 000 00 SUBD NAME: WYNSTONE LOT-SEC: 16 ACRE: 1.76
IMPRV PRMT: ISSUED?: Y DATE: 02/13/1997 BY: RJD TYPE SYSTEM: II PUMP:
CNSTR AUTH: ISSUED?: Y DATE: 12/13/1997 BY: RJD DATE EXPIRED: 12/13/2002
RECEIPT#: FEE: 145.00 OP DATE: BY:
WATR SAMPL: REQ?: APPROVED?: DATE: PROPRIETARY SYS:
ST#: 4036 MI: DIR: NAME: STONE SUMMIT DIR: TYP: LN
DIRECTIONS: 401 S TO L ON SR 1006 TO L INTO SUB GO TO STONE
SUMMIT LN IN CULDESAC

IMPROVEMENT PERMIT

SIZE OF TANK 1000 ST PT GALS. TOTAL SQ. FT. 1020 DEPTH OF STONE 12 IN. MAX. DEPTH LINE 24 IN.

WASTEWATER: DOMESTIC ☐ INDUSTRIAL ☐

I.P. ISSUED BY

Ron Dudley R.S.

AUTHORIZATION FOR WASTEWATER SYSTEM CONSTRUCTION

VOID SIXTY (60) MONTHS FROM DATE OF ISSUANCE

AUTHORIZATION CONDITIONS

Contractor To Follow Contours, See Attached Site Plan For Wastewater System Design And Well Location. The wastewater system shall not be covered or placed into use until inspected by the Wake County Environmental Health Division and an Operation Permit issued.

OTHER CONDITIONS: POSSIBLE PUMP DEPENDING ON HOUSE LOCATION

SIZE OF TANK 1000 ST PT GALS. TOTAL SQ. FT. 1020 DEPTH OF STONE 12 IN. MAX. DEPTH LINE 24 IN.

NUMBER OF TRENCHES 2 LENGTH OF TRENCHES 170 FT. WIDTH OF TRENCHES 3 FT.

C.A. ISSUED BY *Ron Dudley R.S.* INSTALLED BY *PRESTON WRENN* CTR. I.D. #

INNOV. APPRL. #: IWWS- DATE 1/12/98 INSTALLATION APPROVED BY *Ron Dudley R.S.*

WELL SYSTEM = PRIVATE ☐ SEMI-PUBLIC ☒ NEW ☐ REPLACEMENT ☐ EXISTING ☐

WELL LOG INFORMATION = DEPTH CASING DEPTH YIELD STATIC LEVEL

WELL CONTRACTOR REG.# PUMP CONTRACTOR REG.#

CONSTRUCTION COMPLIANCE = GROUT APPROVED ☐ DATE EHS

WCHD ID # WELLHEAD APPROVED ☐ DATE EHS


NEGATIVE BACTERIOLOGICAL RESULTS ☐ DATE EHS

SYSTEM FINALIZED ☐ DATE EHS

COMMENTS:

This permit is based in part on information provided by the homeowner or his/her representative in the application submitted for this permit. The Environmental Health Specialist is not responsible for false or misleading information contained in the application. The Environmental Health Specialist is also not responsible for concealed conditions on the property or for statements in this report that may have resulted from false or misleading statements provided to him in the application. Neither Wake County nor the Environmental Health Specialist warrants that the septic tank system will continue to function satisfactorily in the future or that the water supply will remain potable.

0981801
D-8491
4036 STONE
Summit
LW

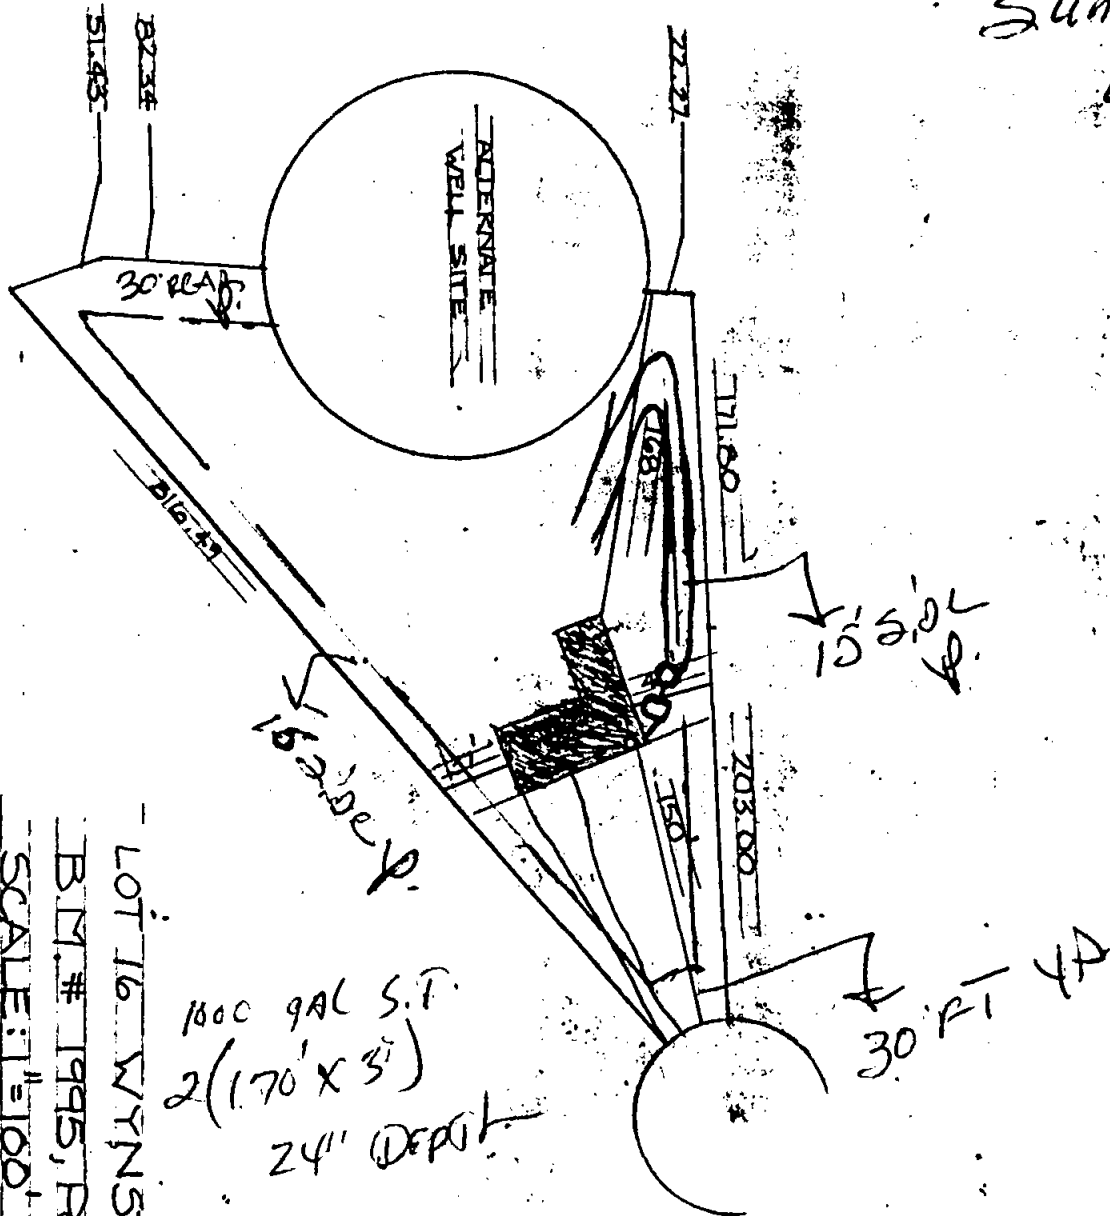

1000 GAL S.T.
2(170' X 3')
24" DEPTH

DRAWN BY BERT DODSON
DATE 11-30-97.

LOT 16 WYNSTONE
B.M. # 1995, Pg. 32
SCALE: 1"=100'

I certify that the location of planned or existing structures are accurately shown. I understand that any relocation of structures requires a degree of completion. I hereby grant permission to Municipal/County representatives the right of entry to make evaluation or measurements upon this property.

Signature of Owner or Authorized Agent
(Signature)

Zone: 4A
By: M.T.
Date: 12/15/97
Use: 101
MBL: 30
15