

Environmental Services - Water Quality
Onsite Wastewater Scan Data Entry Form

PERMIT #: **W A I 5 0 4 I**

PIN #: **0 6 3 7 8 8 0 3 7 0**

OP DATE: **0 8 / 2 4 / 2 0 1 6**

SYSTEM USE:

- ☒ House
☐ Mobile Home
☐ Business
☐ Other

SEWAGE TYPE:

- ☒ Domestic
☐ Industrial

PUMP/SIPHON?:

- ☐ Yes
☒ No

PRESSURE MANIFOLD:

- ☐ Yes
☒ No

SYSTEM TYPE:

- ☐ I
☒ II
☐ III
☐ IV
☐ V
☐ VI
☐ Other

SUB TYPE:

- ☒ A
☐ B
☐ C
☐ D
☐ E
☐ F
☐ G

NBR BEDROOMS:

- ☐ 1
☐ 2
☐ 3
☐ 4
☒ 5
☐ 6
☐ Other

MAINT. SCHEDULE:

- ☐ Yes
☒ No

CERT. OPERATOR

- ☐ Yes
☒ No

GT	ST	PT	SIZE
☐	☐		750
☐	☐	☐	900
☐	☐	☐	1,000
☐	☐	☐	1,200
☐	☒	☐	1,500
☐	☐	☐	1,800
☐	☐	☐	2,100
☐	☐	☐	2,500
☐	☐	☐	3,000
☐	☐	☐	4,000
☐	☐	☐	5,000
☐	☐	☐	8,000
☐	☐	☐	10,000
☐	☐	☐	Other
☒		☒	None/NA GT or PT

DRAINFIELD SIZE(SQ. FT.)

0 1 5 3 0

DRAIN TYPE:

- ☐ Stone
☒ EZ Flow
☐ Infiltrator
☐ Biodiffuser
☐ Cultec
☐ Drip
☐ Hancor
☐ Large Dia. Pipe
☐ Multi-Pipe
☐ Other

MAX DEPTH (IN.):

- ☐ 12 in. or less
☒ 18 in. or less
☐ 24 in. or less
☐ 26 in. or less
☐ 28 in. or less
☐ 30 in. or less
☐ 32 in. or less
☐ 36 in. or less
☐ Other

STONE DEPTH (IN.):

- ☐ 8 in. or less
☒ 12 in. or less
☐ 18 in. or less
☐ 24 in. or less
☐ Other

TRENCHES:

- ☒ Individual
☐ Bed

TRENCH WIDTH (IN.):

- ☐ 12 in. or less
☐ 18 in.
☐ 24 in.
☒ 36 in.
☐ 6 ft. or less
☐ 9 ft. or less
☐ Other


Revised
0170325

WATER W 15041

N/F
AVENT FERRY DEVELOPERS, LLC.
DB 15886 PG 102
PIN 0638700470

380
By: KAS
Date: 8/24/16
Use: 439D
MEBL 101A
Front: 50
Side: 5
Corner: 5
Comments:

NOTE: SOME LINE ANNOTATION
HAS BEEN HIDDEN TO EASE
TEXT CROWDING. LINES ARE
DESCRIBED IN LINE CHART AND
ARE IN NUMERICAL ORDER.

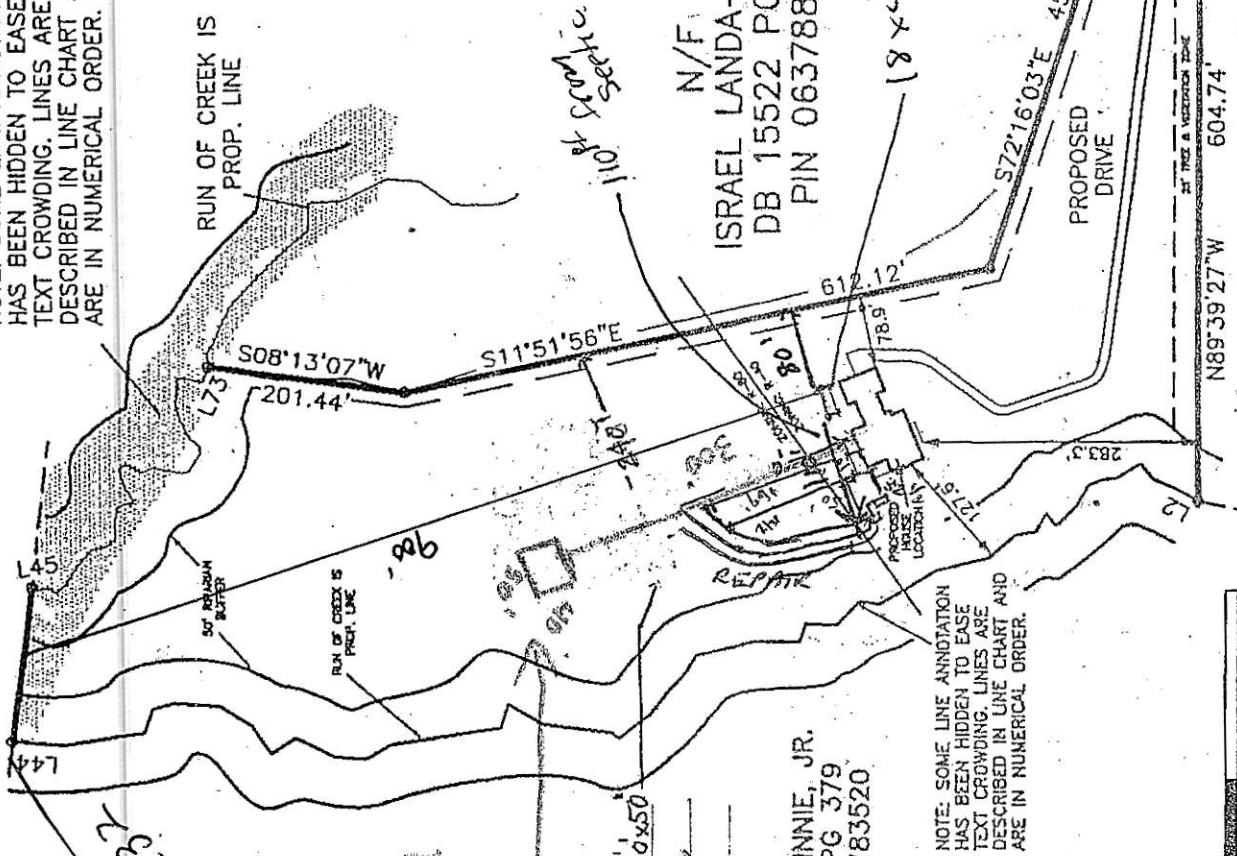

N/F
ANDREW MCKINNIE, JR.
DB 1903 PG 379
PIN 0637783520


N/F
ISRAEL LANDA-MAZARI
DB 15522 PG 1750
PIN 0637885187

N/F
JOEL P. HOLT
DB 13326 PG 2593
PIN 0637874623

SCALE: 1" = 200'

LEGEND
IRON PIPE FOUND
IRON PIN SET
RAILROAD SPIKE
PARKER-KALON
NAIL FOUND
WATER VALVE
WATER METER
CLEAN OUT
S.F. SQUARE FEET
ELEVATIONS
CATV CABLE TV BOX
ELEC ELECTRIC BOX
PB PLAT BOOK
PP POWER POLE
DB DEED BOOK
--- LINES NOT SURVEYED
NOT PREPARED FOR RECORDATION
JOB NO. 2517.001
I, CURT T. LANE CERTIFY THAT THIS MAP WAS DRAWN FROM AN
ACTUAL SURVEY MADE UNDER MY SUPERVISION, THAT THE
OF CLOSURE AS CALCULATED IS 1:10,000+, THAT THE
BOUNDARIES NOT SURVEYED ARE SHOWN AS BROKEN LINES.

TRUE LINE SURVEYING, P.C.

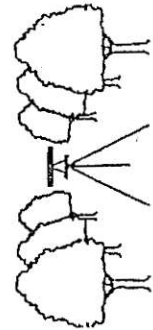

205 WEST MAIN STREET
CLAYTON, N.C. 27520
TELEPHONE: (919) 359-0427
FAX: (919) 359-0428
www.true-linesurveying.com

DATE OF SURVEY: 6/3/15
DRAWN: TYSON
DATE: 6/11/15
CHECKED: CURK
C-1857

MINIMUM BUILDING SETBACKS
ZONING: R-80
FRONT: 40'
CORNER: 40'
SIDE: 20'
REAR: 30'

MINIMUM BUILDING SETBACKS
ZONING: R-40
FRONT: 30'
CORNER: 30'
SIDE: 15'
REAR: 30'

NOTES:
PUBLIC WATER SYSTEM
WELL ☐ YES ☒ NO
PUBLIC SEWER SYSTEM
☐ YES ☒ NO
HOUSE DIMENSIONS: 110.3' x 88.7'

IMPERVIOUS SURFACE TABLE
PROPOSED HOUSE: 5474 SF
PROPOSED DRIVE: 10890 SF
TOTAL: 15364 SF
LOT AREA: 508286 SF
PERCENTAGE OF IMPERVIOUS: 3.22%

Any changes to site plan must be approved as shown for
for septic systems and wells, regarding any pools, decks,
additions and/or accessory structures. Applicant is responsible
for protecting all portions of the septic system, repair area and
from damage during construction. Adhere to all Local and
County Department of Environmental Services.
and Waste Water Section

0637880370

I certify that the location of planned or existing structure(s)
are accurately shown. I understand failure to locate
structures in accordance with this plot plan may
require the installation of structure(s) regardless
of the completion. I hereby grant permission to
Municipal County Board of Public Safety to make
to make evaluations of inspections upon this property.

IR SIGNATURE

OWNERS:
JEFFREY MICHAEL DAVIDSON
JULIE YVETTE DAVIDSON
6312 CASS HOLT ROAD
HOLLY SPRINGS, NC 27540

CASS HOLT ROAD
60' R/W (PUBLIC)

TRACT 4
LISA ADAMS

PLOT PLAN
FOR

SWEANEY HOMES

6312 CASS HOLT ROAD, HOLLY SPRINGS, NC 27540

NUMBER	DIRECTION	DISTANCE
L1	S62°27'32"W	238.51'
L2	N29°24'39"E	29.70'
L3	N24°38'30"E	21.20'
L4	N50°37'20"E	21.67'
L5	N30°38'07"W	29.97'
L6	N03°04'50"W	12.09'
L7	N20°26'55"W	16.68'
L8	N60°32'20"W	25.39'
L9	N44°43'00"W	29.14'
L10	N49°56'49"E	15.99'
L11	N58°49'09"W	21.34'
L12	N09°37'51"W	20.47'
L13	N40°40'22"W	36.65'
L14	N14°08'16"W	56.59'
L15	N31°03'05"W	33.35'
L16	N29°56'31"W	34.48'
L17	N10°08'47"E	20.01'
L18	N45°43'04"W	35.04'
L19	N03°49'12"E	31.55'
L20	N71°47'27"W	20.22'

NUMBER	DIRECTION	DISTANCE
L41	N06°00'00"W	26.14'
L42	N09°14'18"W	57.02'
L43	N05°09'41"E	38.11'
L44	N05°09'41"E	14.53'
L45	S08°12'57"E	14.47'
L46	S39°52'33"W	9.68'
L47	S44°05'19"E	13.79'
L48	S57°57'52"E	19.20'
L49	S50°45'05"E	26.36'
L50	S14°45'19"E	16.12'
L51	S36°11'24"E	12.51'
L52	N84°26'22"E	12.98'
L53	S80°14'40"E	20.89'
L54	S23°03'32"E	11.44'
L55	S41°43'11"W	3.03'
L56	S51°22'47"E	4.13'
L57	N59°50'29"E	20.13'
L58	N77°45'37"E	17.94'
L59	S36°50'10"E	8.21'
L60	S30°47'56"W	18.61'

NUMBER	DIRECTION	DISTANCE
L61	S25°58'35"E	12.19'
L62	S10°50'30"W	29.50'
L63	S06°28'16"E	7.70'
L64	S59°29'52"E	23.14'
L65	N82°46'12"E	6.19'
L66	N45°53'43"E	16.36'
L67	N65°20'28"E	26.33'
L68	N81°44'05"E	12.57'
L69	S80°13'30"E	6.05'
L70	S89°43'24"E	19.55'
L71	S01°38'27"W	7.82'
L72	S13°56'24"W	18.03'
L73	S66°08'15"E	17.63'