

Environmental Services - Water Quality
Onsite Wastewater Scan Data Entry Form

PERMIT #: D011110

PIN #: 0781463629

OP DATE: 01/22/1999

SYSTEM USE:

- ☒ House
☐ Mobile Home
☐ Business
☐ Other

SEWAGE TYPE:

- ☒ Domestic
☐ Industrial

PUMP/SIPHON?:

- ☐ Yes
☒ No

PRESSURE MANIFOLD:

- ☐ Yes
☒ No

SYSTEM TYPE:

- ☐ I
☒ II
☐ III
☐ IV
☐ V
☐ VI
☐ Other

SUB TYPE:

- ☒ A
☐ B
☐ C
☐ D
☐ E
☐ F
☐ G

NBR BEDROOMS:

- ☐ 1
☐ 2
☐ 3
☒ 4
☐ 5
☐ 6
☐ Other

MAINT. SCHEDULE:

- ☐ Yes
☒ No

CERT. OPERATOR

- ☐ Yes
☒ No

GT ST PT SIZE

- | | | | |
|-------------------------------------|-------------------------------------|-------------------------------------|------------------|
| ☐ | ☐ | | 750 |
| ☐ | ☐ | ☐ | 900 |
| ☐ | ☐ | ☐ | 1,000 |
| ☐ | ☒ | ☐ | 1,200 |
| ☐ | ☐ | ☐ | 1,500 |
| ☐ | ☐ | ☐ | 1,800 |
| ☐ | ☐ | ☐ | 2,100 |
| ☐ | ☐ | ☐ | 2,500 |
| ☐ | ☐ | ☐ | 3,000 |
| ☐ | ☐ | ☐ | 4,000 |
| ☐ | ☐ | ☐ | 5,000 |
| ☐ | ☐ | ☐ | 8,000 |
| ☐ | ☐ | ☐ | 10,000 |
| ☐ | ☐ | ☐ | Other |
| ☒ | | ☒ | None/NA GT or PT |

DRAINFIELD SIZE(SQ. FT.)

01375

DRAIN TYPE:

- ☒ Stone
☐ EZ Flow
☐ Infiltrator
☐ Biodiffuser
☐ Cultec
☐ Drip
☐ Hancor
☐ Large Dia. Pipe
☐ Multi-Pipe
☐ Other

MAX DEPTH (IN.):

- ☐ 12 in. or less
☐ 18 in. or less
☒ 24 in. or less
☐ 26 in. or less
☐ 28 in. or less
☐ 30 in. or less
☐ 32 in. or less
☐ 36 in. or less
☐ Other

STONE DEPTH (IN.):

- ☐ 8 in. or less
☒ 12 in. or less
☐ 18 in. or less
☐ 24 in. or less
☐ Other

TRENCHES:

- ☒ Individual
☐ Bed

TRENCH WIDTH (IN.):

- ☐ 12 in. or less
☐ 18 in.
☐ 24 in.
☒ 36 in.
☐ 6 ft. or less
☐ 9 ft. or less
☐ Other

WAKE COUNTY DEPARTMENT OF ENVIRONMENTAL SERVICES WELL AND SEWAGE SITE LOCATION PERMIT

NO PERMIT(S) FOR CONSTRUCTION, LOCATION OR RELOCATION ACTIVITY SHALL BE ISSUED

UNTIL AN AUTHORIZATION FOR WASTEWATER SYSTEM CONSTRUCTION HAS BEEN ISSUED

PERMIT VOID IF NOT IN COMPLIANCE WITH ZONING REGULATIONS AND/ OR IF SITE IS ALTERED OR INTENDED USE CHANGED

PERMIT#: D011110 STATUS: A APP DATE: 07/02/1998 BLDG PERMIT#: 0990039

APPLICANT: PINNACLE HOMES

DAY PHONE: (919) 851 - 4366

ADDRESS: 5644 PINE DR

FAX#: (919) 852 - 1615

CITY: RALEIGH

STATE: NC ZIP: 27606

OWNER: PERRY & MOOREFIELD PARTNE

DAY PHONE: (919) 999 - 9999

ADDRESS: 3504 LAKE WHEELER RD

FAX#: (919) 999 - 9999

CITY: RALEIGH

STATE: NC ZIP: 27603

HD USE CD: 101 ONE-FAMILY HOUSE

ORIG PERMIT#:

REC?: Y

EXIST USE:

TAX MAP#: 0653

BEDROOMS: 4 BSMT: N #EMPLOYEES: 0 WATER: C WASTEWATER: I GARB DISPOS: N

TOWNSHIP: 18 SWIFT CREEK JURIS: WC ZON: R40W PIN: 0781.01 46 3629 000

SUBD#: S 000 000 00 SUBD NAME: OLD SOUTH TRACE LOT-SEC: 30 ACRE: 0.92

IMPRV PRMT: ISSUED?: Y DATE: 08211998 BY: DRP TYPE SYSTEM: II PUMP:

CNSTR AUTH: ISSUED?: Y DATE: 08211998 BY: DRP DATE EXPIRED: 08212003

RECEIPT#: FEE: 145.00 OP DATE: BY:

WATR SAMPL: REQ?: N APPROVED?: DATE: PROPRIETARY SYS:

ST#: 2101 MI: DIR: NAME: CHICORA WOOD

DIR: TYP: DR

DIRECTIONS: GO LK WHEELER RD-RIGHT SR1379-RIGHT SR1382-SUB

DIV ON LEFT

IMPROVEMENT PERMIT

SIZE OF TANK 1200 ST PT GALS. TOTAL SQ. FT. 1375 DEPTH OF STONE 12 IN. MAX. DEPTH LINE 24 IN.

WASTEWATER: DOMESTIC ☒ INDUSTRIAL ☐

I.P. ISSUED BY

Dave Parnell

AUTHORIZATION FOR WASTEWATER SYSTEM CONSTRUCTION

VOID SIXTY (60) MONTHS FROM DATE OF ISSUANCE

AUTHORIZATION CONDITIONS

Contractor To Follow Contours, See Attached Site Plan For Wastewater System Design And Well Location. The wastewater system shall not be covered or placed into use until inspected by the Wake County Department of Environmental Services and an Operation Permit issued.

OTHER CONDITIONS:

SIZE OF TANK 1200 ST PT GALS. TOTAL SQ. FT. 1375 DEPTH OF STONE 12 IN. MAX. DEPTH LINE 24 IN.

ST FILTER REQUIRED ☒ NUMBER OF TRENCHES 4 LENGTH OF TRENCHES 115 FT. WIDTH OF TRENCHES 3 FT.

C.A. ISSUED BY

Dave Parnell

INSTALLED BY

Tom Kent

CTR. I.D. #

SEPTIC TANK FILTER USED Y

INNOV. APPRL. #: IWWS-

DATE 1-22-99

INSTALLATION APPROVED BY

[Signature]

WELL SYSTEM = PRIVATE ☐ SEMI-PUBLIC ☐ NEW ☐ REPLACEMENT ☐ EXISTING ☐

WELL LOG INFORMATION = DEPTH CASING DEPTH YIELD STATIC LEVEL

WELL CONTRACTOR REG.# PUMP CONTRACTOR REG.#

CONSTRUCTION COMPLIANCE = GROUT APPROVED ☐

DATE

EHS

WCHD ID #

WELLHEAD APPROVED ☐

DATE

EHS

NEGATIVE BACTERIOLOGICAL RESULTS ☐

DATE

EHS

SYSTEM FINALIZED ☐

DATE

EHS

COMMENTS:

This permit is based in part on information provided by the homeowner or his/her representative in the application submitted for this permit. The Environmental Health Specialist is not responsible for false or misleading information contained in the application. The Environmental Health Specialist is also not responsible for concealed conditions on the property or for statements in this report that may have resulted from false or misleading statements provided to him in the application. Neither Wake County nor the Environmental Health Specialist warrants that the septic tank system will continue to function satisfactorily in the future or that the water supply will remain potable.


Revised 8/3/98

Permit # 0990039

Env. Hth. # 11110

0990039
D-11110

PROPOSED PLOT PLAN FOR
PINNACLE HOMES
LOT 30, OLDE SOUTH TRACE
BOOK OF MAPS 1994, PAGE 1736
2101 CHICORA WOOD DRIVE
SWIFT CREEK TOWNSHIP
WAKE COUNTY, NORTH CAROLINA

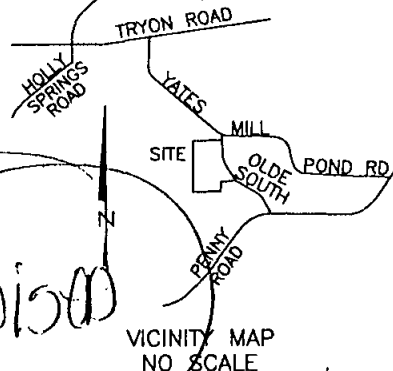

S 88°49'27" W

207.56'


PUMP 30' from
REPAIR

(30)
0.921 AC.

S 25°06'46" E 125.18'

OLDE SOUTH ROAD SR1382
60' PUBLIC R/W

DRIVEWAY ACCESS TO SR 1382
S 25°48'40" E 132.18'

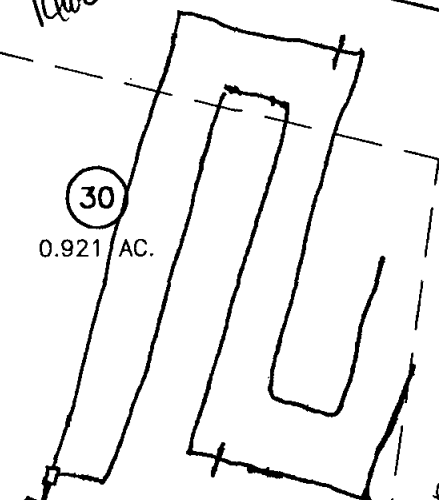

VICINITY MAP
NO SCALE

B.M. 1994, PG. 1736

MIN. BLDG. SETBACKS
(per RESTRICTIONS)
50' FRONT
15' SIDE
25' CORNER SIDE

$\Delta=08^{\circ}37'44''$
R=175.00'
L=26.36'
N79°13'04"E
C=26.33'

$\Delta=81^{\circ}17'09''$
R=25.00'
L=35.47'
S64°27'14"E
C=32.57'

N 74°54'12" E 74.83'

N 06°36'58" W

229.70'

156.10'

17.7'

PROPOSED
HOUSE
LOCATION

CANT.

CANT.

54.0'

CHICORA WOOD DRIVE
50' PUBLIC R/W

2101

I certify that the location of planned or existing structure(s) are accurately shown. I understand failure to locate structures in accordance with this plot plan may require the relocation of structure(s) regardless degree of completion. I hereby grant permission to Municipal/County Representatives the right of entry to make evaluations or inspections upon this property.

X *Wade Mack* 8-398
Signature of Owner or Authorized Agent


THIS PROPERTY ☐ IS ☒ IS NOT LOCATED IN A
F.E.M.A. 100 YEAR FLOOD HAZARD AREA.
REFERENCE: F.I.R.M. PANEL NO. 37183C0520 E (3-3-92)

THOMPSON & ASSOCIATES, P.A.
5821 HOLLY SPRINGS ROAD
RALEIGH, NC 27606
TEL. 919 851-1709 FAX 919 859-2143

DATE 07/02/98 REV. 07/21/98 SURVEYED
SCALE 1"=40' DRAWN CWR

NOT FOR PINNING
DRAWN FROM FIRST FLOOR PLAN

PRELIMINARY PLAT
not for recording, sales, or conveyances

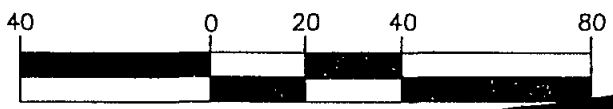

DRAWING

R40W

CEI

8-398
101

30
15

30
30

SFD relocated