

Environmental Services - Water Quality
Onsite Wastewater Scan Data Entry Form

PERMIT #: 0033759

PIN #: 0665656272

OP DATE: 0911312006

SYSTEM USE:

- ☒ House
☐ Mobile Home
☐ Business
☐ Other

SEWAGE TYPE:

- ☒ Domestic
☐ Industrial

PUMP/SIPHON?:

- ☐ Yes
☒ No

PRESSURE MANIFOLD:

- ☐ Yes
☒ No

SYSTEM TYPE:

- ☐ I
☐ II
☒ III
☐ IV
☐ V
☐ VI
☐ Other

SUB TYPE:

- ☐ A
☐ B
☐ C
☐ D
☐ E
☐ F
☒ G

NBR BEDROOMS:

- ☐ 1
☐ 2
☒ 3
☐ 4
☐ 5
☐ 6
☐ Other

MAINT. SCHEDULE:

- ☐ Yes
☒ No

CERT. OPERATOR

- ☐ Yes
☒ No

GT	ST	PT	SIZE
☐	☐		750
☐	☐	☐	900
☐	☒	☐	1,000
☐	☐	☐	1,200
☐	☐	☐	1,500
☐	☐	☐	1,800
☐	☐	☐	2,100
☐	☐	☐	2,500
☐	☐	☐	3,000
☐	☐	☐	4,000
☐	☐	☐	5,000
☐	☐	☐	8,000
☐	☐	☐	10,000
☐	☐	☐	Other
☒		☒	None/NA GT or PT

DRAINFIELD SIZE(SQ. FT.)

01080

DRAIN TYPE:

- ☐ Stone
☐ EZ Flow
☒ Infiltrator
☐ Biodiffuser
☐ Cultec
☐ Drip
☐ Hancor
☐ Large Dia. Pipe
☐ Multi-Pipe
☐ Other

MAX DEPTH (IN.):

- ☐ 12 in. or less
☐ 18 in. or less
☒ 24 in. or less
☐ 26 in. or less
☐ 28 in. or less
☐ 30 in. or less
☐ 32 in. or less
☐ 36 in. or less
☐ Other

STONE DEPTH (IN.):

- ☐ 8 in. or less
☒ 12 in. or less
☐ 18 in. or less
☐ 24 in. or less
☒ Other

TRENCHES:

- ☒ Individual
☐ Bed

TRENCH WIDTH (IN.):

- ☐ 12 in. or less
☐ 18 in.
☐ 24 in.
☒ 36 in.
☐ 6 ft. or less
☐ 9 ft. or less
☐ Other

WAKE COUNTY DEPARTMENT OF ENVIRONMENTAL SERVICES WELL AND SEWAGE SITE LOCATION PERMIT
NO PERMIT(S) FOR CONSTRUCTION, LOCATION OR RELOCATION ACTIVITY SHALL BE ISSUED
UNTIL AN AUTHORIZATION FOR WASTEWATER SYSTEM CONSTRUCTION HAS BEEN ISSUED
PERMIT VOID IF NOT IN COMPLIANCE WITH ZONING REGULATIONS AND/ OR IF SITE IS ALTERED OR INTENDED USE CHANGED

PERMIT#: D033759 STATUS: A APP. DATE: 05/10/2005 BLDG. PERMIT#: 0053711
PIN: 0665.02 65 6272 000 TAX MAP: 0877 0000 RECORDED: Y ORIG. PERMIT#:
TOWNSHIP: 12 MIDDLE CREEK JURISDICTION: WC ZONING: R30
APPLICANT: W CHASE HOMES, INC
238 FOX WALK PATH
GARNER, NC 27529
(919) 427 - 0627
USE: HD USE: 101 ONE-FAMILY HOUSE
EXIST USE:
DISPOSAL: BEDROOMS: 3 BASEMENT: N #EMPLOYEES: 0
SITE: ADDRESS: 9008 ASPEN GLEN CT
SUBDIVISION: BEDFORD FOREST LOT: 15 ACRES: 0.72
DIRECTION: 401S, TL PURFOY, S/D ON LEFT

Well System: WATER: INDIVIDUAL - TYPE: NEW

WELL LOG INFORMATION: DEPTH: 200 CASING DEPTH: 115 YIELD: 15 STATIC LEVEL: 30
WELLI CONTRACTOR: Rogers, Jack # 046 PUMP CONTRACTOR: DATE: 4/27/06 EHS: 5175
Construction Compliance GROUT APPROVED ☒ DATE: 7/27/06 EHS:
WELLHEAD APPROVED ☒ DATE: 7/31/06 EHS:
SYSTEM FINALIZED ☒ DATE: 7/31/06 EHS:

COMMENTS:

Operation Permit

DESIGN FLOW: gal./min. ACTUAL FLOW: INNOVATIVE LETTER:
INSTALLED BY: Theron Plumbins INSTALLATION APPROVED BY:
PROPRIETARY SYSTEM: FILTER NO: PL 68
COMMENTS:

OPERATIONS PERMIT ISSUED? Y OP DATE: 9-13-06 BY: CWF

This permit is based in part on information provided by the homeowner or his/her representative in the application submitted for this permit. The Environmental Health Specialist is not responsible for false or misleading information contained in the application. The Environmental Health Specialist is also not responsible for concealed conditions on the property or for statements in this report that may have resulted from false or misleading statements provided to him in the application. Neither Wake County nor the Environmental Health Specialist warrants that the septic tank system will continue to function satisfactorily in the future or that the water supply will remain potable.

As Built Information:

Date: 9-13-06 Benchmark: Rod reading: Distance to Structure: >100'
ST: 1000 gals ID#: STB 811 D.O.M.: 7-25-06 Elev.: 7'8" Distance to Well:
PT: gals ID#: D.O.M.: Elev.:
D-box/FD/PM elev.: 8'8" Supply Line: 33 ft. Pump/Control Panel:
Line 1: 9'6" Date: 9-13-06
Line 2: 9'10" Date:
Line 3: 9'10" Date:
Line 4: Date:
Line 5: Date:
Distance to P/L: Notes:

WAKE COUNTY DEPARTMENT OF ENVIRONMENTAL SERVICES WELL AND SEWAGE SITE LOCATION PERMIT
NO PERMIT(S) FOR CONSTRUCTION, LOCATION OR RELOCATION ACTIVITY SHALL BE ISSUED
UNTIL AN AUTHORIZATION FOR WASTEWATER SYSTEM CONSTRUCTION HAS BEEN ISSUED


PERMIT VOID IF NOT IN COMPLIANCE WITH ZONING REGULATIONS AND/ OR IF SITE IS ALTERED OR INTENDED USE CHANGED

PERMIT#: D033759 STATUS: A APP. DATE: 05/10/2005 BLDG. PERMIT#: 0053711
PIN: 0665.02 65 6272 000 TAX MAP: 0877 0000 RECORDED: Y ORIG. PERMIT#:
TOWNSHIP: 12 MIDDLE CREEK JURISDICTION: WC ZONING: R30
APPLICANT: W CHASE HOMES, INC
238 FOX WALK PATH
GARNER, NC 27529
(919) 427 - 0627
USE: HD USE: 101 ONE-FAMILY HOUSE
EXIST USE:
DISPOSAL: BEDROOMS: 3 BASEMENT: N #EMPLOYEES: 0 FOUND DRAIN:
SITE: ADDRESS: 9008 ASPEN GLEN CT
SUBDIVISION: BEDFORD FOREST LOT: 15 ACRES: 0.72
DIRECTION: 401S, TL PURFOY, S/D ON LEFT

IMPROVEMENT PERMIT

TANK SIZE: 1000 gal. PUMP Tank: ~~4000~~ gal. SQ FT: 1080 STONE DEPTH: ~~12~~ in. MAX DEPTH LINE: 24 in.
WASTEWATER: INDIVIDUAL SEWAGE: DOMESTIC TYPE SYSTEM: III ~~36~~ PUMP: Y P/M: N
DAILY FLOW: 360 gal/day DESIGN FEE REQ?: PAID?: WATER: INDIVIDUAL

COMMENTS:

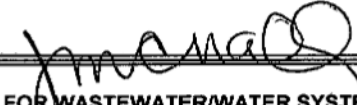
IP ISSUED? Y DATE: 07/28/2005 BY: (JEM)  PHONE#: 868-6410

AUTHORIZATION FOR WASTEWATER/WATER SYSTEM CONSTRUCTION
VOID SIXTY (60) MONTHS FROM DATE OF ISSUANCE
AUTHORIZATION CONDITIONS:

Contractors shall install system on contours, see attached site plan for wastewater system design and well location. No underground utilities, water lines or sprinkler systems may be located in the original system or repair areas. A septic tank filter with a riser for access is required. The wastewater system shall not be covered or placed into use until inspected by the Wake County Department of Environmental Services and an Operation Permit issued. An Accepted Status System may be used in place of conventional system, if it can be placed in the permitted/authorized trench footprint (except reduction in line length and/or number as allowed for in approval) and the installation is in accordance with the accepted system approval, without unauthorized product alteration. If permit required use of an Accepted Status System, substitution with another accepted status system may be made, as long as no changes are necessary in the location of each nitrification line (including any increase in line length), trench depth or effluent distribution method. If changes are necessary, prior approval by this office is required before system installation. OTHER CONDITIONS:

INSTALL LINES ON CONTOUR. MAINTAIN ALL SETBACKS. IF SITE OR SITE PLAN CHANGES, PERMIT IS VOID. DO NOT GRADE OR REMOVE ANY SOIL FROM SEPTIC SYSTEM OR REPAIR AREA. TAKE CARE NOT TO INSTALL UTILITIES OR IRRIGATION SYSTEM OVER SEPTIC SYSTEM OR REPAIR AREA. CALL PRIOR TO INSTALLATION WITH ANY QUESTIONS, COMMENTS OR CONCERNS.

TANK SIZE: 1000 gal. PUMP TANK: ~~4000~~ gal. SQ FT: 1080 STONE DEPTH: ~~12~~ in. MAX DEPTH LINE: 24 in.
MAINT: N OPER: N L/O: Y TRENCH#: 3 LENGTH: 120 ft. WIDTH: 36 in. DESIGNER:
SUBFIELDS: _ DESIGN HEAD PRESSURE: _ DESIGN FLOW: _ gal/min DOSE VOLUME: _ gal.

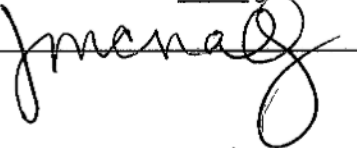CA ISSUED? Y DATE: 07/28/2005 BY: (JEM)  PHONE#: 868-6410

As Built

PROPOSED PLOT PLAN
FOR
W. CHASE HOMES INC.
LOT 15
BEDFORD FOREST
MIDDLE CREEK TOWNSHIP
WAKE COUNTY
NORTH CAROLINA
PIN # 0665656272

0053711
D33759


Pin# 0665 02 65 6272

I certify that the location of planned or existing structure(s) are accurately shown. I understand failure to locate structures in accordance with this plot plan may require the relocation of structure(s) regardless of degree of completion. I hereby grant permission to Municipal/County representatives the right of entry to make evaluations or inspections upon this property.

Elizabeth G. Smith
Signature of Owner or Authorized Agent

WATER PROTECTION ZONE

Zoning P-30 By CHL
Approve V Date 5.1.05
Revise 101
Reject MBL
Front 30 Rear 30
Side 10 Corner 30
Comments:

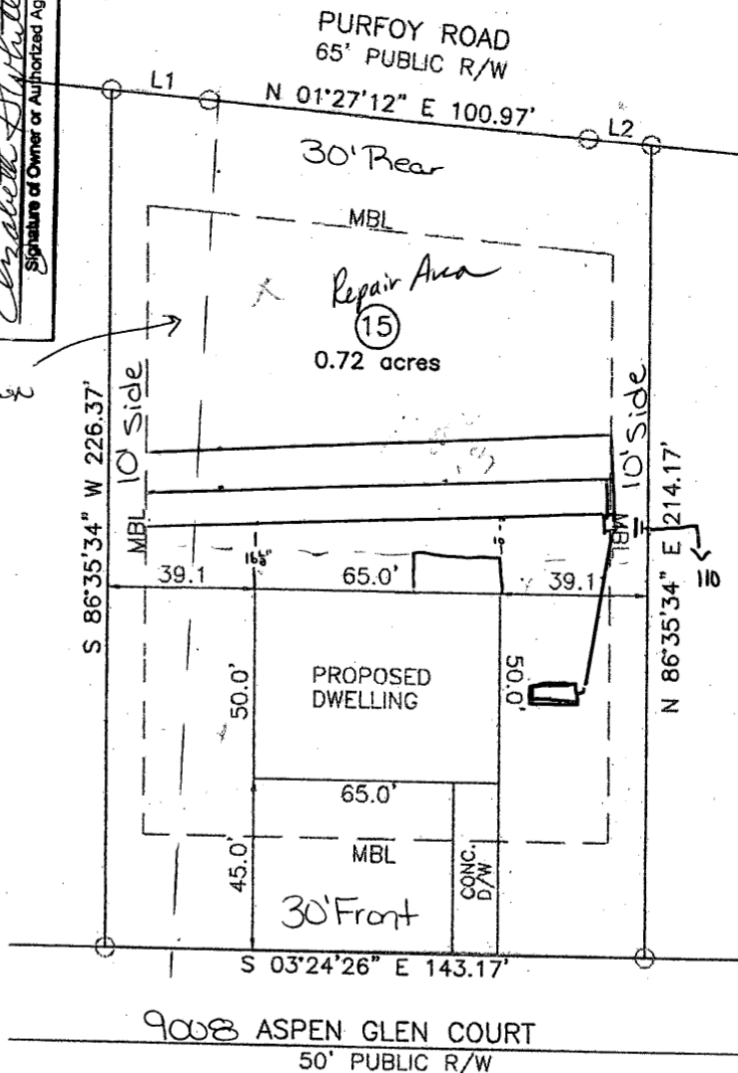

9008 ASPEN GLEN COURT
50' PUBLIC R/W

LINE TABLE		
LINE	BEARING	DIST
L1	S01°29'37\"W	25.96
L2	S01°28'27\"W	16.76

THIS PROPERTY ☐ IS ☐ IS NOT LOCATED IN A
F.E.M.A. 100 YEAR FLOOD HAZARD AREA.
REFERENCE: F.E.M.A. COMMUNITY PANEL NO.


STEWART-PROCTOR
ENGINEERING and SURVEYING
319 CHAPANOKE RD. SUITE 106
RALEIGH, NC 27603
TEL 919 779-1855 FAX 919 779-1661

DATE 04/14/05 SURVEYED N/A



PROPOSED IMPERVIOUS SURFACE AREAS	
FOUNDATION	3,250 s.f.
CONCRETE DRIVEWAY	950 s.f.
IMPERVIOUS	4,200 s.f.
MAXIMUM IMPERVIOUS ALLOWED = 5,190 s.f.	

GRAPHIC SCALE

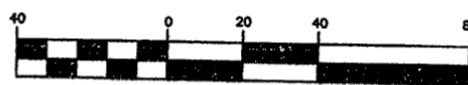

(IN FEET)

DRAWING

PROPOSED PLOT PLAN
FOR
W. CHASE HOMES INC.
LOT 15
BEDFORD FOREST
MIDDLE CREEK TOWNSHIP
WAKE COUNTY
NORTH CAROLINA
PIN # 0665656272

0053711
D33759


Pin# 0665 02 65 6272

I certify that the location of planned or existing structure(s) are accurately shown. I understand failure to locate structures in accordance with this plot plan may require the relocation of structure(s) regardless degree of completion. I hereby grant permission to Municipal/County representatives the right of entry to make evaluations or inspections upon this property.

Charlotte G. Gentry
Signature of Owner or Authorized Agent

WATER PROTECTION ZONE

Zoning: R30 By: CHL
Approve: ☒ Date: 5.1.05
Revise: ☐ Use: 101
Reject: ☐ MBL
Front: 30 Rear: 30
Side: 10 Corner:
Comments:

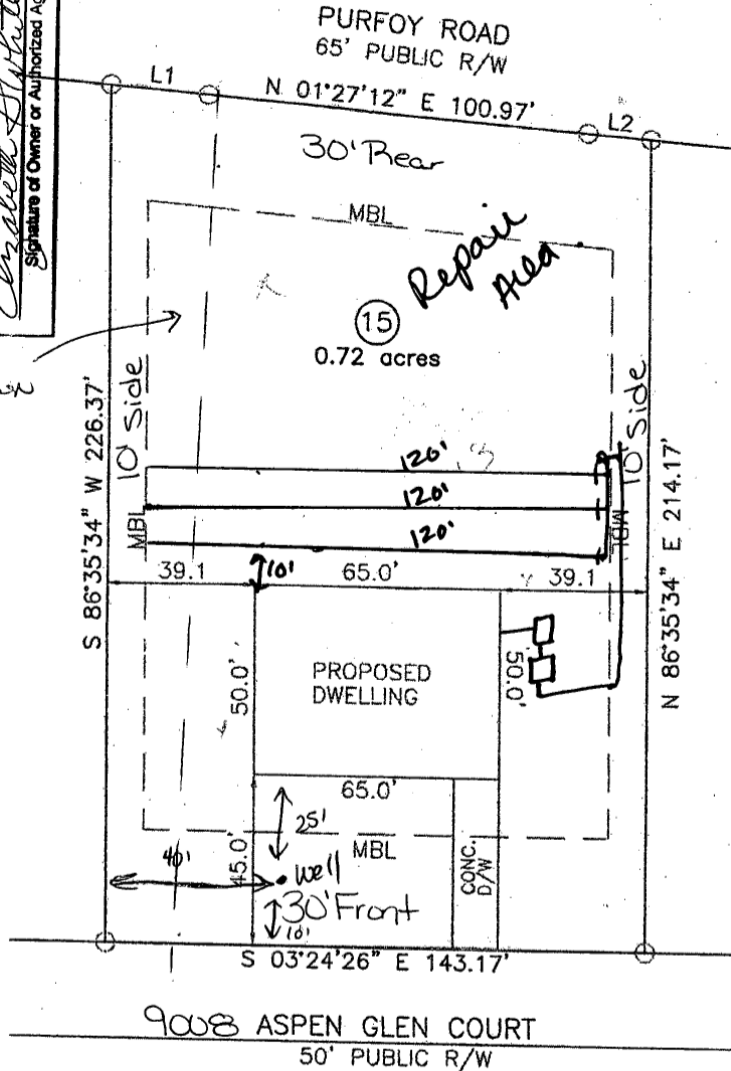

LINE TABLE		
LINE	BEARING	DIST
L1	S01°29'37"W	25.96
L2	S01°28'27"W	16.76

THIS PROPERTY ☐ IS ☐ IS NOT LOCATED IN A
F.E.M.A. 100 YEAR FLOOD HAZARD AREA.
REFERENCE: F.E.M.A. COMMUNITY PANEL NO. _____

STEWART-PROCTOR
ENGINEERING and SURVEYING
319 CHAPANOKE RD. SUITE 106
RALEIGH, NC 27603
TEL: 919 779-1855 FAX 919 779-1661


DATE 04/14/05 SURVEYED N/A



PROPOSED IMPERVIOUS SURFACE AREAS
FOUNDATION 3,250 s.f.
CONCRETE DRIVEWAY 950 s.f.
IMPERVIOUS 4,200 s.f.

MAXIMUM IMPERVIOUS ALLOWED = 5,190 s.f.

GRAPHIC SCALE

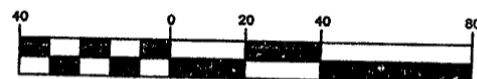

(IN FEET)

DRAWING