

Environmental Services - Water Quality
Onsite Wastewater Scan Data Entry Form

PERMIT #: **D 0 5 0 7 2 1**

PIN #: **1 8 1 2 7 2 1 7 5 5**

OP DATE: **1 2 / 1 2 / 2 0 1 6**

SYSTEM USE:

- ☒ House
☐ Mobile Home
☐ Business
☐ Other

SEWAGE TYPE:

- ☒ Domestic
☐ Industrial

PUMP/SIPHON?:

- ☐ Yes
☒ No

PRESSURE MANIFOLD:

- ☐ Yes
☒ No

SYSTEM TYPE:

- ☐ I
☒ II
☐ III
☐ IV
☐ V
☐ VI
☐ Other

SUB TYPE:

- ☒ A
☐ B
☐ C
☐ D
☐ E
☐ F
☐ G

NBR BEDROOMS:

- ☐ 1
☐ 2
☐ 3
☒ 4
☐ 5
☐ 6
☐ Other

MAINT. SCHEDULE:

- ☐ Yes
☒ No

CERT. OPERATOR

- ☐ Yes
☒ No

GT ST PT SIZE

- | | | | |
|-------------------------------------|-------------------------------------|-------------------------------------|------------------|
| ☐ | ☐ | | 750 |
| ☐ | ☐ | ☐ | 900 |
| ☐ | ☐ | ☐ | 1,000 |
| ☐ | ☒ | ☐ | 1,200 |
| ☐ | ☐ | ☐ | 1,500 |
| ☐ | ☐ | ☐ | 1,800 |
| ☐ | ☐ | ☐ | 2,100 |
| ☐ | ☐ | ☐ | 2,500 |
| ☐ | ☐ | ☐ | 3,000 |
| ☐ | ☐ | ☐ | 4,000 |
| ☐ | ☐ | ☐ | 5,000 |
| ☐ | ☐ | ☐ | 8,000 |
| ☐ | ☐ | ☐ | 10,000 |
| ☐ | ☐ | ☐ | Other |
| ☒ | | ☒ | None/NA GT or PT |

DRAINFIELD SIZE(SQ. FT.)

0 1 2 0 0

DRAIN TYPE:

- ☐ Stone
☒ EZ Flow
☐ Infiltrator
☐ Biodiffuser
☐ Cultec
☐ Drip
☐ Hancor
☐ Large Dia. Pipe
☐ Multi-Pipe
☐ Other

MAX DEPTH (IN.):

- ☐ 12 in. or less
☐ 18 in. or less
☒ 24 in. or less
☐ 26 in. or less
☐ 28 in. or less
☐ 30 in. or less
☐ 32 in. or less
☐ 36 in. or less
☐ Other

STONE DEPTH (IN.):

- ☐ 8 in. or less
☒ 12 in. or less
☐ 18 in. or less
☐ 24 in. or less
☐ Other

TRENCHES:

- ☒ Individual
☐ Bed

TRENCH WIDTH (IN.):

- ☐ 12 in. or less
☐ 18 in.
☐ 24 in.
☒ 36 in.
☐ 6 ft. or less
☐ 9 ft. or less
☐ Other

MYB

WAKE COUNTY DEPARTMENT OF ENVIRONMENTAL SERVICES WELL AND SEWAGE SITE LOCATION PERMIT

NO PERMIT(S) FOR CONSTRUCTION, LOCATION OR RELOCATION ACTIVITY SHALL BE ISSUED
UNTIL AN AUTHORIZATION FOR WASTEWATER SYSTEM CONSTRUCTION HAS BEEN ISSUED

PERMIT VOID IF NOT IN COMPLIANCE WITH ZONING REGULATIONS AND/ OR IF SITE IS ALTERED OR INTENDED USE CHANGED

PERMIT#: D050721 STATUS: A APP. DATE: 03/10/2014 BLDG. PERMIT#: 0164167
PIN: 1812 72 1755 000 TAX MAP: 0 RECORDED: Y ORIG. PERMIT#:
TOWNSHIP: 14 NEW LIGHT JURISDICTION: WC ZONING: R40W SW DEVICE: N S#:
APPLICANT: SAVVY HOMES (919) 781 - 8104
8025 CREEDMOOR RD STE 100 RALEIGH, NC 27613
USE: HD USE: 101A CONVENTIONAL ONE-FAMILY HOUSE EXIST USE:
LTAR: 0.30 0.30 BEDROOMS: 4 BASEMENT: N #EMPLOYEES: 0
SITE: ADDRESS: 1108 HARRISON RIDGE RD
SUBDIVISION: BEAU PRE@ STON LOT: 10 ACRES: 0.69 EASEMENT: N LOC: SYS:
DIRECTION: 98E TO 98W TL 98 BYPASS TR STONYHILL TL S/D

Well System: WATER: COMMUNITY - TYPE:

WELL LOG INFORMATION: DEPTH: _____ CASING DEPTH: _____ YIELD: _____ STATIC LEVEL: _____
WELL CONTRACTOR: _____ REG.# _____ PUMP CONTRACTOR: _____ REG.# _____
Construction Compliance GROUT APPROVED ☐ DATE _____ EHS _____
WELLHEAD APPROVED ☐ DATE _____ EHS _____
SYSTEM FINALIZED ☐ DATE _____ EHS _____

COMMENTS:

Operation Permit

DESIGN FLOW: _____ gal./min. ACTUAL FLOW: _____ DOSE VOLUME: _____ gal. INNOVATIVE LETTER: _____
INSTALLED BY: James w/ Adcock INSTALLATION APPROVED BY: [Signature]
PROPRIETARY SYSTEM: EZ1203HG TYPE SYSTEM: II A

COMMENTS:

OPERATIONS PERMIT ISSUED? Y OP DATE: 12/12/16 BY: [Signature]

Systems defined as either a Type IIIb, IIIg with a pump, IV, V or VI, in accordance with the North Carolina Administrative Code 15A NCAC 18A .1961, Table V as adopted by reference in the "Regulations Governing Wastewater Treatment and Dispersal Systems in Wake County", require Wake County Environmental Services to conduct periodic inspections on this type system, pursuant to 15A NCAC 18A .1961 (j). Fees for these inspections will be charged as per the approved Fee Schedule. In addition, all systems are to be operated and maintained as specified in 15A NCAC 18A .1961. This permit is based in part on information provided by the homeowner or his/her representative in the application submitted for this permit. The Environmental Health Specialist is not responsible for false or misleading information contained in the application. The Environmental Health Specialist is also not responsible for concealed conditions on the property or for statements in this report that may have resulted from false or misleading statements provided to him in the application. Neither Wake County nor the Environmental Health Specialist warrants that the septic tank system will continue to function satisfactorily in the future or that the water supply will remain potable.

As Built Information:

Date: 12/12/16 Benchmark: ST Rod reading: 3.5 1/2 Distance to Structure: 15' ST
ST: 1250 gals ID#: MCP-38 D.O.M.: 6-19-16 Elev.: 3.5 1/2 Distance to Well: N/A
PT: _____ gals ID#: _____ D.O.M.: _____ Elev.: _____ Distance to P/L: 11' ST
GT: _____ gals ID#: _____ D.O.M.: _____ Elev.: _____ Pretreatment: N/A
D-box/PD/PM elev.: 4' Supply Line: 9 1/2 ft. Pump/Ctrl Panel: _____ Filter: Recl Poly
Line 1: 5.8 1/2 5.8 1/2 Date: 12/12 Line 6: _____ Date: _____
Line 2: 6.3 6.3 Date: _____ Line 7: _____ Date: _____
Line 3: 7.4 1/2 7.4 1/2 Date: _____ Line 8: _____ Date: _____
Line 4: 7.11 7.11 Date: _____ Line 9: _____ Date: _____
Line 5: _____ Date: _____ Line 10: _____ Date: _____
ETM1: _____ CC1: _____ ETM2: _____ CC2: _____ OR: _____ AC: _____ WM: _____

Notes:

WAKE COUNTY DEPARTMENT OF ENVIRONMENTAL SERVICES WELL AND SEWAGE SITE LOCATION PERMIT

NO PERMIT(S) FOR CONSTRUCTION, LOCATION OR RELOCATION ACTIVITY SHALL BE ISSUED
UNTIL AN AUTHORIZATION FOR WASTEWATER SYSTEM CONSTRUCTION HAS BEEN ISSUED

PERMIT VOID IF NOT IN COMPLIANCE WITH ZONING REGULATIONS AND/ OR IF SITE IS ALTERED OR INTENDED USE CHANGED

PERMIT#: D050721 STATUS: A APP. DATE: 03/10/2014 BLDG. PERMIT#: 0164167
PIN: 1812 72 1755 000 TAX MAP: 0 RECORDED: Y ORIG. PERMIT#:
TOWNSHIP: 14 NEW LIGHT JURISDICTION: WC ZONING: R40W SW DEVICE: N S#:
APPLICANT: SAVVY HOMES (919) 781 - 8104
8025 CREEDMOOR RD STE 100 RALEIGH, NC 27613
HD USE: 101A CONVENTIONAL ONE-FAMILY HOUSE EXIST USE: DESIGN FEE REQ?: PAID?:
LTAR: 0.30 0.30 BEDROOMS: 4 BASEMENT: N #EMPLOYEES: 0 FOUNDATION DRAIN: Y
SITE: ADDRESS: 1108 HARRISON RIDGE RD
SUBDIVISION: BEAU PRE@STON LOT: 10 ACRES: 0.69 EASEMENT: N LOC: SYS:
DIRECTION: 98E TO 98W TL 98 BYPASS TR STONYHILL TL SD

IMPROVEMENT PERMIT

[] As per GS 130A-335 (f), Improvement Permit is based on a Site Plan and is void Sixty (60) months from date of issuance.
[X] As per GS 130A-335 (f), Improvement Permit is based on a Plat and is valid without expiration.

Permit is subject to revocation if the site plan or plat, whichever is applicable, or the intended use changes.

TANK SIZE: 1200 gal. PUMP Tank: _____ gal. GREASE TRAP: _____ gal. SQ FT: 1200 ACCEPTED STATUS MAX DEPTH LINE: 24 in.
WASTEWATER: INDIVIDUAL SEWAGE: DOMESTIC TYPE SYSTEM: II A PUMP: N P/M: N LP: TD:
DAILY FLOW: 480 gal/day WATER: COMMUNITY PRETREATMENT: NA FILL: DAF: DEEP: REDUCE35%:

COMMENTS:

IP ISSUED? Y DATE: 04/02/2014 BY: (KGD)  PHONE#: (919)-856-7434


AUTHORIZATION FOR WASTEWATER/WATER SYSTEM CONSTRUCTION
VALIDITY CONCURRENT WITH THE IMPROVEMENT PERMIT


AUTHORIZATION CONDITIONS:

Contractors shall install system on contours, see attached site plan for wastewater system design and well location. No underground utilities, water lines or sprinkler systems may be located in the original system or repair areas. A septic tank filter with a riser for access is required. The wastewater system shall not be covered or placed into use until inspected by the Wake County Department of Environmental Services and an Operation Permit issued. An Accepted Status System may be used in place of conventional system, if it can be placed in the permitted/authorized trench footprint (except reduction in line length and/or number as allowed for in approval) and the installation is in accordance with the accepted system approval, without unauthorized product alteration. If permit required use of an Accepted Status System, substitution with another accepted status system may be made, as long as no changes are necessary in the location of each nitrification line (including any increase in line length), trench depth or effluent distribution method. If changes are necessary, prior approval by this office is required before system installation.

OTHER CONDITIONS: ACCEPTED STATUS SYSTEM REDUCTION ALREADY TAKEN GRAVITY 10FT SETBACK DUE TO FOUNDATION DRAIN
PRESSURE MANIFOLD REPAIR DO NOT GRADE SEPTIC AREA OR REPAIR AREA

TANK SIZE: 1200 gal. PUMP TANK: _____ gal. GREASE TRAP: _____ gal. SQ FT: 1200 ACCEPTED STATUS MAX DEPTH LINE: 24 in.
MAINT: N OPER: N L/O: Y TRENCH#: 4 LENGTH: 100 ft. WIDTH: 36 in. DESIGNER: _____
SUBFIELDS: _____ DESIGN HEAD PRESSURE: _____ gal/min DOSE VOLUME: _____ gal. PRETREATMENT: NA

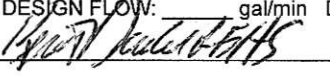
CA ISSUED? Y DATE: 07/06/2016 BY: (KGD)  PHONE#: (919)-856-7434

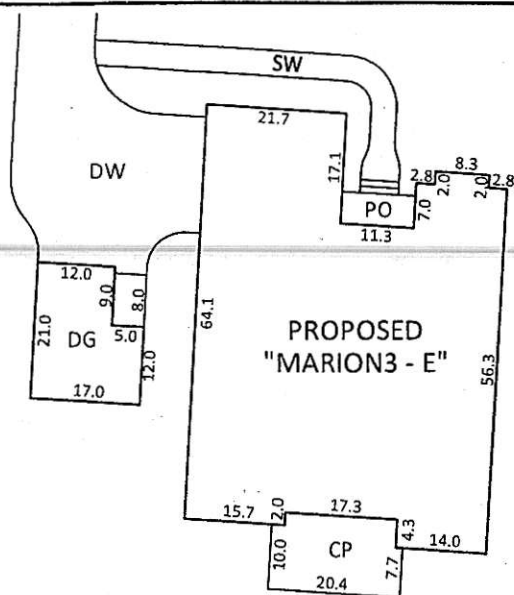

INSET SCALE: 1" = 30'

*As Built
Part 1*

HARRISON RIDGE ROAD PUBLIC 50' R/W

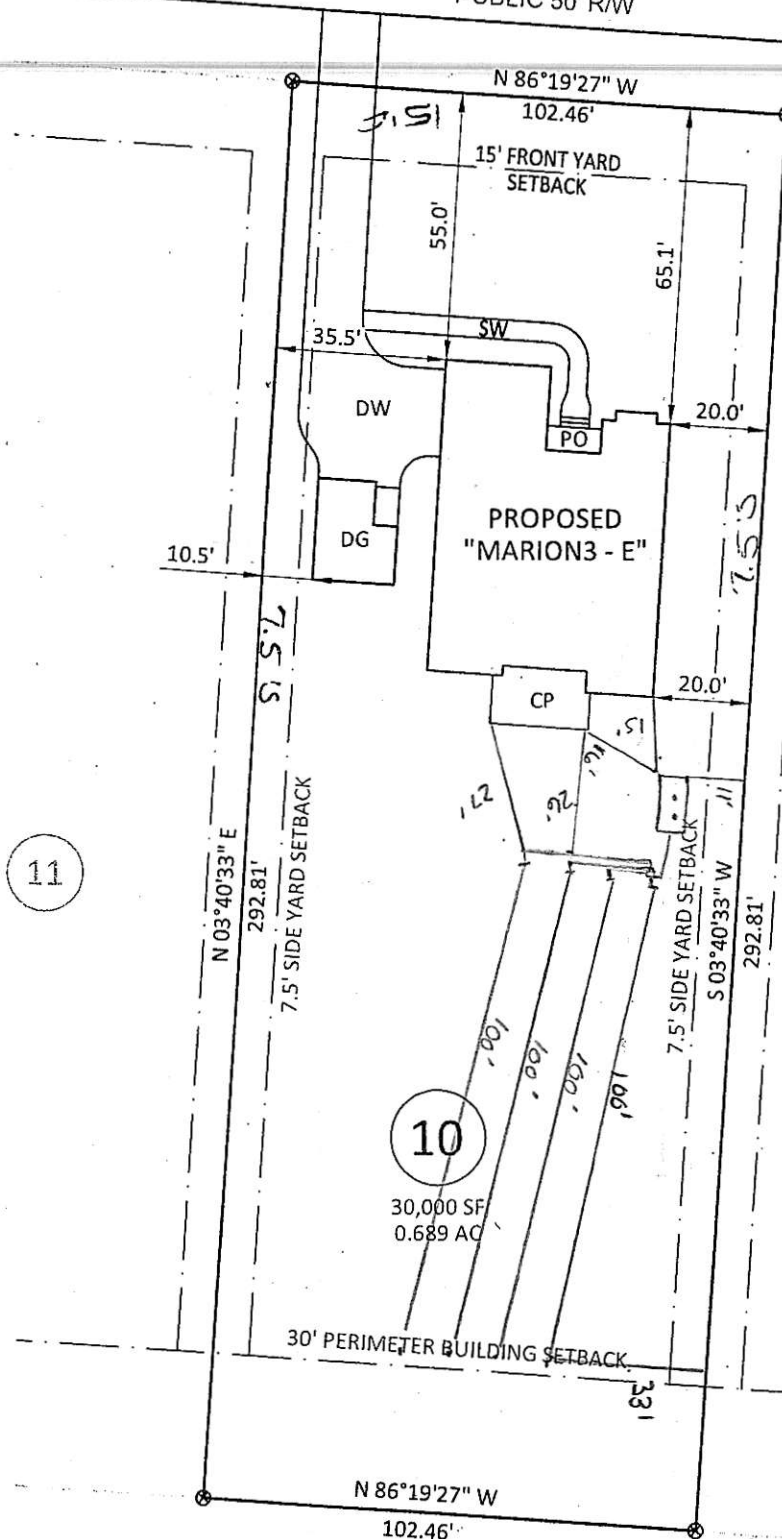

LOT INFORMATION:

LOT #10
DB 015743, PG 01684
PIN: 1812721755
REID: 0347652
ADDRESS: 1108 HARRISON RIDGE ROAD
TOTAL LOT AREA = 0.689 AC = 30,000 SF
MAXIMUM IMPERVIOUS = 5,119 SF
HOUSE = 2,693 SF
DRIVEWAY = 1,356 SF
SIDEWALK = 259 SF
PORCH = 57 SF
COVERED PORCH = 237 SF
DETACHED GARAGE = 352 SF
PROPOSED IMPERVIOUS = 4,954 SF
PERCENT IMPERVIOUS = 16.5 %

Zoning R40W
Approve / Date 10-29-16
Revise / Use 101A
Reject / MBL
Front 15 Rear 15
Side 7.5 Corner /
Comments:


I certify the location of planned or existing structure(s) are accurately shown. I understand failure to locate structures in accordance with this plot plan may require the relocation of structure(s) regardless degree of completion. I hereby grant permission to Municipal/County Representatives the right of entry to make evaluations or inspections upon this property.

Signature of Owner or Authorized Agent


NOTES:

- THIS SURVEY WAS PREPARED BY BATEMAN CIVIL SURVEY CO., UNDER THE SUPERVISION OF STEVEN P. CARSON, PLS.
- THIS PLAN HAS BEEN PREPARED FOR LAYOUT AND PERMITTING PURPOSES ONLY.
- THIS IS NOT A BOUNDARY SURVEY. PROPERTY LINES SHOWN WERE TAKEN FROM EXISTING FIELD EVIDENCE, EXISTING DEEDS AND PLATS OF PUBLIC RECORD, AND INFORMATION SUPPLIED TO THE SURVEYOR BY THE CLIENT
- VERTICAL DATUM IS ASSUMED. THE LATITUDE, LONGITUDE AND STATE PLANE COORDINATES, IF SHOWN, ARE GIVEN IN NORTH AMERICAN DATUM OF 1983 (NAD83).
- FIELD EQUIPMENT USED: NIKON TOTAL STATION, EPOCH 35.
- ALL DISTANCES ARE HORIZONTAL GROUND DISTANCES AND ALL BEARINGS ARE NORTH CAROLINA STATE PLANE COORDINATE SYSTEM UNLESS OTHERWISE SHOWN.
- THIS MAP IS NOT A CERTIFIED SURVEY AND HAS NOT BEEN REVIEWED BY A LOCAL GOVERNMENT AGENCY FOR COMPLIANCE WITH ANY APPLICABLE LAND DEVELOPMENT REGULATIONS.
- THE PROPERTY LIES IN ZONES "X" PER NATIONAL FLOOD INSURANCE PROGRAM FLOOD INSURANCE RATE MAP NUMBER 3720181200J, DATED MAY 2, 2006.
- ZONING IS R-40W.
- PROPERTY OWNER: SAVVY HOMES
8025 CREEDMOOR ROAD
SUITE #100
RALEIGH, NC 27613

BAILEY CLAN INC, THE
D.B. 6205 PG. 0542
PIN # 1812.04-52-8013

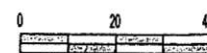

SCALE:
1" = 40 ft.

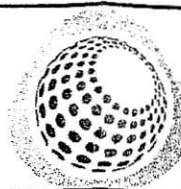


Bateman Civil Survey Company

Engineers • Surveyors • Planners

2524 Reliance Ave., Apex, NC 27539 Ph: 919.577.1080 Fax: 919.577.1081

www.batemancivilsurvey.com info@batemancivilsurvey.com

NCBELS Firm No. C-2378

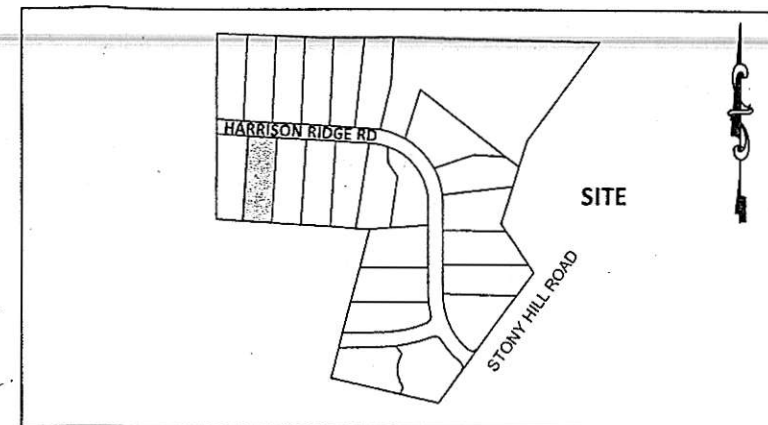

VICINITY MAP

(Not to Scale)

LEGEND

PO = PORCH
CP = COVERED PORCH
P = CONCRETE PATIO
WD = WOOD DECK
SW = SIDEWALK
DW = CONC DRIVEWAY
DG = DETACHED GARAGE
⊗ = CONTROL POINT
⊙ = IRON PIPE FOUND
⊙ = IRON PIPE SET
⊙ = DRILL HOLE FOUND
WM = WATER METER
CO = CLEAN OUT
AC = AIR CONDITIONER
⊙ = SEWER MANHOLE
EB = ELECTRIC BOX
⊙ = CABLE BOX
⊙ = TELEPHONE PEDESTAL
CI = CURB INLET
DG = DETACHED GARAGE
⊙ = LIGHT POLE

I hereby certify that this map is correct and that the building lies wholly on the lot and that there are no visible encroachments on said lot.

Steven P. Carson, PLS 4752
Date

BUILDING SETBACKS:

FRONT = 15 ft
REAR = 15 ft
SIDE = 7.5 ft
PERIMETER = 30 ft

This map is of an existing parcel of land and is only intended for the parties and purposes shown. This map not for recordation. No title report provided.

APPROVAL FOR STAKING:

THIS PLOT PLAN AS PREPARED BY BATEMAN CIVIL SURVEY CO., IS CORRECT AND IS HEREBY APPROVED FOR STAKING ON THE DATE AS SHOWN BELOW.

SAVVY HOMES REPRESENTATIVE

DATE

PRELIMINARY PLOT PLAN - LOT 10

FOR
SAVVY
HOMES
Life Amplified™


BEAU PRE' AT STONY HILL - LOT 10

1108 HARRISON RIDGE ROAD
NEW LIGHT TOWNSHIP, WAKE COUNTY, NC

DATE: 5/2/16 DRAWN BY: JKF CHECKED BY: SPC

REFERENCE: BM 2013, PG 1572

SCALE: 1" = 40'

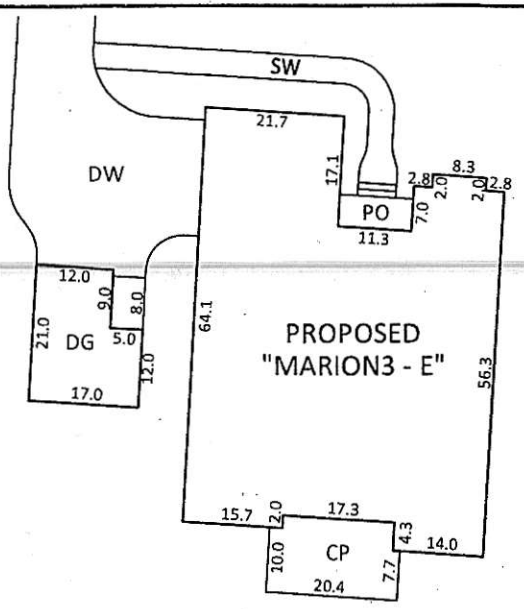


INSET SCALE: 1" = 30'

- NOTES:**
1. THIS SURVEY WAS PREPARED BY BATEMAN CIVIL SURVEY CO., UNDER THE SUPERVISION OF STEVEN P. CARSON, PLS.
 2. THIS PLAN HAS BEEN PREPARED FOR LAYOUT AND PERMITTING PURPOSES ONLY.
 3. THIS IS NOT A BOUNDARY SURVEY. PROPERTY LINES SHOWN WERE TAKEN FROM EXISTING FIELD EVIDENCE, EXISTING DEEDS AND PLATS OF PUBLIC RECORD, AND INFORMATION SUPPLIED TO THE SURVEYOR BY THE CLIENT
 4. VERTICAL DATUM IS ASSUMED. THE LATITUDE, LONGITUDE AND STATE PLANE COORDINATES, IF SHOWN, ARE GIVEN IN NORTH AMERICAN DATUM OF 1983 (NAD83).
 5. FIELD EQUIPMENT USED: NIKON TOTAL STATION, EPOCH 35.
 6. ALL DISTANCES ARE HORIZONTAL GROUND DISTANCES AND ALL BEARINGS ARE NORTH CAROLINA STATE PLANE COORDINATE SYSTEM UNLESS OTHERWISE SHOWN.
 7. THIS MAP IS NOT A CERTIFIED SURVEY AND HAS NOT BEEN REVIEWED BY A LOCAL GOVERNMENT AGENCY FOR COMPLIANCE WITH ANY APPLICABLE LAND DEVELOPMENT REGULATIONS.
 8. THE PROPERTY LIES IN ZONES "X" PER NATIONAL FLOOD INSURANCE PROGRAM FLOOD INSURANCE RATE MAP NUMBER 3720181200J, DATED MAY 2, 2006.
 9. ZONING IS R-40W.
 10. PROPERTY OWNER: SAVVY HOMES
8025 CREEDMOOR ROAD
SUITE #100
RALEIGH, NC 27613

*CH
Part A
See Part
B for layout*

11

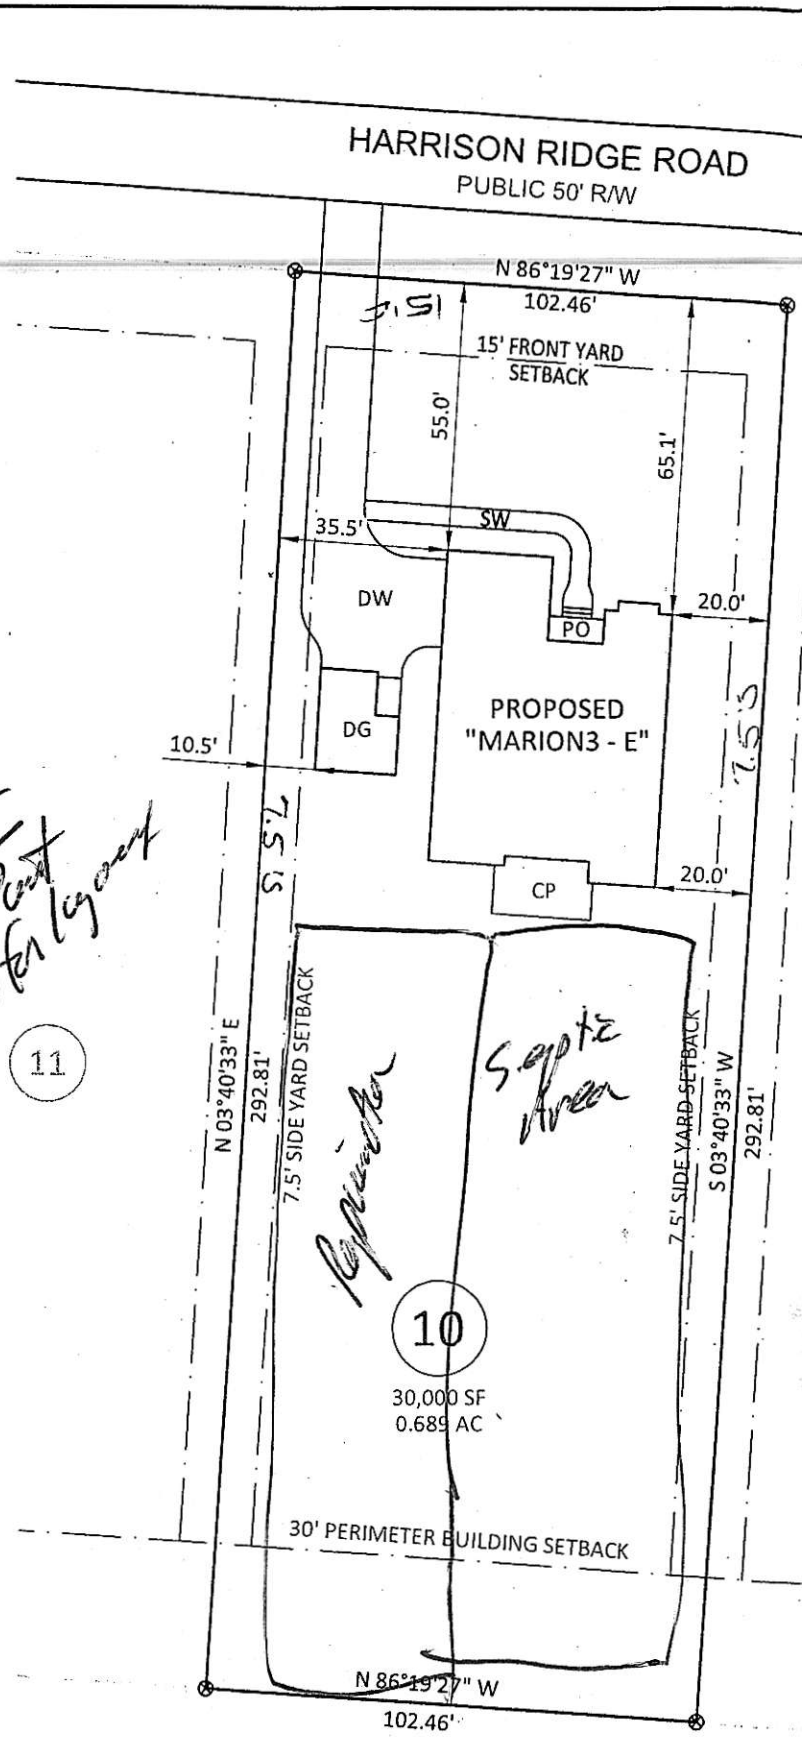

BAILEY CLAN INC, THE
D.B. 6205 PG. 0542
PIN # 1812.04-52-8013

LOT INFORMATION:

LOT #10
DB 015743, PG 01684
PIN: 1812721755
REID: 0347652
ADDRESS: 1108 HARRISON RIDGE ROAD
TOTAL LOT AREA = 0.689 AC = 30,000 SF
MAXIMUM IMPERVIOUS = 5,119 SF
HOUSE = 2,693 SF
DRIVEWAY = 1,356 SF
SIDEWALK = 259 SF
PORCH = 57 SF
COVERED PORCH = 237 SF
DETACHED GARAGE = 352 SF
PROPOSED IMPERVIOUS = 4,954 SF
PERCENT IMPERVIOUS = 16.5 %

Zoning R40W By 101A
Approve / Date 6-29-16
Revise / Use 101A
Reject / MBL
Front 15 Rear 15
Side 7.5 Corner /
Comments:

I certify that the location of planned or existing structure(s) are accurately shown. I understand failure to locate structures in accordance with this plot plan may require the relocation of structure(s) regardless degree of completion. I hereby grant permission to Municipal/County Representatives the right of entry to make evaluations or inspections upon this property.

[Signature]
Signature of Owner or Authorized Agent


**REVISOR
ATTN: KEN DARE*

*PIN#
1812721755*


*Permit #
0164167*

D050721

SCALE:
1" = 40 ft.

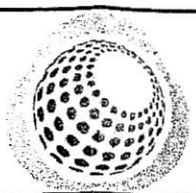

Bateman Civil Survey Company
Engineers • Surveyors • Planners
2524 Reliance Ave., Apex, NC 27539 Ph: 919.577.1080 Fax: 919.577.1081
www.batemancivilsurvey.com info@batemancivilsurvey.com
NCBELS Firm No. C-2378

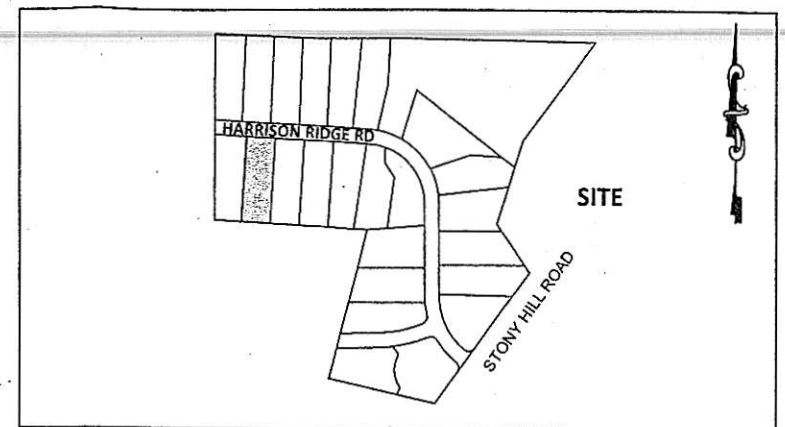

VICINITY MAP
(Not to Scale)

LEGEND

- PO = PORCH
- CP = COVERED PORCH
- P = CONCRETE PATIO
- WD = WOOD DECK
- SW = SIDEWALK
- DW = CONC DRIVEWAY
- DG = DETACHED GARAGE
- ⊗ = CONTROL POINT
- ⊙ = IRON PIPE FOUND
- ⊙ = IRON PIPE SET
- ⊙ = DRILL HOLE FOUND
- WM = WATER METER
- CO = CLEAN OUT
- AC = AIR CONDITIONER
- ⊙ = SEWER MANHOLE
- EB = ELECTRIC BOX
- ⊙ = CABLE BOX
- ⊙ = TELEPHONE PEDESTAL
- CI = CURB INLET
- DG = DETACHED GARAGE
- ⊙ = LIGHT POLE

BUILDING SETBACKS:
FRONT = 15 ft
REAR = 15 ft
SIDE = 7.5 ft
PERIMETER = 30 ft

I hereby certify that this map is correct and that the building lies wholly on the lot and that there are no visible encroachments on said lot.

Steven P. Carson, PLS 4752
Date

This map is of an existing parcel of land and is only intended for the parties and purposes shown. This map not for recordation. No title report provided.

APPROVAL FOR STAKING:

THIS PLOT PLAN AS PREPARED BY BATEMAN CIVIL SURVEY CO., IS CORRECT AND IS HEREBY APPROVED FOR STAKING ON THE DATE AS SHOWN BELOW.

SAVVY HOMES REPRESENTATIVE _____ DATE _____

PRELIMINARY PLOT PLAN - LOT 10

FOR
**SAVVY
HOMES**
Life Amplified.™

BEAU PRE' AT STONY HILL - LOT 10
1108 HARRISON RIDGE ROAD
NEW LIGHT TOWNSHIP, WAKE COUNTY, NC

DATE: 5/2/16 DRAWN BY: JKF CHECKED BY: SPC

REFERENCE: BM 2013, PG 1572

SCALE: 1" = 40'

LINE SCHEDULE

LINE NUMBER	COLOR	FIELD ELEVATION	LENGTH
1	BLUE	0.20	125
2	ORANGE	0.80	125
3	RED	1.80	125
4	PINK	2.70	125
5	YELLOW	3.40	140
6	BLUE	4.40	140
7	ORANGE	5.20	140
8	RED	6.00	95' 100'

LOT 10 Beau Pré S/D
 4-BEDROOM ACCEPTED STATUS GRAVITY
 SYSTEM
 LINES 1-4 (4 x 125' x 3')
 EZFLOW
 LTAR 0.3

4-BEDROOM PRESSURE MANIFOLD REPAIR
 LINES 5-8
 EZFLOW
 LTAR 0.3

Repair can
 be installed
 as 4 100' lines

FOR GENERAL USE NOT A SURVEY

- REP

CA - Part B

4 Bedroom - Revised
 7-6-16


1200 gal tank

4 x 3' x 100' = 1200 sq ft

Accepted status


@ 24" diam

Repair -
 Accepted Status
 Pressure Manifold

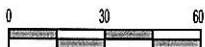

SCALE:
 1" = 60 ft.

HARRISON RIDGE ROAD 50' PUBLIC R/W

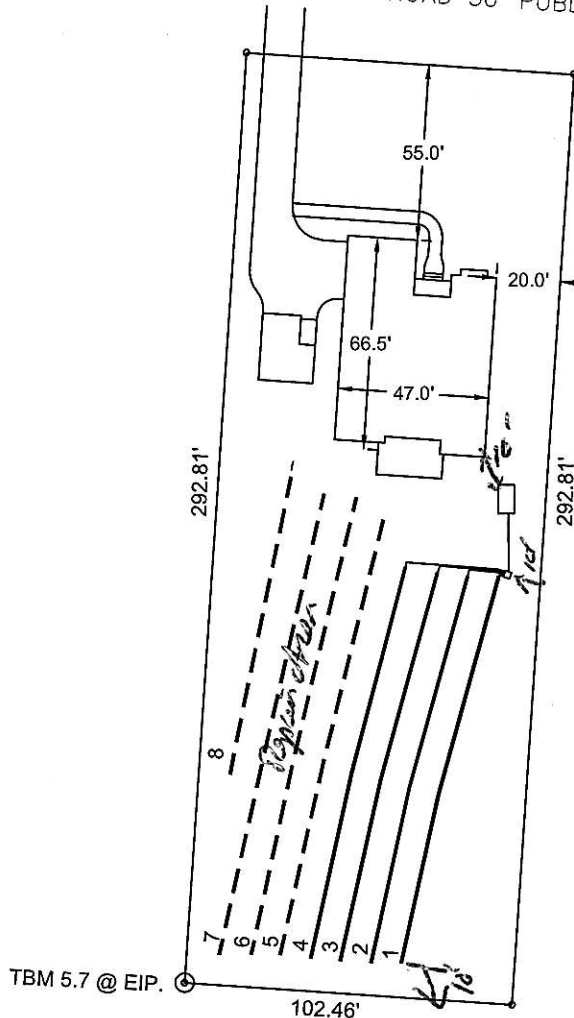

Central Carolina Soil Consulting, PLLC
 1900 South Main Street, Suite 110
 Wake Forest, North Carolina 27587
 Phone (919)569-6704 Fax (919)569-6703

JOB DESCRIPTION
 Lot 10 Beau Pré @ Stony Hill Subdivision
 Wake County, North Carolina

Job# :
Drawn By : AH
Date : 06/21/2016
Revision: