

Environmental Services - Water Quality
Onsite Wastewater Scan Data Entry Form

PERMIT #: 0012965

PIN #: 0770647040

OP DATE: 0710111999

SYSTEM USE:

- ☒ House
☐ Mobile Home
☐ Business
☐ Other

SEWAGE TYPE:

- ☒ Domestic
☐ Industrial

PUMP/SIPHON?:

- ☐ Yes
☒ No

PRESSURE MANIFOLD:

- ☐ Yes
☒ No

SYSTEM TYPE:

- ☐ I
☒ II
☐ III
☐ IV
☐ V
☐ VI
☐ Other

SUB TYPE:

- ☒ A
☐ B
☐ C
☐ D
☐ E
☐ F
☐ G

NBR BEDROOMS:

- ☐ 1
☐ 2
☐ 3
☒ 4
☐ 5
☐ 6
☐ Other

MAINT. SCHEDULE:

- ☐ Yes
☒ No

CERT. OPERATOR

- ☐ Yes
☒ No

- | GT | ST | PT | SIZE |
|-------------------------------------|-------------------------------------|-------------------------------------|------------------|
| ☐ | ☐ | | 750 |
| ☐ | ☐ | ☐ | 900 |
| ☐ | ☐ | ☐ | 1,000 |
| ☐ | ☒ | ☐ | 1,200 |
| ☐ | ☐ | ☐ | 1,500 |
| ☐ | ☐ | ☐ | 1,800 |
| ☐ | ☐ | ☐ | 2,100 |
| ☐ | ☐ | ☐ | 2,500 |
| ☐ | ☐ | ☐ | 3,000 |
| ☐ | ☐ | ☐ | 4,000 |
| ☐ | ☐ | ☐ | 5,000 |
| ☐ | ☐ | ☐ | 8,000 |
| ☐ | ☐ | ☐ | 10,000 |
| ☐ | ☐ | ☐ | Other |
| ☒ | | ☒ | None/NA GT or PT |

DRAINFIELD SIZE(SQ. FT.)

01107

DRAIN TYPE:

- ☐ Stone
☒ EZ Flow
☐ Infiltrator
☐ Biodiffuser
☐ Cultec
☐ Drip
☐ Hancor
☐ Large Dia. Pipe
☐ Multi-Pipe
☐ Other

MAX DEPTH (IN.):

- ☐ 12 in. or less
☐ 18 in. or less
☒ 24 in. or less
☐ 26 in. or less
☐ 28 in. or less
☐ 30 in. or less
☐ 32 in. or less
☐ 36 in. or less
☐ Other

STONE DEPTH (IN.):

- ☐ 8 in. or less
☒ 12 in. or less
☐ 18 in. or less
☐ 24 in. or less
☐ Other

TRENCHES:

- ☒ Individual
☐ Bed

TRENCH WIDTH (IN.):

- ☐ 12 in. or less
☐ 18 in.
☐ 24 in.
☒ 36 in.
☐ 6 ft. or less
☐ 9 ft. or less
☐ Other

B.W 6/36/04

WAKE COUNTY DEPARTMENT OF ENVIRONMENTAL SERVICES WELL AND SEWAGE SITE LOCATION PERMIT

NO PERMIT(S) FOR CONSTRUCTION, LOCATION OR RELOCATION ACTIVITY SHALL BE ISSUED

UNTIL AN AUTHORIZATION FOR WASTEWATER SYSTEM CONSTRUCTION HAS BEEN ISSUED

PERMIT VOID IF NOT IN COMPLIANCE WITH ZONING REGULATIONS AND/ OR IF SITE IS ALTERED OR INTENDED USE CHANGED

PERMIT#: D012965 STATUS: A APP DATE: 12/22/1998 BLDG PERMIT#: 0992269

APPLICANT: REESE, CLINT M JR

DAY PHONE: (919) 427 - 4685

ADDRESS: 6801 BRANTON DR

FAX#: (999) 999 - 9999

CITY: APEX

STATE: NC ZIP: 27502

OWNER: H M ENTERPRISES WHITEHARD

DAY PHONE: (999) 999 - 9999

ADDRESS: 5821 HOLLY SPRINGS RD

FAX#: (999) 999 - 9999

CITY: RALEIGH

STATE: NC ZIP: 27606

HD USE CD: 101 ONE-FAMILY HOUSE

ORIG PERMIT#:

REC?: Y

EXIST USE:

TAX MAP#: 0721 0000

BEDROOMS: 4 BSMT: N #EMPLOYEES: 0 WATER: C WASTEWATER: I GARB DISPOS: N

TOWNSHIP: 18 SWIFT CREEK JURIS: WC ZON: 40W PIN: 0770.04 64 7040 000

SUBD#: S 000 000 00 SUBD NAME: WHITEHART LOT-SEC: 2 ACRE: 0.70

IMPRV PRMT: ISSUED?: Y DATE: 02/02/1999 BY: DRP TYPE SYSTEM: II PUMP:

CNSTR AUTH: ISSUED?: Y DATE: 02/02/1999 BY: DRP MAINT: N OPER: N

RECEIPT#: 0036984 FEE: 145.00

OP DATE:

BY:

WATR SAMPL: REQ?: N APPROVED?: DATE:

PROPRIETARY SYS:

ST#: 3024 MI: DIR:

NAME: WHITEHART

DIR: TYP: LN

DIRECTIONS: 401S R SR 1010 R SR 1386 L INTO SUB

CLUSTER SUB

IMPROVEMENT PERMIT

SIZE OF TANK 1200 ST PT GALS. TOTAL SQ. FT. 1107 DEPTH OF STONE INNOV IN. MAX. DEPTH LINE 24 IN.

WASTEWATER: DOMESTIC ☒ INDUSTRIAL ☐

I.P. ISSUED BY

Dave Parnell

AUTHORIZATION FOR WASTEWATER SYSTEM CONSTRUCTION

VOID SIXTY (60) MONTHS FROM DATE OF ISSUANCE

AUTHORIZATION CONDITIONS

Contractor To Follow Contours, See Attached Site Plan For Wastewater System Design And Well Location. The wastewater system shall not be covered or placed into use until inspected by the Wake County Department of Environmental Services and an Operation Permit issued.

OTHER CONDITIONS: USE INNOVATIVE SYSTEM TO ACCOUNT FOR THE ADDITION OF FOURTH BEDROOM.
25% REDUCTION HAS BEEN FACTORED INTO SPECS. SET FORTH BELOW. REQUEST LETTER IS REQUIRED.

SIZE OF TANK 1200 ST PT GALS. TOTAL SQ. FT. 1107 DEPTH OF STONE INNOV IN. MAX. DEPTH LINE 24 IN.

ST FILTER REQUIRED ☒ NUMBER OF TRENCHES 4 LENGTH OF TRENCHES 92 FT. WIDTH OF TRENCHES 3 FT.

C.A. ISSUED BY

Dave Parnell

INSTALLED BY

Johnny Jones

CTR. I.D. #

SEPTIC TANK FILTER USED

INNOV. APPL. #: IWWS-

DATE 7-1-99

INSTALLATION APPROVED BY

[Signature]

WELL SYSTEM = PRIVATE ☐ SEMI-PUBLIC ☐ //// NEW ☐ REPLACEMENT ☐ EXISTING ☐

WELL LOG INFORMATION = DEPTH _____ CASING DEPTH _____ YIELD _____ STATIC LEVEL _____

WELL CONTRACTOR _____ REG.# _____ PUMP CONTRACTOR _____ REG.# _____

CONSTRUCTION COMPLIANCE = GROUT APPROVED ☐

DATE _____

EHS _____

WCHD ID # _____ WELLHEAD APPROVED ☐

DATE _____

EHS _____

NEGATIVE BACTERIOLOGICAL RESULTS ☐

DATE _____

EHS _____

SYSTEM FINALIZED ☐

DATE _____

EHS _____

COMMENTS: _____

This permit is based in part on information provided by the homeowner or his/her representative in the application submitted for this permit. The Environmental Health Specialist is not responsible for false or misleading information contained in the application. The Environmental Health Specialist is also not responsible for concealed conditions on the property or for statements in this report that may have resulted from false or misleading statements provided to him in the application. Neither Wake County nor the Environmental Health Specialist warrants that the septic tank system will continue to function satisfactorily in the future or that the water supply will remain potable.

REESE CONSTRUCTION

CA
Diagram

LOT 2, WHITEHART SUBDIVISION PHASE 1 BM 1997 PG. 1645

SWIFT CREEK TOWNSHIP WAKE COUNTY NORTH CAROLINA

SCALE: 1" = 40'


I certify that the location of all proposed or existing structure(s) are as shown. I understand failure to locate structures in accordance with this plot plan may require the relocation of structure(s) regardless of degree of completion. I hereby grant permission to Municipal/County Representatives the right of entry to make evaluations or inspections upon this property.

X *[Signature]* 3/2/99
Signature of Owner or Authorized Agent

Zoning 40W By mf
Approve [initials] Date 3/2/99
Revise [initials] Use 10/10/99
Reject [initials] MBL
Front 15 Rear 15
Side 7 1/2 Corner -

Comments:

Revised site plan, changed to 4 bedroom house

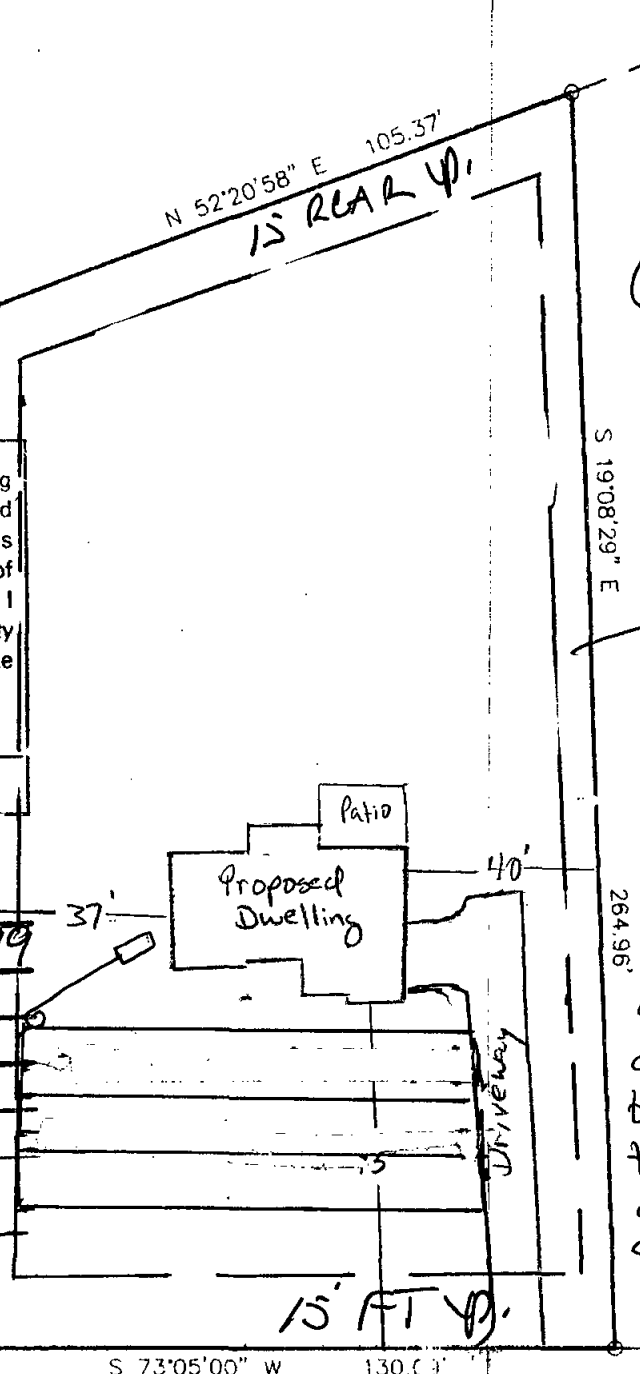


0992269
D-12965

2.5' side v.
setback

Contractor:
adjustment of
drainlines may
be needed at
time of installation
due to difficult
contour read.

WHITEHART LANE
50' PUBLIC R/W

LEGEND
EIP - EXISTING IRON PIPE
IPS - IRON PIPE SET
NIF - NO IRON FOUND
PK - PK NAIL

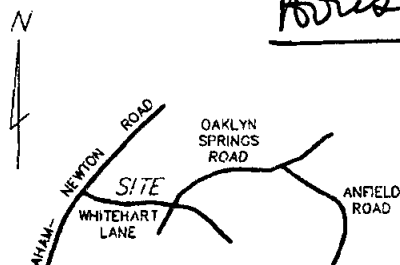

3/15/99

To: David Parnell

From: Clint Reese

RE: Lot 2 Whitehart Sub.

Please be advised that I would like to use the Easy-Lay system in order to reduce my field size by 25%

Thank-you
C. Reese