

Environmental Services - Water Quality
Onsite Wastewater Scan Data Entry Form

PERMIT #: 13010398

PIN #: 0679887953

OP DATE: 0710311978

SYSTEM USE:

- ☒ House
☐ Mobile Home
☐ Business
☐ Other

SEWAGE TYPE:

- ☒ Domestic
☐ Industrial

PUMP/SIPHON?:

- ☐ Yes
☒ No

PRESSURE MANIFOLD:

- ☐ Yes
☒ No

SYSTEM TYPE:

- ☐ I
☒ II
☐ III
☐ IV
☐ V
☐ VI
☐ Other

SUB TYPE:

- ☒ A
☐ B
☐ C
☐ D
☐ E
☐ F
☐ G

NBR BEDROOMS:

- ☐ 1
☐ 2
☒ 3
☐ 4
☐ 5
☐ 6
☐ Other

MAINT. SCHEDULE:

- ☐ Yes
☒ No

CERT. OPERATOR

- ☐ Yes
☒ No

GT ST PT SIZE

- | | | | |
|-------------------------------------|-------------------------------------|-------------------------------------|------------------|
| ☐ | ☐ | ☐ | 750 |
| ☐ | ☒ | ☐ | 900 |
| ☐ | ☐ | ☐ | 1,000 |
| ☐ | ☐ | ☐ | 1,200 |
| ☐ | ☐ | ☐ | 1,500 |
| ☐ | ☐ | ☐ | 1,800 |
| ☐ | ☐ | ☐ | 2,100 |
| ☐ | ☐ | ☐ | 2,500 |
| ☐ | ☐ | ☐ | 3,000 |
| ☐ | ☐ | ☐ | 4,000 |
| ☐ | ☐ | ☐ | 5,000 |
| ☐ | ☐ | ☐ | 8,000 |
| ☐ | ☐ | ☐ | 10,000 |
| ☐ | ☐ | ☐ | Other |
| ☒ | ☐ | ☒ | None/NA GT or PT |

DRAINFIELD SIZE(SQ. FT.)

00960

DRAIN TYPE:

- ☒ Stone
☐ EZ Flow
☐ Infiltrator
☐ Biodiffuser
☐ Cultec
☐ Drip
☐ Hancor
☐ Large Dia. Pipe
☐ Multi-Pipe
☐ Other

MAX DEPTH (IN.):

- ☐ 12 in. or less
☐ 18 in. or less
☒ 24 in. or less *est.*
☐ 26 in. or less
☐ 28 in. or less
☐ 30 in. or less
☐ 32 in. or less
☐ 36 in. or less
☐ Other

STONE DEPTH (IN.):

- ☐ 8 in. or less
☐ 12 in. or less
☒ 18 in. or less
☐ 24 in. or less
☐ Other

TRENCHES:

- ☐ Individual
☒ Bed

TRENCH WIDTH (IN.):

- ☐ 12 in. or less
☐ 18 in.
☐ 24 in.
☐ 36 in.
☒ 6 ft. or less
☐ 9 ft. or less
☐ Other

* PERMIT VOID IF NOT IN COMPLIANCE WITH ZONING REGULATIONS

TAX MAP NO. 743
PARCEL NO. 50

WAKE COUNTY HEALTH DEPARTMENT
SEPTIC TANK LAYOUT AND PERMIT

PERMIT NO. B

10398


OWNER OR CONTRACTOR Emory Ward / Prior obtained DATE 6 21 78
LOCATION Off 1010 original permit

SUBDIVISION NAME Deerfield Park LOT NO. 35 S.R. NO. 1010
SECTION OR BLOCK NO. III

GARBAGE DISPOSAL UNIT YES ☐ NO ☒
HOUSE ☒ MOBILE HOME ☐ BUSINESS ☐
NO. BEDROOMS 3 LOT AREA 317 x 100
SIZE OF TANK 900 gal.
NITRIFICATION LINE 750 + ~~1000~~ ~~1654~~ sq. ft.
DEPTH OF STONE IN LINES: 12" ☒ 18" ☐ *see note.
WATER SUPPLY: INDIVIDUAL ☐ PUBLIC ☒

* PERMIT VOID 12 MONTHS FROM DATE OF ISSUANCE.
* Accepted due to extra stone - nearly 18"

LAYOUT BY Bob Floyd

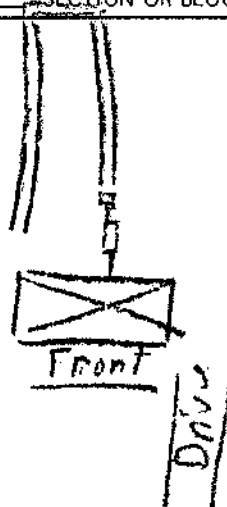

7-3-78
DATE

D. L. Atkins
INSTALLED BY

D. Ward
APPROVED BY