

Environmental Services - Water Quality
Onsite Wastewater Scan Data Entry Form

PERMIT #: D013564

PIN #: 0646998697

OP DATE: 0812311999

SYSTEM USE:

- ☒ House
☐ Mobile Home
☐ Business
☐ Other

SEWAGE TYPE:

- ☒ Domestic
☐ Industrial

PUMP/SIPHON?:

- ☐ Yes
☒ No

PRESSURE MANIFOLD:

- ☐ Yes
☒ No

SYSTEM TYPE:

- ☐ I
☒ II
☐ III
☐ IV
☐ V
☐ VI
☐ Other

SUB TYPE:

- ☒ A
☐ B
☐ C
☐ D
☐ E
☐ F
☐ G

NBR BEDROOMS:

- ☐ 1
☐ 2
☒ 3
☐ 4
☐ 5
☐ 6
☐ Other

MAINT. SCHEDULE:

- ☐ Yes
☒ No

CERT. OPERATOR

- ☐ Yes
☒ No

GT ST PT SIZE

- | | | | |
|-------------------------------------|-------------------------------------|-------------------------------------|------------------|
| ☐ | ☐ | | 750 |
| ☐ | ☐ | ☐ | 900 |
| ☐ | ☒ | ☐ | 1,000 |
| ☐ | ☐ | ☐ | 1,200 |
| ☐ | ☐ | ☐ | 1,500 |
| ☐ | ☐ | ☐ | 1,800 |
| ☐ | ☐ | ☐ | 2,100 |
| ☐ | ☐ | ☐ | 2,500 |
| ☐ | ☐ | ☐ | 3,000 |
| ☐ | ☐ | ☐ | 4,000 |
| ☐ | ☐ | ☐ | 5,000 |
| ☐ | ☐ | ☐ | 8,000 |
| ☐ | ☐ | ☐ | 10,000 |
| ☒ | ☐ | ☒ | Other |
| | | | None/NA GT or PT |

DRAINFIELD SIZE(SQ. FT.)

00900

*w3049 Attached
(+ Deck)

DRAIN TYPE:

- ☒ Stone
☐ EZ Flow
☐ Infiltrator
☐ Biodiffuser
☐ Cultec
☐ Drip
☐ Hancor
☐ Large Dia. Pipe
☐ Multi-Pipe
☐ Other

MAX DEPTH (IN.):

- ☐ 12 in. or less
☐ 18 in. or less
☐ 24 in. or less
☐ 26 in. or less
☐ 28 in. or less
☒ 30 in. or less
☐ 32 in. or less
☐ 36 in. or less
☐ Other

STONE DEPTH (IN.):

- ☐ 8 in. or less
☒ 12 in. or less
☐ 18 in. or less
☐ 24 in. or less
☐ Other

TRENCHES:

- ☒ Individual
☐ Bed

TRENCH WIDTH (IN.):

- ☐ 12 in. or less
☐ 18 in.
☐ 24 in.
☒ 36 in.
☐ 6 ft. or less
☐ 9 ft. or less
☐ Other

(24-30)

Am

WAKE COUNTY ENVIRONMENTAL HEALTH WELL AND SEWAGE SITE LOCATION PERMIT

NO PERMIT(S) FOR CONSTRUCTION, LOCATION OR RELOCATION ACTIVITY SHALL BE ISSUED
UNTIL AN AUTHORIZATION FOR WASTEWATER SYSTEM CONSTRUCTION HAS BEEN ISSUED

PERMIT VOID IF NOT IN COMPLIANCE WITH ZONING REGULATIONS AND/OR IF SITE IS ALTERED OR INTENDED USE CHANGED

63

PERMIT#: D013564 STATUS: A APP DATE: 02/25/1999 BLDG PERMIT#: 0993033
APPLICANT: ALLEN, STEVE CONSTRUCTION COMP DAY PHONE: (919) 779 - 0138
ADDRESS: 8909 RANDELL ROAD FAX#: (919) 779 - 0138
CITY: RALEIGH STATE: NC ZIP: 27603
OWNER: AKINS, ANNA R DAY PHONE: (999) 999 - 9999
ADDRESS: P. O. BOX 266 FAX#: (999) 999 - 9999
CITY: FUQUAY-VARINA STATE: NC ZIP: 27526

HD USE CD: 101 ONE-FAMILY HOUSE ORIG PERMIT#: REC?: Y
EXIST USE: TAX MAP#: 0836 0011

BEDROOMS: 3 BSMT: N #EMPLOYEES: 0 WATER: I WASTEWATER: I GARB DISPOS: N
TOWNSHIP: 12 MIDDLE CREEK JURIS: WC ZON: R30 PIN: 0647-04-90-9606-000 646.99.8697
SUBD#: S 000 000 00 SUBD NAME: PRESCOTT DOWNS LOT-SEC: 82 ACRE: 1.50
IMPRV PRMT: ISSUED?: Y DATE: 04/01/1999 BY: WEL TYPE SYSTEM: II PUMP:
CNSTR AUTH: ISSUED?: Y DATE: 04/01/1999 BY: WEL MAINT: N OPER: N

RECEIPT#: 0039189 FEE: 290.00 OP DATE: BY:
WATR SAMPL: REQ?: Y APPROVED?: DATE: PROPRIETARY SYS:
ST#: 6712 MI: DIR: NAME: WAVCOTT DIR: TYP: DR

DIRECTIONS: GO 401 S TO FUQUAY R ON 42 HWY WEST R ON PINEY
GROVE-WILBON RD GO 4 MI R ON STICKLEBACK INTO S
UBD.

ce/24/99
3-100' x 3' Lines Installed
10 Stepdowns
87M

IMPROVEMENT PERMIT

SIZE OF TANK 1000 ST PT GALS. TOTAL SQ. FT. 900 DEPTH OF STONE 12 IN. MAX. DEPTH LINE 24-30 IN.

WASTEWATER: DOMESTIC ☒ INDUSTRIAL ☐

I.P. ISSUED BY Everett Kym, R.S.

AUTHORIZATION FOR WASTEWATER SYSTEM CONSTRUCTION

VOID SIXTY (60) MONTHS FROM DATE OF ISSUANCE

AUTHORIZATION CONDITIONS

Contractor To Follow Contours, See Attached Site Plan For Wastewater System Design And Well Location. The wastewater system shall not be covered or placed into use until inspected by the Wake County Environmental Health Division and an Operation Permit issued.

OTHER CONDITIONS: Septic tank to have two access risers and approved effluent filter. Establish and install lines on contour.

SIZE OF TANK 1000 ST PT GALS. TOTAL SQ. FT. 900 DEPTH OF STONE 12 IN. MAX. DEPTH LINE 24-30 IN.
ST FILTER REQUIRED ☒ NUMBER OF TRENCHES 3 LENGTH OF TRENCHES 100 FT. WIDTH OF TRENCHES 3 FT.

C.A. ISSUED BY Everett Kym, R.S. INSTALLED BY Tim King CTR. I.D. #
SEPTIC TANK FILTER USED
INNOV. APPRL. #: IWWS- DATE 6/24/99 8/23/99 INSTALLATION APPROVED BY Steve Meyer, R.S.

WELL SYSTEM = PRIVATE ☒ SEMI-PUBLIC ☐ NEW ☒ REPLACEMENT ☐ EXISTING ☐

WELL LOG INFORMATION = DEPTH 185' CASING DEPTH 80' YIELD 20 STATIC LEVEL 25'
WELL CONTRACTOR Goldsboro REG.# PUMP CONTRACTOR Septis REG.#

CONSTRUCTION COMPLIANCE = GROUT APPROVED ☒ DATE 8/24/99 EHS
WCHD ID # 9041 WELLHEAD APPROVED ☒ DATE 8/27/99 EHS
NEGATIVE BACTERIOLOGICAL RESULTS ☒ DATE 8/27/99 EHS
SYSTEM FINALIZED ☒ DATE 9/1/99 EHS

COMMENTS:

This permit is based in part on information provided by the homeowner or his/her representative in the application submitted for this permit. The Environmental Health Specialist is not responsible for false or misleading information contained in the application. The Environmental Health Specialist is also not responsible for concealed conditions on the property or for statements in this report that may have resulted from false or misleading statements provided to him in the application. Neither Wake County nor the Environmental Health Specialist warrants that the septic tank system will continue to function satisfactorily in the future or that the water supply will remain potable.


D-13564 AS BUILT

0993033

646.99.8697
~~0647.04.90960~~
 712 Wavcott DR
 Lot # 82

Zoning R30 By SWN
 Approve ✓ Date 2/24/99
 Revise _____ Use _____
 Reject _____ MBL _____
 Front 30' Rear 30'
 Side 10' Corner 30'
 Comments Flood Study
Reg B
by ENGINEER

Mills 1200
 STB 857
 4/3/99

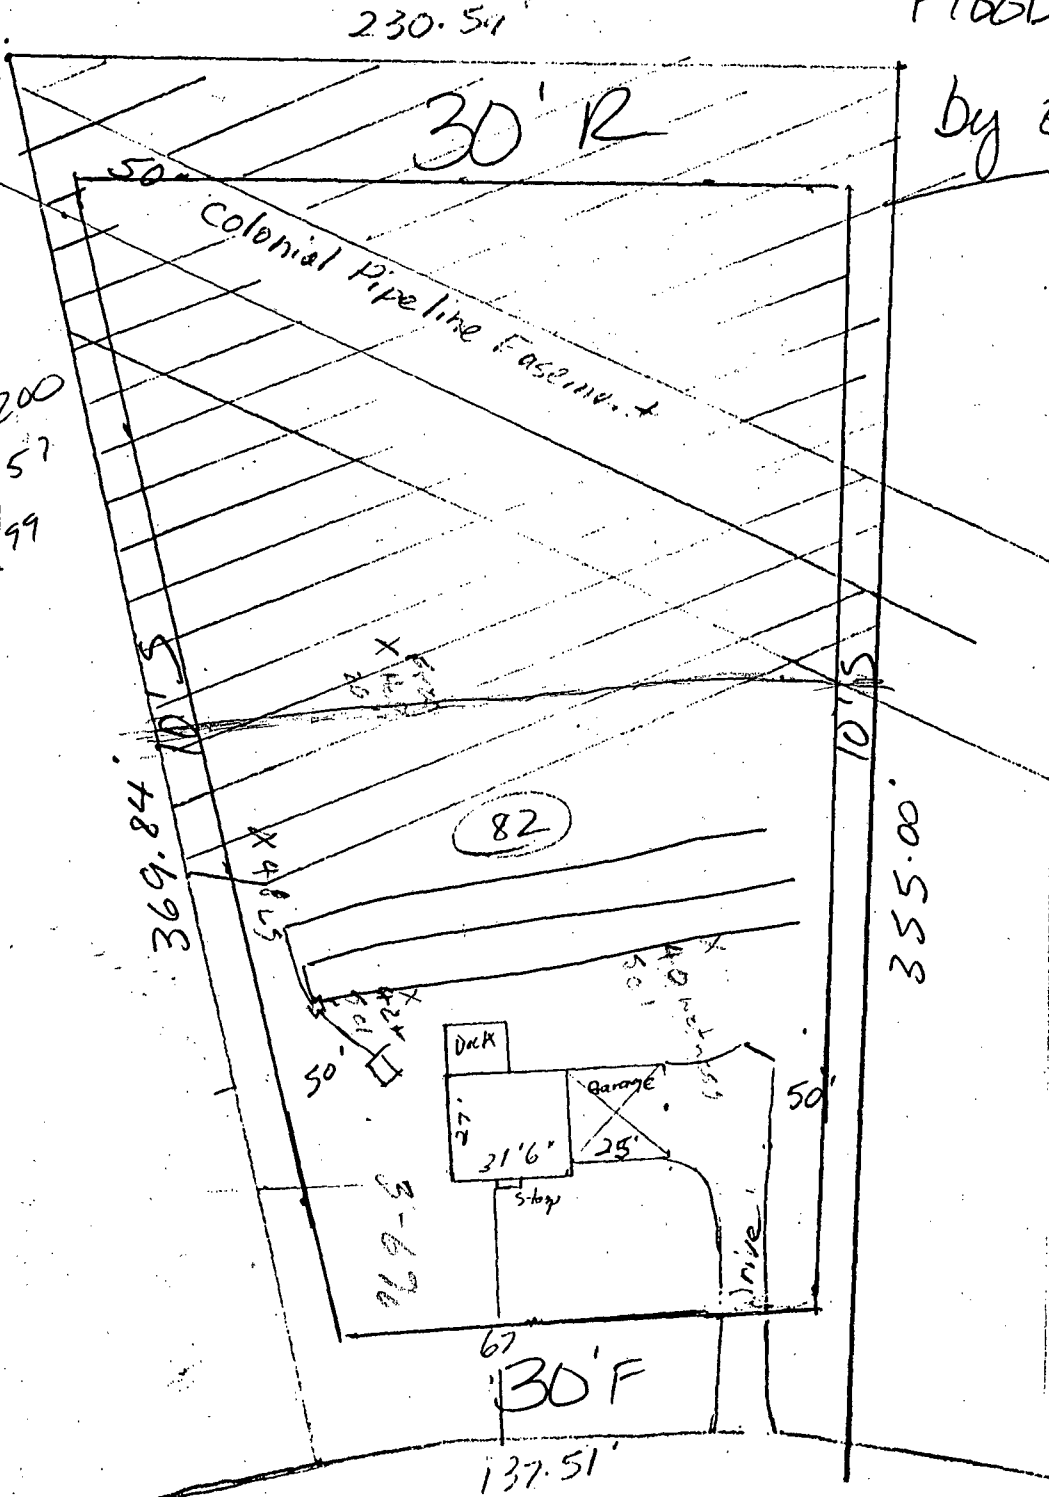

CDS
 INSPECTIONS &
 LAND USE DIVISION

DATE 02/25/1999 THU

0050630-0921	\$290.00
117100-00803	\$24.00
NON-ADD NO.	8993033
0050630-0921	\$290.00
117200-01009	\$24.00
NON-ADD NO.	8993034
0050630-0921	\$290.00
117200-01009	\$24.00
NON-ADD NO.	8993037
TOTAL	\$942.00
CHECK	\$942.00
0000000SWH	#01
TIME 15:02	NO.039189

6712 Wavcott Drive Lot #82


I certify that the location of planned or existing structure(s) are accurately shown. I understand failure to locate structures in accordance with this plot plan may require the relocation of structure(s) regardless degree of completion. I hereby grant permission to Municipal/County Representatives the right of entry to make evaluations or inspections upon this property.

Steve Allen
 Signature of Owner or Authorized Agent

STEVE ALLEN CONST. COMPANY
 8909 RANDELL ROAD
 RALEIGH NC 27603
 919 779-0138


1" = 50' Scale

STEVE ALLEN CONST. COMPANY
8909 RANDELL ROAD
RALEIGH, NC 27603
919 779-0138

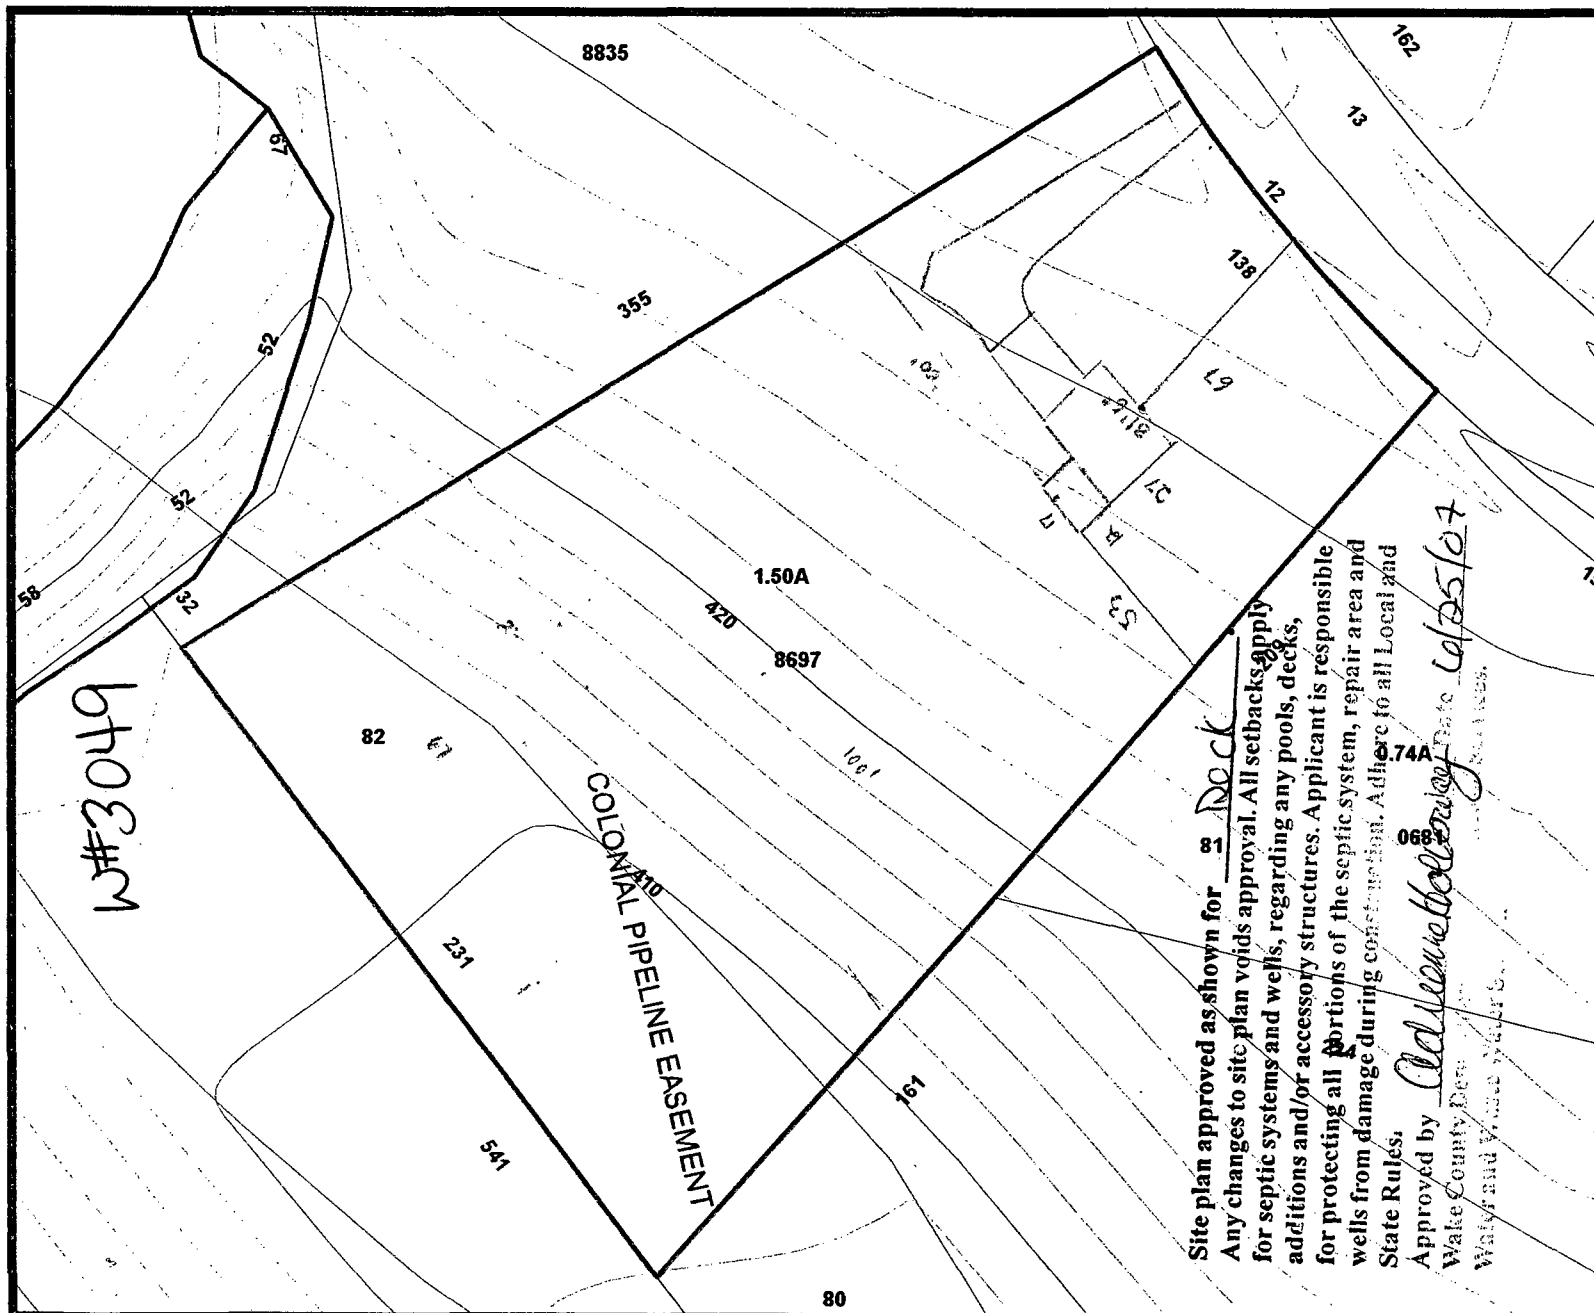

EY NA

Geographic Information Services

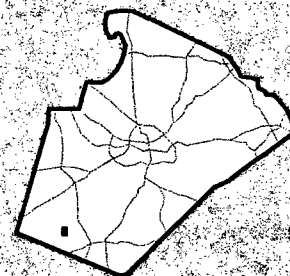

House 2,028
 drink way 1,128
 Street Park 204
3,360
 lot 65340
 5.2%



Lowestore waveco H