

Environmental Services - Water Quality
Onsite Wastewater Scan Data Entry Form

PERMIT #: **A** **0** **0** **2** **9** **5** **2**

PIN #: **1** **7** **8** **5** **3** **0** **6** **1** **6** **1**

OP DATE: **0** **6** **/** **2** **8** **/** **1** **9** **7** **2**

SYSTEM USE:

- ☒ House
☐ Mobile Home
☐ Business
☐ Other

SEWAGE TYPE:

- ☒ Domestic
☐ Industrial

PUMP/SIPHON?:

- ☐ Yes
☒ No

PRESSURE MANIFOLD:

- ☐ Yes
☒ No

SYSTEM TYPE:

- ☐ I
☒ II
☐ III
☐ IV
☐ V
☐ VI
☐ Other

SUB TYPE:

- ☒ A
☐ B
☐ C
☐ D
☐ E
☐ F
☐ G

NBR BEDROOMS:

- ☐ 1
☐ 2
☒ 3
☐ 4
☐ 5
☐ 6
☐ Other

MAINT. SCHEDULE:

- ☐ Yes
☒ No

CERT. OPERATOR

- ☐ Yes
☒ No

GT ST PT SIZE

- | | | | |
|-------------------------------------|-------------------------------------|-------------------------------------|------------------|
| ☐ | ☐ | ☐ | 750 |
| ☐ | ☒ | ☐ | 900 |
| ☐ | ☐ | ☐ | 1,000 |
| ☐ | ☐ | ☐ | 1,200 |
| ☐ | ☐ | ☐ | 1,500 |
| ☐ | ☐ | ☐ | 1,800 |
| ☐ | ☐ | ☐ | 2,100 |
| ☐ | ☐ | ☐ | 2,500 |
| ☐ | ☐ | ☐ | 3,000 |
| ☐ | ☐ | ☐ | 4,000 |
| ☐ | ☐ | ☐ | 5,000 |
| ☐ | ☐ | ☐ | 8,000 |
| ☐ | ☐ | ☐ | 10,000 |
| ☐ | ☐ | ☐ | Other |
| ☒ | | ☒ | None/NA GT or PT |

DRAINFIELD SIZE(SQ. FT.)

0 **0** **9** **0** **0**

DRAIN TYPE:

- ☒ Stone
☐ EZ Flow
☐ Infiltrator
☐ Biodiffuser
☐ Cultec
☐ Drip
☐ Hancor
☐ Large Dia. Pipe
☐ Multi-Pipe
☐ Other

MAX DEPTH (IN.):

- ☐ 12 in. or less
☐ 18 in. or less
☐ 24 in. or less
☐ 26 in. or less
☐ 28 in. or less
☐ 30 in. or less
☐ 32 in. or less
☐ 36 in. or less
☒ Other

STONE DEPTH (IN.):

- ☐ 8 in. or less
☐ 12 in. or less
☐ 18 in. or less
☐ 24 in. or less
☒ Other

TRENCHES:

- ☐ Individual
☒ Bed

TRENCH WIDTH (IN.):

- ☐ 12 in. or less
☐ 18 in.
☐ 24 in.
☐ 36 in.
☒ 6 ft. or less
☐ 9 ft. or less
☐ Other

WAKE COUNTY HEALTH DEPARTMENT
SEPTIC TANK LAYOUT AND PERMIT

1785 30 6161

A 2952

PERMIT NO.

DATE 1-21-92

OWNER WILLARD GAY / GAYLEE VILLAGE

GENERAL CONTRACTOR

LOCATION 64 Byron St. Zebulon

LOT 20

NO. BEDROOMS 3 LOT AREA 20+

GARBAGE DISPOSAL UNIT

PERC. TEST (1) (2) (3) IPH

SIZE OF TANK 900 gal

NITRIFICATION LINE 6' x 150' 900 sq. ft.

SAND FILTER sq. ft.


WATER SUPPLY: corner

Type

Approved

Driller

LAYOUT BY M. Frank

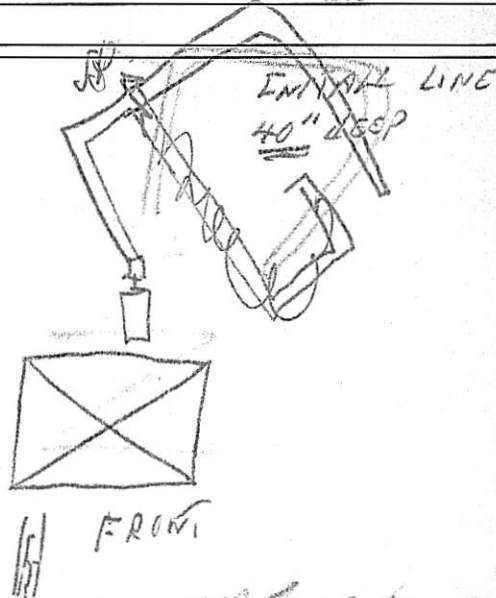

6-25-92

DATE

Edgar A. Smith

INSTALLED BY

M. Frank

APPROVED BY