

Environmental Services - Water Quality
Onsite Wastewater Scan Data Entry Form

PERMIT #: 13009881

PIN #: 0788430695

OP DATE: 0710811977

SYSTEM USE:

- ☒ House
☐ Mobile Home
☐ Business
☐ Other

SEWAGE TYPE:

- ☒ Domestic
☐ Industrial

PUMP/SIPHON?:

- ☐ Yes
☒ No

PRESSURE MANIFOLD:

- ☐ Yes
☒ No

SYSTEM TYPE:

- ☐ I
☒ II
☐ III
☐ IV
☐ V
☐ VI
☐ Other

SUB TYPE:

- ☒ A
☐ B
☐ C
☐ D
☐ E
☐ F
☐ G

NBR BEDROOMS:

- ☐ 1
☐ 2
☐ 3
☒ 4
☐ 5
☐ 6
☐ Other

MAINT. SCHEDULE:

- ☐ Yes
☒ No

CERT. OPERATOR

- ☐ Yes
☒ No

GT	ST	PT	SIZE
☐	☐		750
☐	☐	☐	900
☐	☐	☐	1,000
☐	☒	☐	1,200
☐	☐	☐	1,500
☐	☐	☐	1,800
☐	☐	☐	2,100
☐	☐	☐	2,500
☐	☐	☐	3,000
☐	☐	☐	4,000
☐	☐	☐	5,000
☐	☐	☐	8,000
☐	☐	☐	10,000
☐	☐	☐	Other
☒		☒	None/NA GT or PT

DRAINFIELD SIZE(SQ. FT.)

01200

DRAIN TYPE:

- ☒ Stone
☐ EZ Flow
☐ Infiltrator
☐ Biodiffuser
☐ Cultec
☐ Drip
☐ Hancor
☐ Large Dia. Pipe
☐ Multi-Pipe
☐ Other

MAX DEPTH (IN.):

- ☐ 12 in. or less
☐ 18 in. or less
☐ 24 in. or less
☐ 26 in. or less
☐ 28 in. or less
☐ 30 in. or less
☐ 32 in. or less
☐ 36 in. or less
☒ Other

STONE DEPTH (IN.):

- ☐ 8 in. or less
☐ 12 in. or less
☒ 18 in. or less
☐ 24 in. or less
☐ Other

TRENCHES:

- ☐ Individual
☒ Bed

TRENCH WIDTH (IN.):

- ☐ 12 in. or less
☐ 18 in.
☐ 24 in.
☐ 36 in.
☒ 6 ft. or less
☐ 9 ft. or less
☐ Other

* PERMIT VOID IF NOT IN COMPLIANCE WITH ZONING REGULATIONS

TAX MAP NO. 299
PARCEL NO. 10.51

WAKE COUNTY HEALTH DEPARTMENT
SEPTIC TANK LAYOUT AND PERMIT

PERMIT NO. **B**

OWNER OR CONTRACTOR Myrick Const Co

DATE 3-3-77

LOCATION Woody Hill Rd. * Gunner requested ditch to be clear

should be ok

S. R. NO. 1822

SUBDIVISION NAME Springdale Est.

LOT NO. 226

SECTION OR BLOCK NO. 2

GARBAGE DISPOSAL UNIT YES ☐ NO ☒

HOUSE ☒ MOBILE HOME ☐ BUSINESS ☐

NO. BEDROOMS 4 LOT AREA 20,000 sq. ft.

SIZE OF TANK 1200 gal.


NITRIFICATION LINE 1200 (200' x 6') sq. ft.

DEPTH OF STONE IN LINES: 12" ☐ 18" ☒

WATER SUPPLY: INDIVIDUAL ☐ PUBLIC ☒

* PERMIT VOID 12 MONTHS FROM DATE OF ISSUANCE.

LAYOUT BY At Wand, R. H.

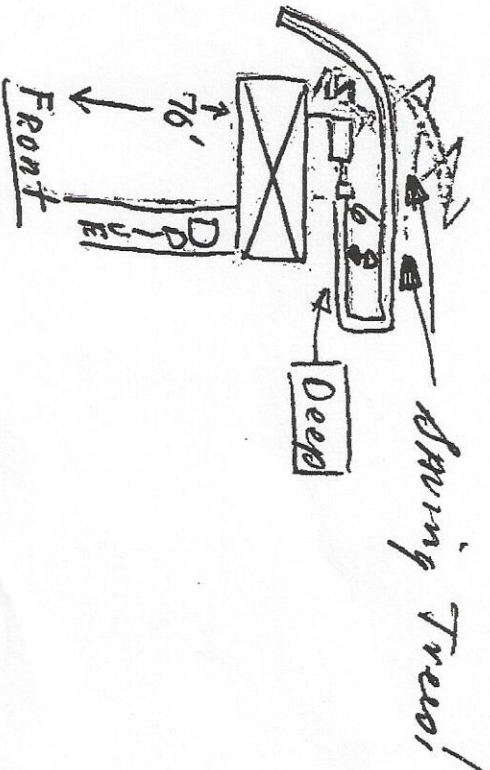

DATE 3-8-77 J. Barkley

INSTALLED BY

APPROVED BY At Wand