

Environmental Services - Water Quality
Onsite Wastewater Scan Data Entry Form

PERMIT #: 0054557

PIN #: 1618440449

OP DATE: 0610212016

SYSTEM USE:

- ☒ House
☐ Mobile Home
☐ Business
☐ Other

SEWAGE TYPE:

- ☒ Domestic
☐ Industrial

PUMP/SIPHON?:

- ☐ Yes
☒ No

PRESSURE MANIFOLD:

- ☐ Yes
☒ No

SYSTEM TYPE:

- ☐ I
☒ II
☐ III
☐ IV
☐ V
☐ VI
☐ Other

SUB TYPE:

- ☒ A
☐ B
☐ C
☐ D
☐ E
☐ F
☐ G

NBR BEDROOMS:

- ☐ 1
☐ 2
☐ 3
☒ 4
☐ 5
☐ 6
☐ Other

MAINT. SCHEDULE:

- ☐ Yes
☒ No

CERT. OPERATOR

- ☐ Yes
☐ No

GT ST PT

- | | | | |
|-------------------------------------|-------------------------------------|-------------------------------------|------------------|
| ☐ | ☐ | | 750 |
| ☐ | ☐ | ☐ | 900 |
| ☐ | ☐ | ☐ | 1,000 |
| ☐ | ☐ | ☐ | 1,200 |
| ☐ | ☐ | ☐ | 1,500 |
| ☐ | ☐ | ☐ | 1,800 |
| ☐ | ☐ | ☐ | 2,100 |
| ☐ | ☐ | ☐ | 2,500 |
| ☐ | ☐ | ☐ | 3,000 |
| ☐ | ☐ | ☐ | 4,000 |
| ☐ | ☐ | ☐ | 5,000 |
| ☐ | ☐ | ☐ | 8,000 |
| ☐ | ☐ | ☐ | 10,000 |
| ☐ | ☒ | ☐ | Other |
| ☒ | ☐ | ☒ | None/NA GT or PT |

DRAINFIELD SIZE(SQ. FT.)

01080

DRAIN TYPE:

- ☐ Stone
☒ EZ Flow
☐ Infiltrator
☐ Biodiffuser
☐ Cultec
☐ Drip
☐ Hancor
☐ Large Dia. Pipe
☐ Multi-Pipe
☐ Other

MAX DEPTH (IN.):

- ☐ 12 in. or less
☐ 18 in. or less
☐ 24 in. or less
☐ 26 in. or less
☐ 28 in. or less
☐ 30 in. or less
☐ 32 in. or less
☐ 36 in. or less
☒ Other 23"

STONE DEPTH (IN.):

- ☐ 8 in. or less
☒ 12 in. or less
☐ 18 in. or less
☐ 24 in. or less
☐ Other

TRENCHES:

- ☒ Individual
☐ Bed

TRENCH WIDTH (IN.):

- ☐ 12 in. or less
☐ 18 in.
☐ 24 in.
☒ 36 in.
☐ 6 ft. or less
☐ 9 ft. or less
☐ Other

TAH

WAKE COUNTY DEPARTMENT OF ENVIRONMENTAL SERVICES WELL AND SEWAGE SITE LOCATION PERMIT

NO PERMIT(S) FOR CONSTRUCTION, LOCATION OR RELOCATION ACTIVITY SHALL BE ISSUED

UNTIL AN AUTHORIZATION FOR WASTEWATER SYSTEM CONSTRUCTION HAS BEEN ISSUED

PERMIT VOID IF NOT IN COMPLIANCE WITH ZONING REGULATIONS AND/ OR IF SITE IS ALTERED OR INTENDED USE CHANGED

PERMIT#: **D054557** STATUS: **A** APP. DATE: **02/12/2016** BLDG. PERMIT#: **0162405**
 PIN: **1618 44 0449 000** TAX MAP: **0** RECORDED: **Y** ORIG. PERMIT#:
 TOWNSHIP: **15 PANTHER BRANCH** JURISDICTION: **WC** ZONING: **HD** SW DEVICE: **N S#:**
 APPLICANT: **CAPITOL CITY HOMES LLC** (919) 744 - 9949
5711 SIX FORKS RD STE 200 RALEIGH, NC 27609
 USE: **HD USE: 101A CONVENTIONAL ONE-FAMILY HOUSE** EXIST USE:
LTAR: 0.35 0.35 BEDROOMS: 4 BASEMENT: N #EMPLOYEES: 0
 SITE: **ADDRESS: 1025 SKY WAVE TRL**
SUBDIVISION: HEATHER GLEN LOT: 06 ACRES: 0.53 EASEMENT: N LOC: SYS:
 DIRECTION: **HWY 42 R HWY 50 L 1010 L JORDAN L SKY WAVE**

Well System: WATER: COMMUNITY - TYPE:

WELL LOG INFORMATION: DEPTH: _____ CASING DEPTH: _____ YIELD: _____ STATIC LEVEL: _____
 WELL CONTRACTOR: _____ REG.# _____ PUMP CONTRACTOR: _____ REG.# _____
 Construction Compliance GROUT APPROVED ☐ DATE _____ EHS _____
 WELLHEAD APPROVED ☐ DATE _____ EHS _____
 SYSTEM FINALIZED ☐ DATE _____ EHS _____

COMMENTS: **COMMUNITY WATER**

Operation Permit

DESIGN FLOW: _____ gal./min. ACTUAL FLOW: _____ DOSE VOLUME: _____ gal. INNOVATIVE LETTER: _____
 INSTALLED BY: Brantley's INSTALLATION APPROVED BY: [Signature]
 PROPRIETARY SYSTEM: E2Flow TYPE SYSTEM: **II A**
 COMMENTS: _____
 OPERATIONS PERMIT ISSUED? Y OP DATE: 6-2-16 BY: [Signature]

 Systems defined as either a Type IIIb, IIIg with a pump, IV, V or VI, in accordance with the North Carolina Administrative Code 15A NCAC 18A .1961, Table 1 as adopted by reference in the "Regulations Governing Wastewater Treatment and Dispersal Systems in Wake County", require Wake County Environmental Services to conduct periodic inspections on this type system, pursuant to 15A NCAC 18A .1961 (j). Fees for these inspections will be charged as per the approve Fee Schedule. In addition, all systems are to be operated and maintained as specified in 15A NCAC 18A .1961. This permit is based in part on information provided by the homeowner or his/her representative in the application submitted for this permit. The Environmental Health Specialist is not responsible for false or misleading information contained in the application. The Environmental Health Specialist is also not responsible for concealed conditions on the property or for statements in this report that may have resulted from false or misleading statements provided to him in the application. Neither Wake County nor the Environmental Health Specialist warrants that the septic tank system will continue to function satisfactorily in the future or that the water supply will remain potable.

As Built Information:

Date: 6-2-16 Benchmark: TS Rod reading: 2'10 1/2" Distance to Structure: 12'
 ST: 1250 gals ID#: 08 558 323 D.O.M.: 1-18-16 Elev.: 2'10 1/2" Distance to Well: 2'
 PT: _____ gals ID#: _____ D.O.M.: _____ Elev.: _____ Distance to P/L: 2'10"
 GT: _____ gals ID#: _____ D.O.M.: _____ Elev.: _____ Pretreatment: _____
 D-box/FD/PM elev.: 4'11 1/2" Supply Line: _____ ft. Pump/Ctrl Panel: _____ Filter: _____
 Line 1: 5'8" _____ Date: _____ Line 6: _____ Date: _____
 Line 2: 5'9" _____ Date: _____ Line 7: _____ Date: _____
 Line 3: 6'3" _____ Date: _____ Line 8: _____ Date: _____
 Line 4: 6'5" _____ Date: _____ Line 9: _____ Date: _____
 Line 5: _____ Date: _____ Line 10: _____ Date: _____
 ETM1: _____ CC1: _____ ETM2: _____ CC2: _____ OR: _____ AC: _____ WM: _____
 Notes: _____

WAKE COUNTY DEPARTMENT OF ENVIRONMENTAL SERVICES WELL AND SEWAGE SITE LOCATION PERMIT

NO PERMIT(S) FOR CONSTRUCTION, LOCATION OR RELOCATION ACTIVITY SHALL BE ISSUED

UNTIL AN AUTHORIZATION FOR WASTEWATER SYSTEM CONSTRUCTION HAS BEEN ISSUED

PERMIT VOID IF NOT IN COMPLIANCE WITH ZONING REGULATIONS AND/ OR IF SITE IS ALTERED OR INTENDED USE CHANGED

PERMIT#: D054557 STATUS: A APP. DATE: 02/12/2016 BLDG. PERMIT#: 0162405
PIN: 1618 44 0449 000 TAX MAP: 0 RECORDED: Y ORIG. PERMIT#:
TOWNSHIP: 15 PANTHER BRANCH JURISDICTION: WC ZONING: HD SW DEVICE: N S#:
APPLICANT: CAPITOL CITY HOMES LLC (919) 744 - 9949
5711 SIX FORKS RD STE 200 RALEIGH, NC 27609
HD USE: 101A CONVENTIONAL ONE-FAMILY HOUSE EXIST USE: DESIGN FEE REQ?: PAID?:
LTAR: 0.35 0.35 BEDROOMS: 4 BASEMENT: N #EMPLOYEES: 0 FOUNDATION DRAIN: Y
SITE: ADDRESS: 1025 SKY WAVE TRL
SUBDIVISION: HEATHER GLEN LOT: 06 ACRES: 0.53 EASEMENT: N LOC: SYS:
DIRECTION: HWY 42 R HWY 50 L 1010 L JORDAN L SKY WAVE

IMPROVEMENT PERMIT


[] As per GS 130A-335 (f), Improvement Permit is based on a Site Plan and is void Sixty (60) months from date of issuance.

[X] As per GS 130A-335 (f), Improvement Permit is based on a Plat and is valid without expiration.

Permit is subject to revocation if the site plan or plat, whichever is applicable, or the intended use changes.

TANK SIZE: 1200 gal. PUMP Tank: ____ gal. GREASE TRAP: ____ gal. SQ FT: 1080 STONE DEPTH: ____ in. MAX DEPTH LINE: 23 in.
WASTEWATER: INDIVIDUAL SEWAGE: DOMESTIC TYPE SYSTEM: II A PUMP: N P/M: N LP: ____ TD: ____
DAILY FLOW: 480 gal/day WATER: COMMUNITY PRETREATMENT: NA FILL: DAF: DEEP: REDUCE35%:

COMMENTS:

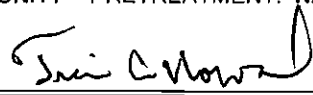IP ISSUED? Y DATE: 02/19/2016 BY: (TAH)  PHONE#: (919)-369-5974

AUTHORIZATION FOR WASTEWATER/WATER SYSTEM CONSTRUCTION


VALIDITY CONCURRENT WITH THE IMPROVEMENT PERMIT

AUTHORIZATION CONDITIONS:


Contractors shall install system on contours, see attached site plan for wastewater system design and well location. No underground utilities, water lines or sprinkler systems may be located in the original system or repair areas. A septic tank filter with a riser for access is required. The wastewater system shall not be covered or placed into use until inspected by the Wake County Department of Environmental Services and an Operation Permit issued. An Accepted Status System may be used in place of conventional system, if it can be placed in the permitted/authorized trench footprint (except reduction in line length and/or number as allowed for in approval) and the installation is in accordance with the accepted system approval, without unauthorized product alteration. If permit required use of an Accepted Status System, substitution with another accepted status system may be made, as long as no changes are necessary in the location of each nitrification line (including any increase in line length), trench depth or effluent distribution method. If changes are necessary, prior approval by this office is required before system installation.

OTHER CONDITIONS: SYSTEM DESIGNED AS AN ACCEPTED STATUS SYSTEM WITH A 25% REDUCTION TAKEN IN DRAINLINE LENGTH. THERE WILL BE A 1200 GALLON SEPTIC TANK THAT WILL GRAVITY FEED A DISTRIBUTION BOX AND 4-90'X 3' INNOVATIVE DRAINLINES. THE MAXIMUM TRENCH DEPTH IS 23". THE REPAIR IS A PRESSURE MANIFOLD LOCATED ABOVE. THERE SHALL BE NO GRADING OR FILLING OF SOIL MATERIAL WITHIN THE INITIAL OR REPAIR SEPTIC AREAS. PLEASE CALL WITH QUESTIONS, CHANGES, OR CONCERNS. TAH

TANK SIZE: 1200 gal. PUMP TANK: ____ gal. GREASE TRAP: ____ gal. SQ FT: 1080 STONE DEPTH: ____ in. MAX DEPTH LINE: 23 in
MAINT: N OPER: N L/O: Y TRENCH#: 4 LENGTH: 90 ft. WIDTH: 36 in. DESIGNER: ____
SUBFIELDS: ____ DESIGN HEAD PRESSURE: ____ DESIGN FLOW: ____ gal/min DOSE VOLUME: ____ gal. PRETREATMENT: NA

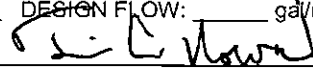CA ISSUED? Y DATE: 02/22/2016 BY: (TAH)  PHONE#: (919)-369-5974

2-23-16 

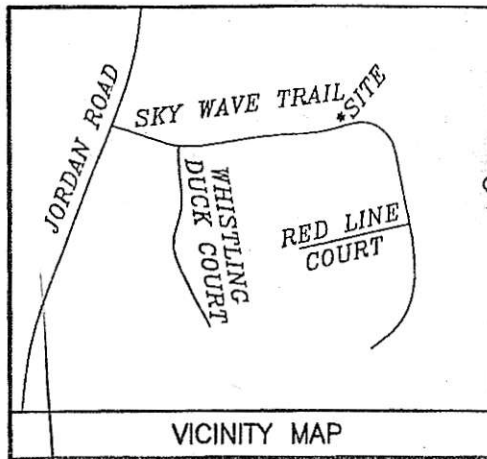

IMPERVIOUS SURFACE COVERAGE
 2622 SQ.FT. - HOUSE, GARAGE & PORCHES
 133 SQ.FT. - WALK & STEPS
 476 SQ.FT. - DRIVEWAY
 3231 TOTAL SQ.FT. - PROPOSED COVERAGE
 5000 SQ.FT. ALLOWABLE COVERAGE
 1769 SQ.FT. - AVAILABLE COVERAGE

PROPERTY ADDRESS:
 1025 SKY WAVE TRAIL
 RALEIGH, NC

NOTE: THIS PROPERTY IS SUBJECT TO
 EASEMENTS AND RESTRICTIONS OF RECORD.
 PRELIMINARY PLAT- NOT FOR RECORDATION,
 CONVEYANCES, OR SALES.

NOTE: BEING LOT 6 OF HEATHER GLEN SUBDIVISION,
 RECORDED IN BOOK OF MAPS 2015 PAGES 1866-1871.

NOTE: AREA COMPUTED BY COORDINATE METHOD.
 NOTE: PREVIOUSLY RECORDED MAP TIED TO GRID.

NOTE: MAINTENANCE OF THE PUBLIC DRAINAGE EASEMENT IS THE RESPONSIBILITY OF THE UNDERLYING
 PROPERTY OWNER(S). THE EASEMENT ALLOWS THE NCDOT THE RIGHT TO ACCESS THE DRAINAGE
 EASEMENTS AND PERFORM WORK IT DEEMS NECESSARY OR PRUDENT TO ALLEVIATE ANY ISSUES
 JEOPARDIZING THE INTEGRITY OF THE ROADWAY. IT IS THE RESPONSIBILITY OF THE UNDERLYING
 PROPERTY OWNERS(S) TO MAINTAIN THE EASEMENT TO ALLOW CONVEYANCE OF STORMWATER.

PROPERTY FRONTAGE SHALL NOT BE PIPED WITHOUT AN APPROVED ENCROACHMENT FROM NCDOT.

IT SHALL BE THE RESPONSIBILITY OF THE PROPERTY OWNERS TO MAINTAIN THE DRAINAGE EASEMENTS
 AND ANY DRAINAGE STRUCTURES THEREIN, SO AS TO MAINTAIN THE INTEGRITY OF THE DRAINAGE
 SYSTEM AND ENSURE POSITIVE DRAINAGE. EASEMENTS MAY NOT BE PIPED WITHOUT RECEIVING PLAN
 APPROVAL FROM WAKE COUNTY.

EASEMENTS ARE CENTERED OVER STRUCTURES UNLESS OTHERWISE SHOWN.

"I, Danny D. Williams, certify that this map was drawn under my supervision that
 the boundaries not surveyed are indicated as drawn from information in Book of
 Maps 2015 Pgs 1866-1871 that the ratio of precision or positional accuracy is
 1/10,000, and that this map meets the requirements of the Standards of Practice
 for Land Surveying in North Carolina, N.C. 66-600."

This 4th day of FEBRUARY, 2016


Seal



NOTE: NOT AN ACTUAL FIELD SURVEY. INFORMATION TAKEN FROM BOOK OF MAPS 2015
 PGS 1866-1871.

WILLIAMS - PEARCE and ASSOCIATES, P.A.
 PROFESSIONAL LAND SURVEYORS, P.A.
 1000 N. ARENDELL AVE.
 BOX 892, ZEBULON, N.C. 27597
 919-269-9605 LIC. # C-0243

WILLIAM & ELIZABETH
 CROCKER REVOCABLE TRUSTS
 DB 7666 PG 750 BM 1995 PG
 1532

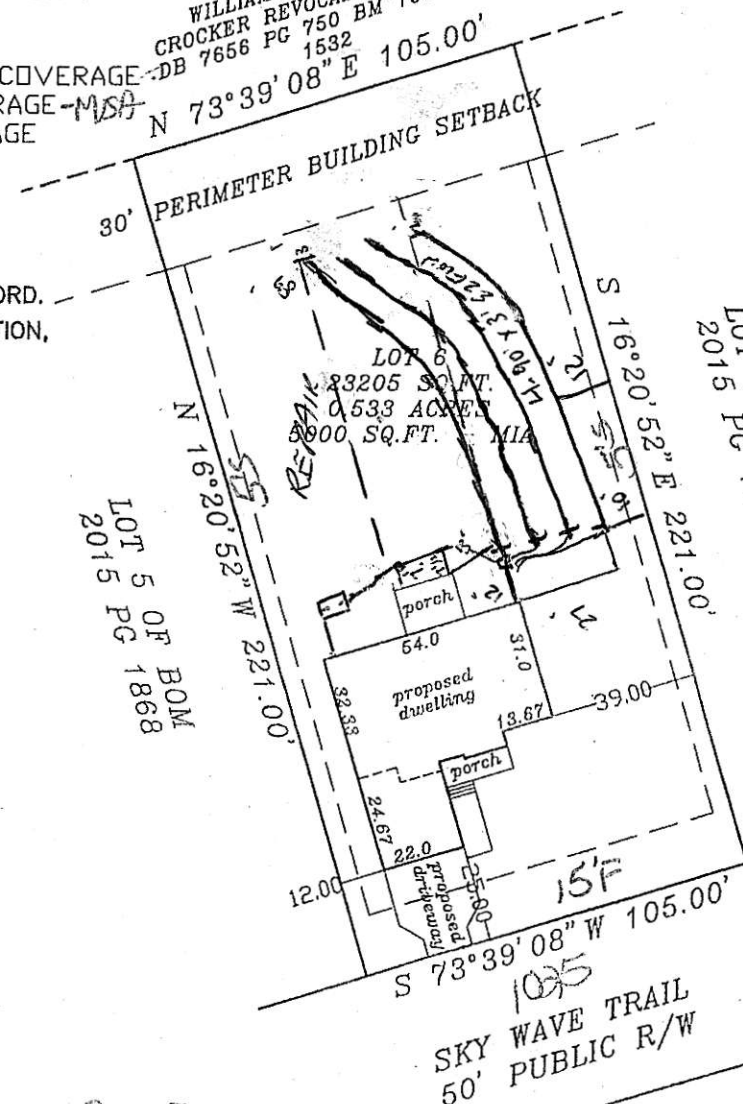


PLOT PLAN FOR CAPITOL CITY HOMES, LLC. PANTHER BRANCH TOWNSHIP WAKE COUNTY NORTH CAROLINA

I certify that the location of planned or existing structure(s)
 are accurately shown. I understand failure to locate
 structures in accordance with this plot plan may
 require the relocation of structure(s) regardless
 degree of completion. I hereby grant permission to
 Municipal/County Representatives the right of entry
 to make evaluations or inspections upon this property.

Signature of Owner or Authorized Agent


Pin-101844049


ADDED BOM 2015 PGS 1866-1871

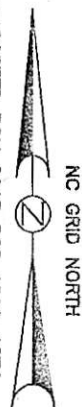

Zoning HD By KAS
 Approve X Date 2-12-16
 Reviso Use 101A
 Reject MAIL
 Front 15 Rear 15
 Side 5 Corner 5
 Comments: SED-CLOS

DRAWN BY: DOW & BGW
 CHECKED BY: DOW
 DATE: 02-04-2016
 SCALE: 1" = 50'
 JOB: BGW2600 CF

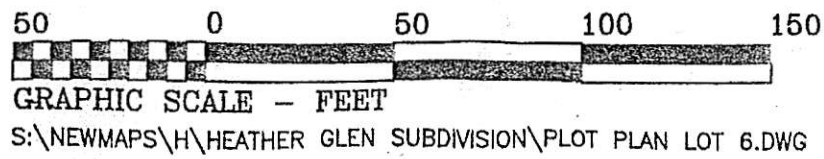

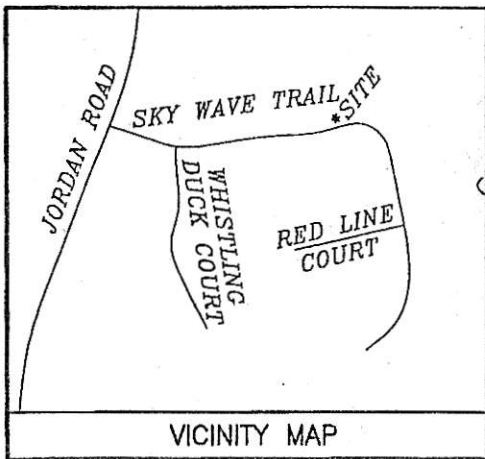

IMPERVIOUS SURFACE COVERAGE
 2622 SQ.FT. - HOUSE, GARAGE & PORCHES
 133 SQ.FT. - WALK & STEPS
 476 SQ.FT. - DRIVEWAY
 3231 TOTAL SQ.FT. - PROPOSED COVERAGE
 5000 SQ.FT. ALLOWABLE COVERAGE - MSA
 1769 SQ.FT. - AVAILABLE COVERAGE

PROPERTY ADDRESS:
 1025 SKY WAVE TRAIL
 RALEIGH, NC

NOTE: THIS PROPERTY IS SUBJECT TO
 EASEMENTS AND RESTRICTIONS OF RECORD.

PRELIMINARY PLAT- NOT FOR RECORDATION,
 CONVEYANCES, OR SALES.

NOTE: BEING LOT 6 OF HEATHER GLEN SUBDIVISION,
 RECORDED IN BOOK OF MAPS 2015 PAGES 1866-1871.

NOTE: AREA COMPUTED BY COORDINATE METHOD.
 NOTE: PREVIOUSLY RECORDED MAP TIED TO GRID.

NOTE:
 MAINTENANCE OF THE PUBLIC DRAINAGE EASEMENT IS THE RESPONSIBILITY OF THE UNDERLYING
 PROPERTY OWNER(S). THE EASEMENT ALLOWS THE NCDOT THE RIGHT TO ACCESS THE DRAINAGE
 EASEMENTS AND PERFORM WORK IT DEEMS NECESSARY OR PRUDENT TO ALLEVIATE ANY ISSUES
 JEOPARDIZING THE INTEGRITY OF THE ROADWAY. IT IS THE RESPONSIBILITY OF THE UNDERLYING
 PROPERTY OWNERS(S) TO MAINTAIN THE EASEMENT TO ALLOW CONVEYANCE OF STORMWATER.

PROPERTY FRONTAGE SHALL NOT BE PIPED WITHOUT AN APPROVED ENCROACHMENT FROM NCDOT.

IT SHALL BE THE RESPONSIBILITY OF THE PROPERTY OWNERS TO MAINTAIN THE DRAINAGE EASEMENTS
 AND ANY DRAINAGE STRUCTURES THEREIN, SO AS TO MAINTAIN THE INTEGRITY OF THE DRAINAGE
 SYSTEM AND ENSURE POSITIVE DRAINAGE. EASEMENTS MAY NOT BE PIPED WITHOUT RECEIVING PLAN
 APPROVAL FROM WAKE COUNTY.

EASEMENTS ARE CENTERED OVER STRUCTURES UNLESS OTHERWISE SHOWN.

"I, Danny D. Williams, certify that this map was drawn under my supervision; that
 the boundaries not surveyed are indicated as drawn from information in Book of
 Maps 2015 Pgs 1866-1871; that the ratio of precision or positional accuracy is
 1:10,000; and that this map meets the requirements of the Standards of Practice
 for Land Surveying in North Carolina, N.C. 66A-002.

This 4th day of FEBRUARY, 2016


Seal



NOTE: NOT AN ACTUAL FIELD SURVEY. INFORMATION TAKEN FROM BOOK OF MAPS 2015
 PGS 1866-1871.

WILLIAMS - PEARCE and ASSOC.,
PROFESSIONAL LAND SURVEYORS, P.A.

1000 N. ARENDELL AVE.
 BOX 892, ZEBULON, N.C. 27597
 919-269-9605 LIC. # C-0243

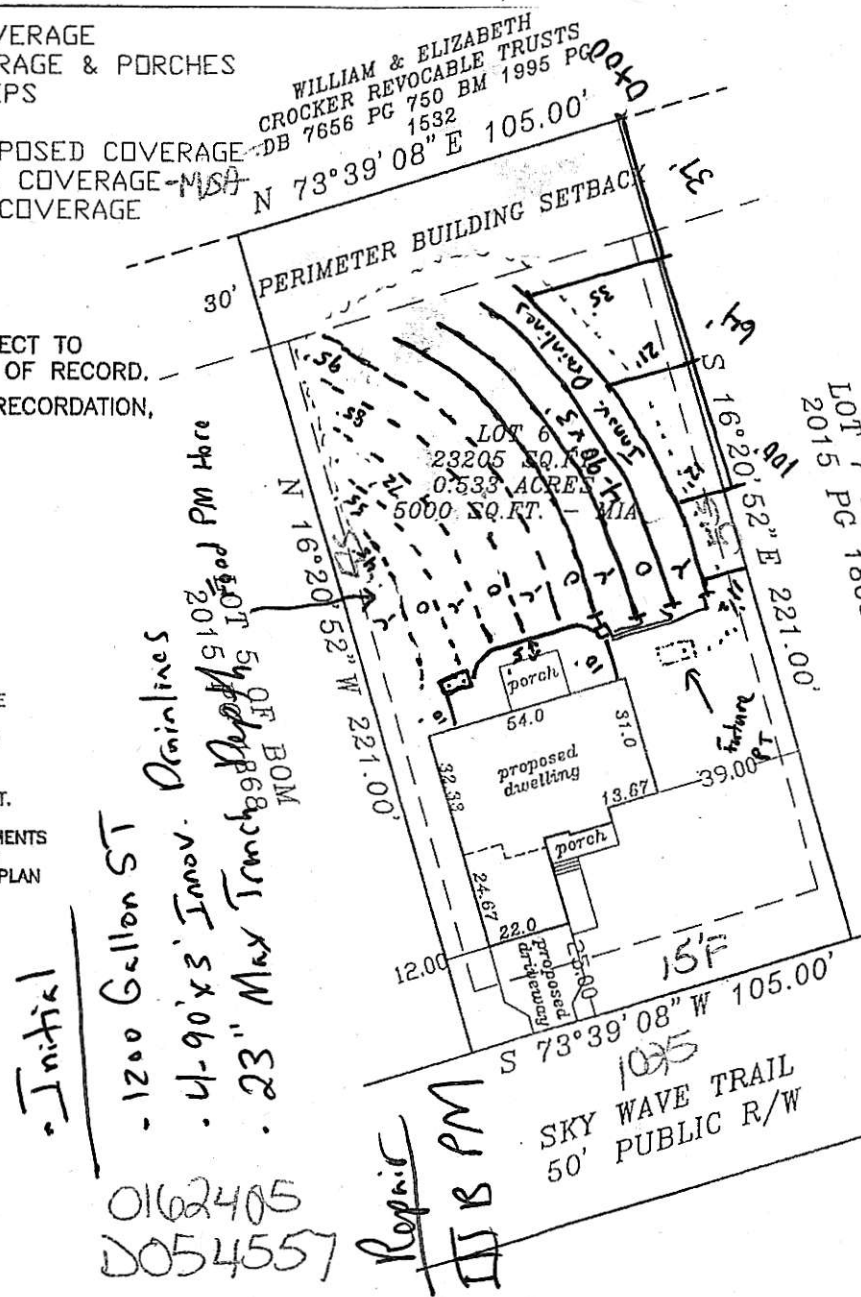

PLOT PLAN FOR CAPITOL CITY HOMES, LLC. PANTHER BRANCH TOWNSHIP WAKE COUNTY NORTH CAROLINA


I certify that the location of planned or existing structure(s)
 are accurately shown. I understand failure to locate
 structures in accordance with this plot plan may
 require the relocation of structure(s) regardless
 degree of completion. I hereby grant permission to
 Municipal/County Representatives the right of entry
 to make evaluations or inspections upon this property.


Signature of Owner or Authorized Agent

Pin-101844049

Zone	HD	By	KAS
Approve	X	Date	2-12-16
Revised		Use	101A
Reject		MDL	
Front	15	Rear	15
Side	5	Corner	
Comments:	SPD-CLOS		

DRAWN BY: DOW & BGW
 CHECKED BY: DOW
 DATE: 02-04-2016
 SCALE: 1" = 50'
 JOB: BGW2600 CF

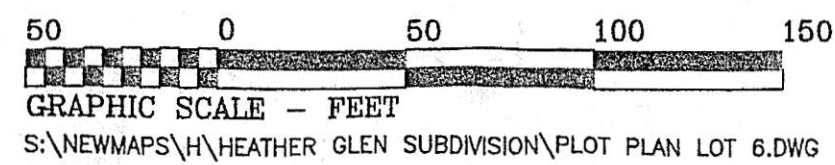

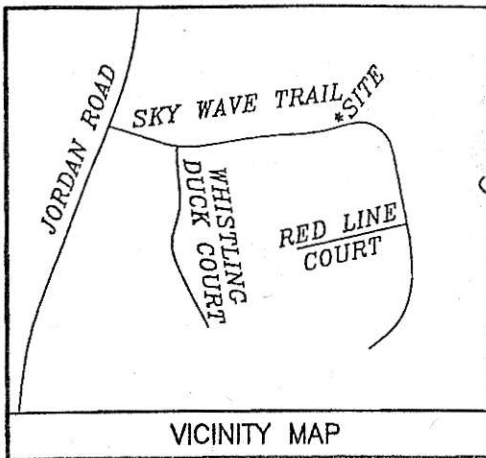

IMPERVIOUS SURFACE COVERAGE
 2622 SQ.FT. - HOUSE, GARAGE & PORCHES
 133 SQ.FT. - WALK & STEPS
 476 SQ.FT. - DRIVEWAY
 3231 TOTAL SQ.FT. - PROPOSED COVERAGE
 5000 SQ.FT. - ALLOWABLE COVERAGE - MSA
 1769 SQ.FT. - AVAILABLE COVERAGE

PROPERTY ADDRESS:
 1025 SKY WAVE TRAIL
 RALEIGH, NC

NOTE: THIS PROPERTY IS SUBJECT TO
 EASEMENTS AND RESTRICTIONS OF RECORD.
 PRELIMINARY PLAT- NOT FOR RECORDATION,
 CONVEYANCES, OR SALES.

NOTE: BEING LOT 6 OF HEATHER GLEN SUBDIVISION,
 RECORDED IN BOOK OF MAPS 2015 PAGES 1866-1871.

NOTE: AREA COMPUTED BY COORDINATE METHOD.

NOTE: PREVIOUSLY RECORDED MAP TIED TO GRID.

NOTE:
 MAINTENANCE OF THE PUBLIC DRAINAGE EASEMENT IS THE RESPONSIBILITY OF THE UNDERLYING
 PROPERTY OWNER(S). THE EASEMENT ALLOWS THE NCDOT THE RIGHT TO ACCESS THE DRAINAGE
 EASEMENTS AND PERFORM WORK IT DEEMS NECESSARY OR PRUDENT TO ALLEVIATE ANY ISSUES
 JEOPARDIZING THE INTEGRITY OF THE ROADWAY. IT IS THE RESPONSIBILITY OF THE UNDERLYING
 PROPERTY OWNERS(S) TO MAINTAIN THE EASEMENT TO ALLOW CONVEYANCE OF STORMWATER.

PROPERTY FRONTAGE SHALL NOT BE PIPED WITHOUT AN APPROVED ENCROACHMENT FROM NCDOT.

IT SHALL BE THE RESPONSIBILITY OF THE PROPERTY OWNERS TO MAINTAIN THE DRAINAGE EASEMENTS
 AND ANY DRAINAGE STRUCTURES THEREIN, SO AS TO MAINTAIN THE INTEGRITY OF THE DRAINAGE
 SYSTEM AND ENSURE POSITIVE DRAINAGE. EASEMENTS MAY NOT BE PIPED WITHOUT RECEIVING PLAN
 APPROVAL FROM WAKE COUNTY.

EASEMENTS ARE CENTERED OVER STRUCTURES UNLESS OTHERWISE SHOWN.

"I, Danny O. Williams, certify that this map was drawn under my supervision; that
 the boundaries not surveyed are indicated as drawn from information in Book of
 Maps 2015 Pgs 1866-1871; that the ratio of precision or positional accuracy is
 1:100,000; and that this map meets the requirements of The Standards of Practice
 for Land Surveying in North Carolina."

This 4th day of FEBRUARY, 2016

Seal



NOTE: NOT AN ACTUAL FIELD SURVEY. INFORMATION TAKEN FROM BOOK OF MAPS 2015
 PGS 1866-1871.

WILLIAMS - PEARCE and ASSOC.,
PROFESSIONAL LAND SURVEYORS, P.A.

1000 N. ARENDELL AVE.

BOX 892, ZEBULON, N.C. 27597

919-269-9605 LIC. # C-0243



WILLIAM & ELIZABETH
 CROCKER REVOCABLE TRUSTS
 DB 7658 PG 750 BM 1995 PG
 1532

N 73°39'08" E 105.00'


PERIMETER BUILDING SETBACK

LOT 6
 23,407 SQ. FT.
 0.538 ACRES
 5000 SQ. FT. - MSA

LOT 5 OF BOM
 2015 PG 1868

Area I want
 175' 11" 32.0'

0162405
 D054557

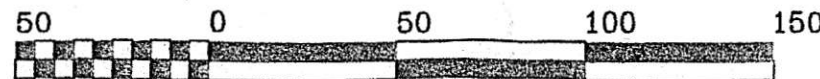

GRAPHIC SCALE - FEET

S:\NEWMAPS\H\HEATHER GLEN SUBDIVISION\LOT PLAN LOT 6.DWG

PLOT PLAN FOR CAPITOL CITY HOMES, LLC. PANTHER BRANCH TOWNSHIP WAKE COUNTY NORTH CAROLINA

I certify that the location of planned or existing structure(s)
 are accurately shown. I understand failure to locate
 structures in accordance with this plot plan may
 require the relocation of structure(s) regardless
 degree of completion. I hereby grant permission to
 Municipal/County Representatives the right of entry
 to make evaluations or inspections upon this property.

Signature of Owner or Authorized Agent

Pin-101844049

ADOPTED, BOM 2015 PGS 1866-1871

NC GRID NORTH

Zoning H/D By KAS
 Approve X Date 2-12-16
 Revise Use 101A
 Reject MDL
 Front 15 Rear 15
 Side 5 Corner 15
 Comments: SFD-Closest

DRAWN BY: DOW & BGW

CHECKED BY: DOW

DATE: 02-04-2016

SCALE: 1" = 50'

JOB: BGW2600 CF