

Environmental Services - Water Quality
Onsite Wastewater Scan Data Entry Form

PERMIT #: 0020075

PIN #: 1608411943

OP DATE: 0810812011

SYSTEM USE:

- ☒ House
☐ Mobile Home
☐ Business
☐ Other

SEWAGE TYPE:

- ☒ Domestic
☐ Industrial

PUMP/SIPHON?:

- ☐ Yes
☒ No

PRESSURE MANIFOLD:

- ☐ Yes
☒ No

SYSTEM TYPE:

- ☐ I
☒ II
☐ III
☐ IV
☐ V
☐ VI
☐ Other

SUB TYPE:

- ☒ A
☐ B
☐ C
☐ D
☐ E
☐ F
☐ G

NBR BEDROOMS:

- ☐ 1
☐ 2
☒ 3
☐ 4
☐ 5
☐ 6
☐ Other

MAINT. SCHEDULE:

- ☐ Yes
☒ No

CERT. OPERATOR

- ☐ Yes
☒ No

GT	ST	PT	SIZE
☐	☐	☐	750
☐	☐	☐	900
☐	☒	☐	1,000
☐	☐	☐	1,200
☐	☐	☐	1,500
☐	☐	☐	1,800
☐	☐	☐	2,100
☐	☐	☐	2,500
☐	☐	☐	3,000
☐	☐	☐	4,000
☐	☐	☐	5,000
☐	☐	☐	8,000
☐	☐	☐	10,000
☐	☐	☐	Other
☒		☒	None/NA GT or PT

DRAINFIELD SIZE(SQ. FT.)

00900

DRAIN TYPE:

- ☒ Stone
☐ EZ Flow
☐ Infiltrator
☐ Biodiffuser
☐ Cultec
☐ Drip
☐ Hancor
☐ Large Dia. Pipe
☐ Multi-Pipe
☐ Other

MAX DEPTH (IN.):

- ☐ 12 in. or less
☐ 18 in. or less
☒ 24 in. or less
☐ 26 in. or less
☐ 28 in. or less
☐ 30 in. or less
☐ 32 in. or less
☐ 36 in. or less
☐ Other

STONE DEPTH (IN.):

- ☐ 8 in. or less
☒ 12 in. or less
☐ 18 in. or less
☐ 24 in. or less
☐ Other

TRENCHES:

- ☒ Individual
☐ Bed

TRENCH WIDTH (IN.):

- ☐ 12 in. or less
☐ 18 in.
☐ 24 in.
☒ 36 in.
☐ 6 ft. or less
☐ 9 ft. or less
☐ Other

B.W 5/13/14

WAKE COUNTY DEPARTMENT OF ENVIRONMENTAL SERVICES WELL AND SEWAGE SITE LOCATION PERMIT
NO PERMIT(S) FOR CONSTRUCTION, LOCATION OR RELOCATION ACTIVITY SHALL BE ISSUED
UNTIL AN AUTHORIZATION FOR WASTEWATER SYSTEM CONSTRUCTION HAS BEEN ISSUED

PERMIT VOID IF NOT IN COMPLIANCE WITH ZONING REGULATIONS AND/ OR IF SITE IS ALTERED OR INTENDED USE CHANGED

PERMIT#: D020075 STATUS: A APP. DATE: 11/21/2000 BLDG. PERMIT#: 0011742
PIN: 1608.03 41 1943 000 TAX MAP: 0807 RECORDED: Y ORIG. PERMIT#:
TOWNSHIP: 15 PANTHER BRANCH JURISDICTION: WC ZONING: R30
APPLICANT: ROBERT MASSENGILL CONST.
PO BOX 1389
CLAYTON, NC 27520
(919) 550 - 0110
USE: HD USE: 101 ONE-FAMILY HOUSE
EXIST USE:
DISPOSAL: N BEDROOMS: 3 BASEMENT: N #EMPLOYEES: 0
SITE: ADDRESS: 1312 GREENBRANCH LN
SUBDIVISION: LAKE RAND PHII LOT: 39 ACRES: 0.41
DIRECTION: 401S L 1006 L 1010 R 2725 SUBD ON R ONTO MEADOW
GREEN DR LOT 58 MARKED CLUSTER SFD

Well System: WATER: COMMUNITY - TYPE: EXISTING

WELL LOG INFORMATION: DEPTH: _____ CASING DEPTH: _____ YIELD: _____ STATIC LEVEL: _____
WELL CONTRACTOR: _____ REG.# _____ PUMP CONTRACTOR: _____ REG.# _____
Construction Compliance GROUT APPROVED ☐ DATE _____ EHS _____
WELLHEAD APPROVED ☐ DATE _____ EHS _____
SYSTEM FINALIZED ☐ DATE _____ EHS _____

COMMENTS:

DESIGN FLOW: _____ gal./min. ACTUAL FLOW: _____ INNOVATIVE LETTER: _____
INSTALLED BY: Jeff Thompson INSTALLATION APPROVED BY: Scott Sloan
PROPRIETARY SYSTEM: _____ FILTER NO: _____
COMMENTS: _____
OPERATIONS PERMIT ISSUED? ☒ OP DATE: 8/2/11 BY: Scott Sloan

This permit is based in part on information provided by the homeowner or his/her representative in the application submitted for this permit. The Environmental Health Specialist is not responsible for false or misleading information contained in the application. The Environmental Health Specialist is also not responsible for concealed conditions on the property or for statements in this report that may have resulted from false or misleading statements provided to him in the application. Neither Wake County nor the Environmental Health Specialist warrants that the septic tank system will continue to function satisfactorily in the future or that the water supply will remain potable.

WAKE COUNTY DEPARTMENT OF ENVIRONMENTAL SERVICES WELL AND SEWAGE SITE LOCATION PERMIT
NO PERMIT(S) FOR CONSTRUCTION, LOCATION OR RELOCATION ACTIVITY SHALL BE ISSUED
UNTIL AN AUTHORIZATION FOR WASTEWATER SYSTEM CONSTRUCTION HAS BEEN ISSUED

PERMIT VOID IF NOT IN COMPLIANCE WITH ZONING REGULATIONS AND/ OR IF SITE IS ALTERED OR INTENDED USE CHANGED

PERMIT#: D020075 STATUS: A APP. DATE: 11/21/2000 BLDG. PERMIT#: 0011742
PIN: 1608.03 41 1943 000 TAX MAP: 0807 0000 RECORDED: Y ORIG. PERMIT#:
TOWNSHIP: 15 PANTHER BRANCH JURISDICTION: WC ZONING: R30
APPLICANT: ROBERT MASSENGILL CONST.
PO BOX 1389
CLAYTON, NC 27520
(919) 550 - 0110
USE: HD USE: 101 ONE-FAMILY HOUSE
EXIST USE:
DISPOSAL: N BEDROOMS: 3 BASEMENT: N #EMPLOYEES: 0
SITE: ADDRESS: 1312 GREENBRANCH LN
SUBDIVISION: LAKE RAND PHII LOT: 39 ACRES: 0.41
DIRECTION: 401S L 1006 L 1010 R 2725 SUBD ON R ONTO MEADOW
GREEN DR LOT 58 MARKED CLUSTER SFD

IMPROVEMENT PERMIT

TANK SIZE: 1000 gal. PUMP Tank: _____ gal. SQ FT: 900 STONE DEPTH: 12 in. MAX DEPTH LINE: 24 in.
WASTEWATER: INDIVIDUAL SEWAGE: DOMESTIC TYPE SYSTEM: II PUMP: N P/M: N
DAILY FLOW: 360 gal/day WATER: COMMUNITY

COMMENTS:

IP ISSUED? Y DATE: 04/22/2001 BY: (RJD) Ron Dudley R.S. PHONE#: 856-7435

AUTHORIZATION FOR WASTEWATER/WATER SYSTEM CONSTRUCTION

VOID SIXTY (60) MONTHS FROM DATE OF ISSUANCE

AUTHORIZATION CONDITIONS:

Contractors shall install system on contours, see attached site plan for wastewater system design and well location. No underground utilities, water lines or sprinkler systems may be located in the original system or repair areas. A septic tank filter with a riser for access is required. The wastewater system shall not be covered or placed into use until inspected by the Wake County Department of Environmental Services and an Operation Permit issued. **OTHER CONDITIONS:**
4(75X3)INSTALL ON CONTOUR.

TANK SIZE: 1000 gal. PUMP TANK: _____ gal. SQ FT: 900 STONE DEPTH: 12 in. MAX DEPTH LINE: 24 in.
MAINT: N OPER: N L/O: Y TRENCH#: 4 LENGTH: 75 ft. WIDTH: 36 in.
SUBFIELDS: _ DESIGN HEAD PRESSURE: _ DESIGN FLOW: _____ gal/min DOSE VOLUME: _____ gal.


CA ISSUED? Y DATE: 04/22/2001 BY: (RJD) Ron Dudley R.S. PHONE#: 856-7435



10/5/0
h18-815.
0001-JW
L'S

I certify that the location of planned or existing structure(s) are accurately shown. I understand failure to locate structures in accordance with this plot plan may require the relocation of structure(s) regardless degree of completion. I hereby grant permission to Municipal/County Representatives the right of entry to make evaluations or inspections upon this property.

Ella Smith
Signature of Owner or Authorized Agent

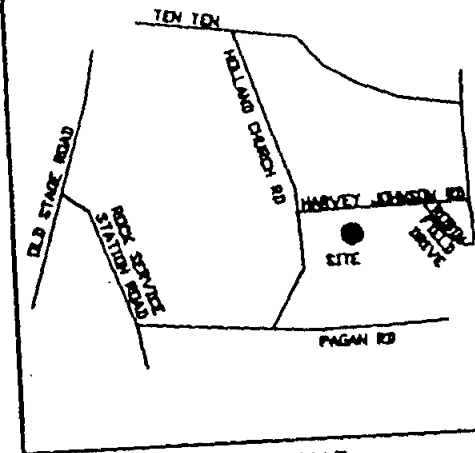


VICINITY MAP

SCALE

1312 GREENBRANCH LANE

011742
D-20075

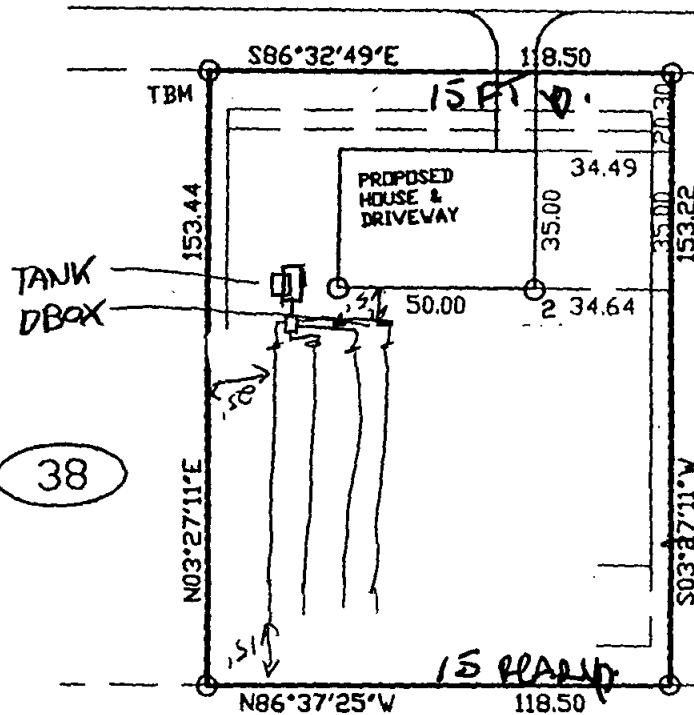

Zoning R30 By mt.
Approved ✓ Date 11/21/00
Revised _____ Use 101
Project _____ MP _____
Front 15 Rr 10
Side 5 Corner _____

Comments:

40 cluster setback
side p.


57' 11\"/>



I certify that the location of planned or existing structure(s) are accurately shown. I understand failure to locate structures in accordance with this plot plan may require the relocation of structure(s) regardless degree of completion. I hereby grant permission to Municipal/County Representatives the right of entry to make evaluations or inspections upon this property.

Ella Smith

Signature of Owner or Authorized Agent

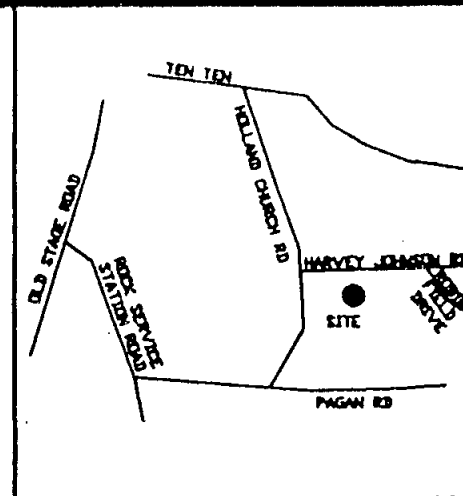


VICINITY MAP

SCALE

1312 GREENBRANCH LANE

011742
D-20075

1000 S.F.
4 (75' x 3')
24" DEPTH
to INSTALL
ON CONTOUR

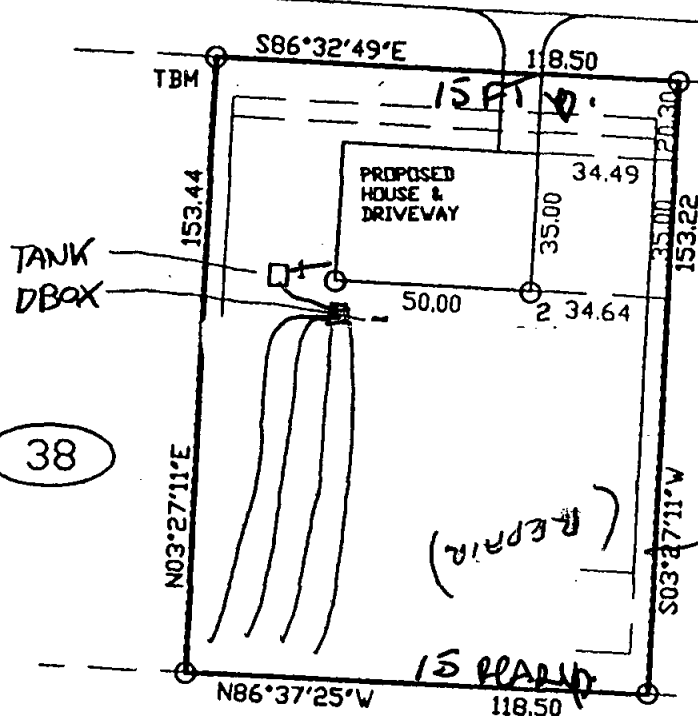

Zone R30 By MY
 Approved ✓ Date 11/21/00
 Review ✓ Use LOT
 Eject MP
 Front 15 R 15
 Side 5 Corner —

Comments:

40 cluster setback