

Environmental Services - Water Quality
Onsite Wastewater Scan Data Entry Form

PERMIT #: D013027

PIN #: 0881901671

OP DATE: 07/19/1999

SYSTEM USE:

- ☒ House
☐ Mobile Home
☐ Business
☐ Other

SEWAGE TYPE:

- ☒ Domestic
☐ Industrial

PUMP/SIPHON?:

- ☐ Yes
☒ No

PRESSURE MANIFOLD:

- ☐ Yes
☒ No

SYSTEM TYPE:

- ☐ I
☒ II
☐ III
☐ IV
☐ V
☐ VI
☐ Other

SUB TYPE:

- ☒ A
☐ B
☐ C
☐ D
☐ E
☐ F
☐ G

NBR BEDROOMS:

- ☐ 1
☐ 2
☐ 3
☒ 4
☐ 5
☐ 6
☐ Other

MAINT. SCHEDULE:

- ☐ Yes
☒ No

CERT. OPERATOR

- ☐ Yes
☒ No

GT ST PT SIZE

- | | | | |
|-------------------------------------|-------------------------------------|-------------------------------------|------------------|
| ☐ | ☐ | | 750 |
| ☐ | ☐ | ☐ | 900 |
| ☐ | ☐ | ☐ | 1,000 |
| ☐ | ☒ | ☐ | 1,200 |
| ☐ | ☐ | ☐ | 1,500 |
| ☐ | ☐ | ☐ | 1,800 |
| ☐ | ☐ | ☐ | 2,100 |
| ☐ | ☐ | ☐ | 2,500 |
| ☐ | ☐ | ☐ | 3,000 |
| ☐ | ☐ | ☐ | 4,000 |
| ☐ | ☐ | ☐ | 5,000 |
| ☐ | ☐ | ☐ | 8,000 |
| ☐ | ☐ | ☐ | 10,000 |
| ☐ | ☐ | ☐ | Other |
| ☒ | | ☒ | None/NA GT or PT |

DRAINFIELD SIZE(SQ. FT.)

01090

DRAIN TYPE:

- ☐ Stone
☒ EZ Flow
☐ Infiltrator
☐ Biodiffuser
☐ Cultec
☐ Drip
☐ Hancor
☐ Large Dia. Pipe
☐ Multi-Pipe
☐ Other

MAX DEPTH (IN.):

- ☐ 12 in. or less
☐ 18 in. or less
☐ 24 in. or less
☐ 26 in. or less
☒ 28 in. or less
☐ 30 in. or less
☐ 32 in. or less
☐ 36 in. or less
☐ Other

STONE DEPTH (IN.):

- ☐ 8 in. or less
☒ 12 in. or less
☐ 18 in. or less
☐ 24 in. or less
☐ Other

TRENCHES:

- ☒ Individual
☐ Bed

TRENCH WIDTH (IN.):

- ☐ 12 in. or less
☐ 18 in.
☐ 24 in.
☒ 36 in.
☐ 6 ft. or less
☐ 9 ft. or less
☐ Other

DH

PERMIT VOID IF NOT IN COMPLIANCE WITH ZONING REGULATIONS AND/ OR IF SITE IS ALTERED OR INTENDED USE CHANGED

This permit is based in part on information provided by the homeowner or his/her representative in the application submitted for this permit. The Environmental Health Specialist is not responsible for false or misleading information contained in the application. The Environmental Health Specialist is also not responsible for concealed conditions on the property or for statements in this report that may have resulted from false or misleading statements provided to him in the application. Neither Wake County nor the Environmental Health Specialist warrants that the septic tank system will continue to function satisfactorily in the future or that the water supply will remain potable.



#0992346
D-13027

I certify that the location of planned or existing structure(s) are accurately shown. I understand failure to locate structures in accordance with this plot plan may require the relocation of structure(s) regardless degree of completion. I hereby grant permission to Municipal/County Representatives the right of entry to make evaluations or inspections upon this property.

Signature of Owner or Authorized Agent


Zoning R40W By SWM
 Approve ✓ Date 02/4/99
 Revise _____ Use 101
 Reject _____ MBL 30
 Front 30' Rear 30'
 Side 15' Corner _____
 Comments: Typical Setback

15' F
7.5' S
15' R

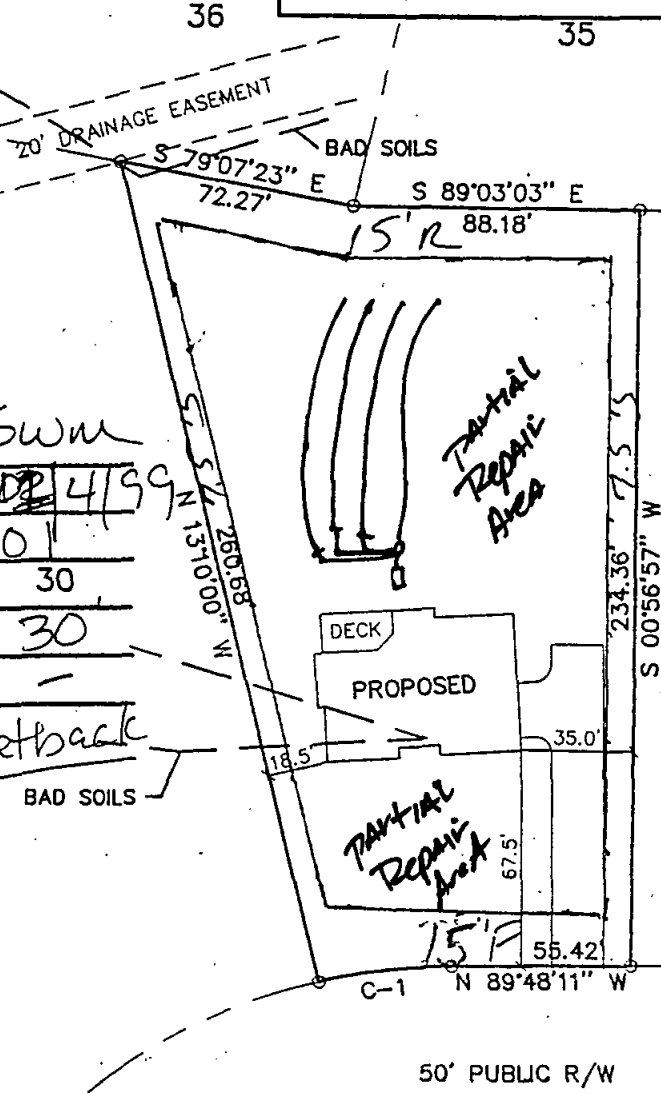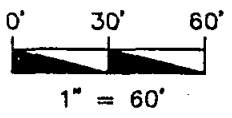

AS Built
Copy

[Handwritten signature]

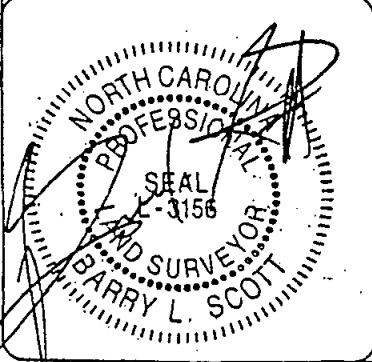

12.21.98

PIN#: 0000.00 00 0000 TOWNSHIP: BARTON'S CREEK ZONE:
 LOT 31 MOUNT VERNON CROSSING, (PROPOSED) AS RECORDED IN
 BOM 0000, PAGE 0000 W.C.R.

MORTGAGE SURVEY

PROPERTY OF
 CREECH CONSTRUCTION

0000 XXXXXXXXXX XXXXX WAKE COUNTY RALEIGH, N.C.

SCALE: 1" = 60'



I declare that this survey complies with the North Carolina Standards of Practice for Surveying (section. 1600) for Class A Surveys and that the calculated ratio of precision before adjustments is 1:10,000+. Furthermore, building corners shown are primary control monumentation for the re-establishment of property corners in the absence of grid monuments and other subdivision property corners. This survey is not to be recorded without the written authorization of the surveyor.


WAKE COUNTY

Department of Environmental Services

Water, Wastewater and Development Services

(919) 856-7400 FAX: (919) 856-7407

PO Box 550, Raleigh, NC 27602

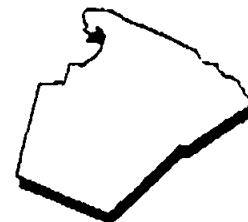

I, DAVID J. CREECH hereby request the chamber system or
OR INNOVATIVE SYSTEMS
 polystyrene aggregate system called FREEZZZLAY to

be used in my sewage disposal system. I understand that I will be

granted a 25% reduction in the amount of required drainfield for my

property. My property is located at Lot 31 Mount VERNON Crossing

7008 TRENTON Ridge Ct.

David J. Creech

Owner

7-26-99

Date

D# 013027

Bldg Permit # 0992346

PIN: 0881.04 80 2996 000

Generic Name

- ☐ Drip System
- ☐ Chamber Trench Sys.
- ☐ Brunswick Bed/Fill Sys.
- ☐ Chamber Trench Sys.
- ☐ Polystyrene Aggregate Tr
- ☐ Chamber Trench
- ☐ Polyethylene
- ☐ Sand Filter Pretreatment
- ☐ Chamber Trench
- ☐ Peat Filter Prot. Sys.
- ☐ Fibermesh Reinforced Tanks

Proprietary Name

- ☐ "Perco-Rite" Subsurface
- ☐ "Infiltrator" Chambered
- ☐ "Brunswick" Bed/Fill
- ☐ "Hanco EnviroChamber"
- ☐ Houck Drainage Sys.
- ☐ "Contractor Model 75, 100, 125, and field drain"
- ☐ Norwesco P.E. Tanks
- ☐ Pressure Dosed Sand
- ☐ "Bio Diffuser" Low Profile
- ☐ Puraflo Peat Biofilter Sys.
- ☐ Fibermesh Reinforced Tank

To protect and improve the quality of Wake County's environment and ensure a healthy future
 for its citizens through cooperation, education, management and enforcement