

Environmental Services - Water Quality
Onsite Wastewater Scan Data Entry Form

PERMIT #: B038087

PIN #: 0689031429

OP DATE: 07/06/1987

SYSTEM USE:

- ☒ House
☐ Mobile Home
☐ Business
☐ Other

SEWAGE TYPE:

- ☒ Domestic
☐ Industrial

PUMP/SIPHON?:

- ☐ Yes
☒ No

PRESSURE MANIFOLD:

- ☐ Yes
☒ No

SYSTEM TYPE:

- ☐ I
☒ II
☐ III
☐ IV
☐ V
☐ VI
☐ Other

SUB TYPE:

- ☒ A
☐ B
☐ C
☐ D
☐ E
☐ F
☐ G

NBR BEDROOMS:

- ☐ 1
☐ 2
☒ 3
☒ 4
☐ 5
☐ 6
☐ Other

MAINT. SCHEDULE:

- ☐ Yes
☒ No

CERT. OPERATOR

- ☐ Yes
☒ No

GT ST PT SIZE

- | | | | |
|-------------------------------------|-------------------------------------|-------------------------------------|------------------|
| ☐ | ☐ | | 750 |
| ☐ | ☐ | ☐ | 900 |
| ☐ | ☒ | ☐ | 1,000 |
| ☐ | ☐ | ☐ | 1,200 |
| ☐ | ☐ | ☐ | 1,500 |
| ☐ | ☐ | ☐ | 1,800 |
| ☐ | ☐ | ☐ | 2,100 |
| ☐ | ☐ | ☐ | 2,500 |
| ☐ | ☐ | ☐ | 3,000 |
| ☐ | ☐ | ☐ | 4,000 |
| ☐ | ☐ | ☐ | 5,000 |
| ☐ | ☐ | ☐ | 8,000 |
| ☐ | ☐ | ☐ | 10,000 |
| ☐ | ☐ | ☐ | Other |
| ☒ | | ☒ | None/NA GT or PT |

DRAINFIELD SIZE(SQ. FT.)

01000

DRAIN TYPE:

- ☒ Stone
☐ EZ Flow
☐ Infiltrator
☐ Biodiffuser
☐ Cultec
☐ Drip
☐ Hancor
☐ Large Dia. Pipe
☐ Multi-Pipe
☐ Other

MAX DEPTH (IN.):

- ☐ 12 in. or less
☐ 18 in. or less
☒ 24 in. or less
☐ 26 in. or less
☐ 28 in. or less
☐ 30 in. or less
☐ 32 in. or less
☐ 36 in. or less
☐ Other

STONE DEPTH (IN.):

- ☐ 8 in. or less
☒ 12 in. or less
☐ 18 in. or less
☐ 24 in. or less
☐ Other

TRENCHES:

- ☒ Individual
☐ Bed

TRENCH WIDTH (IN.):

- ☐ 12 in. or less
☐ 18 in.
☐ 24 in.
☐ 36 in.
☐ 6 ft. or less
☐ 9 ft. or less
☒ Other

Handwritten signature/initials.

APR-16-2001 11:01 FROM: WAKE CO. ENV HEALTH 9198567407 TO: 1 919 387 4627 P 002 003

Health Dept. - Mr. Steve Smith

WAKE COUNTY HEALTH DEPARTMENT SEPTIC TANK LAYOUT AND PERMIT

MAP NO. 763 PARCEL NO. 1161

PERMIT NO. 8 **38087**
OPERATION PERMIT ☐

CONTRACTOR Robuck Homes

OWNER _____ DATE 3-13-87

LOCATION 2600 New Oxford Pk.

S. R. NO. 1414

SUBDIVISION NAME Brighton Woods LOT NO. 24

SECTION OR BLOCK NO. _____

REPAIR ☐ ORIGINAL PERMIT NO. 837393

GARBAGE DISPOSAL UNIT YES ☐ NO ☒

HOUSE ☒ MOBILE HOME ☐ BUSINESS ☐

NO. BEDROOMS 3 LOT AREA 30,611 sq. ft.

SIZE OF TANK 1000 gal.

NITRIFICATION LINE 1100 ± 2 (3' x 183) sq. ft.


DEPTH OF STONE IN LINES: 12" ☒

RISER AND BAFFLE REQUIRED ☒ PUMP REQUIRED ☐

WATER SUPPLY: INDIVIDUAL ☐ PUBLIC ☒ OTHER ☐

- PERMIT VOID 36 MONTHS FROM DATE OF ISSUANCE.
- PERMIT VOID IF NOT IN COMPLIANCE WITH ZONING REGULATIONS
- PERMIT MAY BE VOIDED IF SITE ALTERATIONS MADE

LAYOUT BY S. J. [Signature]

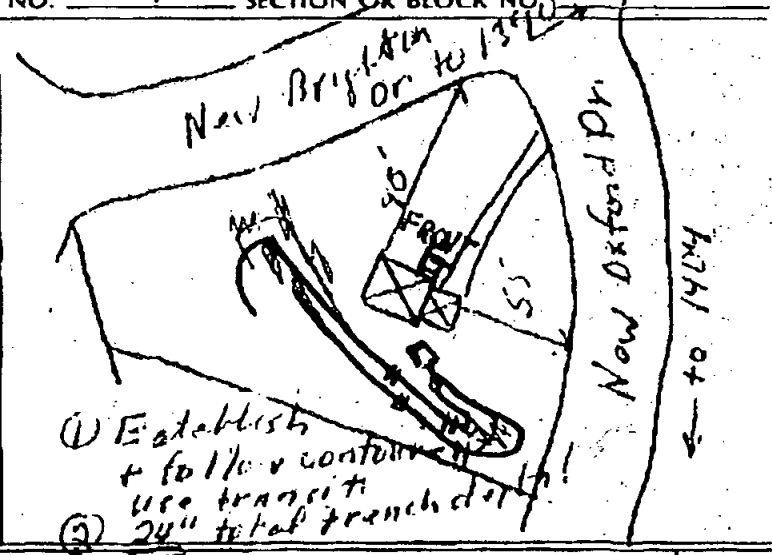

DATE 7-6-87

INSTALLED BY W. Jones [Signature]

APPROVED BY [Signature]

Department of Environmental Services

Water, Wastewater and Development Services

(919) 856-7400
Fax: (919) 856-7407

PO Box 550
Raleigh, NC 27602

Revisions that do not require a site plan

D# _____ Building Permit # _____

♦ Change # of bedrooms from 3 to 4

♦ Change name, address and/or
phone # of applicant

(_____) _____

♦ Change of Foundation _____

♦ Change of Garbage Disposal _____

♦ Change of Employees _____

Comments:

Adding 2 Car garage with Bed + Bath on
Second floor. See attached New site plan
and old septic system layout.

Applicant Signature [Signature] Date 3-20-2001
Permit Processor Shirley Carroll Date 3-10-2001

To protect and improve the quality of Wake County's environment and ensure a healthy future for its citizens through cooperation, education, management and enforcement