

Environmental Services - Water Quality
Onsite Wastewater Scan Data Entry Form

PERMIT #: **G C 0 4 7 3 5**

PIN #: **0 6 6 7 7 6 0 0 0 1**

OP DATE: **1 0 / 1 4 / 1 9 7 0**

SYSTEM USE:

- ☒ House
☐ Mobile Home
☐ Business
☐ Other

SEWAGE TYPE:

- ☒ Domestic
☐ Industrial

PUMP/SIPHON?:

- ☐ Yes
☒ No

PRESSURE MANIFOLD:

- ☐ Yes
☒ No

SYSTEM TYPE:

- ☐ I
☒ II
☐ III
☐ IV
☐ V
☐ VI
☐ Other

SUB TYPE:

- ☒ A
☐ B
☐ C
☐ D
☐ E
☐ F
☐ G

NBR BEDROOMS:

- ☐ 1
☐ 2
☒ 3
☐ 4
☐ 5
☐ 6
☐ Other

MAINT. SCHEDULE:

- ☐ Yes
☒ No

CERT. OPERATOR

- ☐ Yes
☒ No

GT	ST	PT	SIZE
☐	☐		750
☐	☒	☐	900
☐	☐	☐	1,000
☐	☐	☐	1,200
☐	☐	☐	1,500
☐	☐	☐	1,800
☐	☐	☐	2,100
☐	☐	☐	2,500
☐	☐	☐	3,000
☐	☐	☐	4,000
☐	☐	☐	5,000
☐	☐	☐	8,000
☐	☐	☐	10,000
☐	☐	☐	Other
☒		☒	None/NA GT or PT

DRAINFIELD SIZE(SQ. FT.)

0 0 9 0 0

DRAIN TYPE:

- ☒ Stone
☐ EZ Flow
☐ Infiltrator
☐ Biodiffuser
☐ Cultec
☐ Drip
☐ Hancor
☐ Large Dia. Pipe
☐ Multi-Pipe
☐ Other

MAX DEPTH (IN.):

- ☐ 12 in. or less
☐ 18 in. or less
☐ 24 in. or less
☐ 26 in. or less
☐ 28 in. or less
☐ 30 in. or less
☐ 32 in. or less
☐ 36 in. or less
☒ Other

STONE DEPTH (IN.):

- ☐ 8 in. or less
☐ 12 in. or less
☐ 18 in. or less
☐ 24 in. or less
☒ Other

TRENCHES:

- ☐ Individual
☒ Bed

TRENCH WIDTH (IN.):

- ☐ 12 in. or less
☐ 18 in.
☐ 24 in.
☐ 36 in.
☒ 6 ft. or less
☐ 9 ft. or less
☐ Other

WAKE COUNTY HEALTH DEPARTMENT
SEPTIC TANK LAYOUT AND PERMIT

PERMIT NO. **Nº 4735**

OWNER Thomas Cameron

DATE 9/15/90

GENERAL CONTRACTOR _____

LOCATION S.R. 1301 (Rt 3, Fugazy-Varina) at Valentine's Dairy

NO. BEDROOMS 3 LOT AREA 2.18 Acres

GARBAGE DISPOSAL UNIT 90,000 Sq. Ft.

PERC. TEST (1) 7" (2) 6" (3) _____ IPH

SIZE OF TANK 900 gal

NITRIFICATION LINE 900 Sq. Ft. (150' X 6') sq. ft.

SAND FILTER _____ sq. ft.

WATER SUPPLY: Drilled Well 165' deep


Type Drilled Approved

Driller

LAYOUT BY E. L. Jones

DATE 10-14-90

INSTALLED BY Garrett Wecker

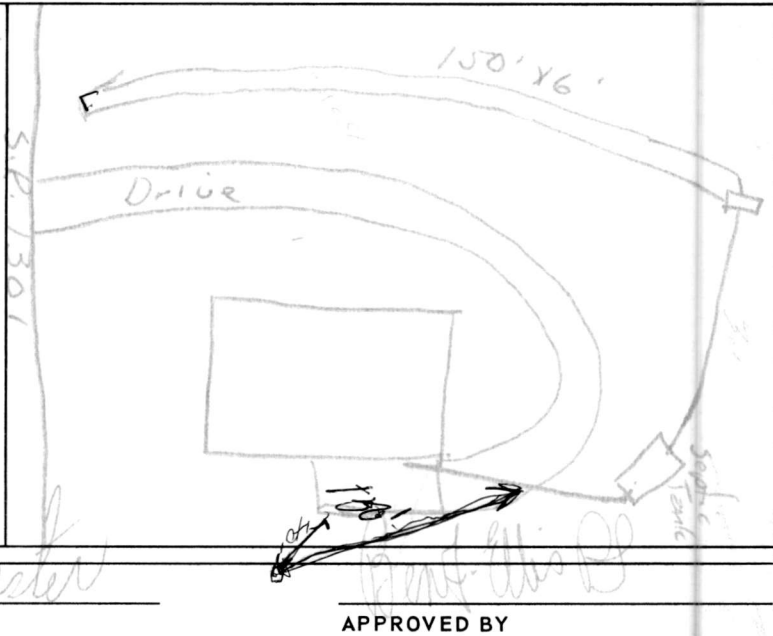

APPROVED BY [Signature]