

Environmental Services - Water Quality
Onsite Wastewater Scan Data Entry Form

PERMIT #: 0024883

PIN #: 0771624884

OP DATE: 0611011983

SYSTEM USE:

- ☒ House
☐ Mobile Home
☐ Business
☐ Other

SEWAGE TYPE:

- ☒ Domestic
☐ Industrial

PUMP/SIPHON?:

- ☐ Yes
☒ No

PRESSURE MANIFOLD:

- ☐ Yes
☒ No

SYSTEM TYPE:

- ☐ I
☒ II
☐ III
☐ IV
☐ V
☐ VI
☐ Other

SUB TYPE:

- ☒ A
☐ B
☐ C
☐ D
☐ E
☐ F
☐ G

NBR BEDROOMS:

- ☐ 1
☐ 2
☐ 3
☒ 4
☐ 5
☐ 6
☐ Other

MAINT. SCHEDULE:

- ☐ Yes
☒ No

CERT. OPERATOR

- ☐ Yes
☒ No

GT ST PT

- | | | | |
|-------------------------------------|-------------------------------------|-------------------------------------|------------------|
| ☐ | ☐ | | 750 |
| ☐ | ☐ | ☐ | 900 |
| ☐ | ☐ | ☐ | 1,000 |
| ☐ | ☒ | ☐ | 1,200 |
| ☐ | ☐ | ☐ | 1,500 |
| ☐ | ☐ | ☐ | 1,800 |
| ☐ | ☐ | ☐ | 2,100 |
| ☐ | ☐ | ☐ | 2,500 |
| ☐ | ☐ | ☐ | 3,000 |
| ☐ | ☐ | ☐ | 4,000 |
| ☐ | ☐ | ☐ | 5,000 |
| ☐ | ☐ | ☐ | 8,000 |
| ☐ | ☐ | ☐ | 10,000 |
| ☐ | ☐ | ☐ | Other |
| ☒ | | ☒ | None/NA GT or PT |

DRAINFIELD SIZE(SQ. FT.)

01200

DRAIN TYPE:

- ☒ Stone
☐ EZ Flow
☐ Infiltrator
☐ Biodiffuser
☐ Cultec
☐ Drip
☐ Hancor
☐ Large Dia. Pipe
☐ Multi-Pipe
☐ Other

MAX DEPTH (IN.):

- ☐ 12 in. or less
☐ 18 in. or less
☐ 24 in. or less
☐ 26 in. or less
☐ 28 in. or less
☐ 30 in. or less
☐ 32 in. or less
☐ 36 in. or less
☒ Other

STONE DEPTH (IN.):

- ☐ 8 in. or less
☒ 12 in. or less
☐ 18 in. or less
☐ 24 in. or less
☐ Other

TRENCHES:

- ☒ Individual
☐ Bed

TRENCH WIDTH (IN.):

- ☐ 12 in. or less
☐ 18 in.
☐ 24 in.
☒ 36 in.
☐ 6 ft. or less
☐ 9 ft. or less
☐ Other

MD
5/12/15

WAKE COUNTY HEALTH DEPARTMENT SEPTIC TANK LAYOUT AND PERMIT

TAX MAP NO. 676 PARCEL NO. 125, 126 PERMIT NO. B 24883

CONTRACTOR Lacy Buffalo Blders.

OWNER _____ DATE 10-5-82

LOCATION 0771 62 4884

S. R. NO. 1379

SUBDIVISION NAME Hunters Ridge LOT NO. 19+20 SECTION OR BLOCK NO. _____

REPAIR ☐ ORIGINAL PERMIT NO. _____

GARBAGE DISPOSAL UNIT YES ☐ NO ☒

HOUSE ☒ MOBILE HOME ☐ BUSINESS ☐

NO. BEDROOMS 4 LOT AREA ~3 AC.

SIZE OF TANK 1200 gal.

NITRIFICATION LINE 1200 2 (200'x3') sq. ft.


DEPTH OF STONE IN LINES: 12" ☐ 18" ☐

RISER AND BAFFLE REQUIRED ☐ PUMP REQUIRED ☐

WATER SUPPLY: INDIVIDUAL ☐ PUBLIC ☐ OTHER ☐

- * PERMIT VOID 36 MONTHS FROM DATE OF ISSUANCE.
- * PERMIT VOID IF NOT IN COMPLIANCE WITH ZONING REGULATIONS
- * PERMIT MAY BE VOIDED IF SITE ALTERATIONS MADE

LAYOUT BY W.A. Sapp, P.E.

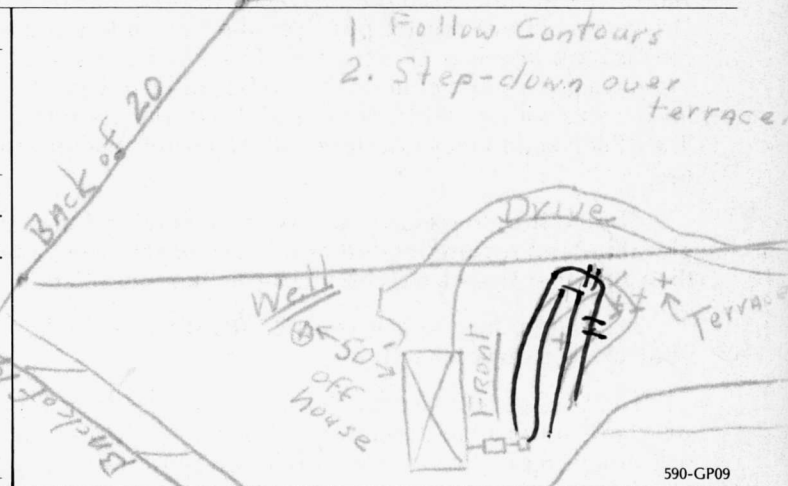

590-GP09

DATE 6-10-83

INSTALLED BY Billy Ellidge

APPROVED BY W.A. Sapp