

Environmental Services - Water Quality
Onsite Wastewater Scan Data Entry Form

PERMIT #: 0031991

PIN #: 1617360445

OP DATE: 1110112005

SYSTEM USE:

- ☒ House
☐ Mobile Home
☐ Business
☐ Other

SEWAGE TYPE:

- ☒ Domestic
☐ Industrial

PUMP/SIPHON?:

- ☐ Yes
☒ No

PRESSURE MANIFOLD:

- ☐ Yes
☒ No

SYSTEM TYPE:

- ☐ I
☒ II
☐ III
☐ IV
☐ V
☐ VI
☐ Other

SUB TYPE:

- ☒ A
☐ B
☐ C
☐ D
☐ E
☐ F
☐ G

NBR BEDROOMS:

- ☐ 1
☐ 2
☐ 3
☒ 4
☐ 5
☐ 6
☐ Other

MAINT. SCHEDULE:

- ☐ Yes
☒ No

CERT. OPERATOR

- ☐ Yes
☒ No

GT ST PT SIZE

- | | | | |
|-------------------------------------|-------------------------------------|-------------------------------------|------------------|
| ☐ | ☐ | | 750 |
| ☐ | ☐ | ☐ | 900 |
| ☐ | ☐ | ☐ | 1,000 |
| ☐ | ☒ | ☐ | 1,200 |
| ☐ | ☐ | ☐ | 1,500 |
| ☐ | ☐ | ☐ | 1,800 |
| ☐ | ☐ | ☐ | 2,100 |
| ☐ | ☐ | ☐ | 2,500 |
| ☐ | ☐ | ☐ | 3,000 |
| ☐ | ☐ | ☐ | 4,000 |
| ☐ | ☐ | ☐ | 5,000 |
| ☐ | ☐ | ☐ | 8,000 |
| ☐ | ☐ | ☐ | 10,000 |
| ☐ | ☐ | ☐ | Other |
| ☒ | | ☒ | None/NA GT or PT |

DRAINFIELD SIZE(SQ. FT.)

01350

Include permit

w - 1804

w - 1583

DRAIN TYPE:

- ☒ Stone
☐ EZ Flow
☐ Infiltrator
☐ Biodiffuser
☐ Cultec
☐ Drip
☐ Hancor
☐ Large Dia. Pipe
☐ Multi-Pipe
☐ Other

MAX DEPTH (IN.):

- ☐ 12 in. or less
☐ 18 in. or less
☒ 24 in. or less
☐ 26 in. or less
☐ 28 in. or less
☐ 30 in. or less
☐ 32 in. or less
☐ 36 in. or less
☐ Other

STONE DEPTH (IN.):

- ☐ 8 in. or less
☒ 12 in. or less
☐ 18 in. or less
☐ 24 in. or less
☐ Other

TRENCHES:

- ☒ Individual
☐ Bed

TRENCH WIDTH (IN.):

- ☐ 12 in. or less
☐ 18 in.
☐ 24 in.
☒ 36 in.
☐ 6 ft. or less
☐ 9 ft. or less
☐ Other

B.W 11/5/13

517 Jordan Rd.
Mike Co.

area = 4330 sf.

curb & Pad
3560 sf.


8290 sf

Size:
144184

70% of lot

351511
31990

AS BUILT

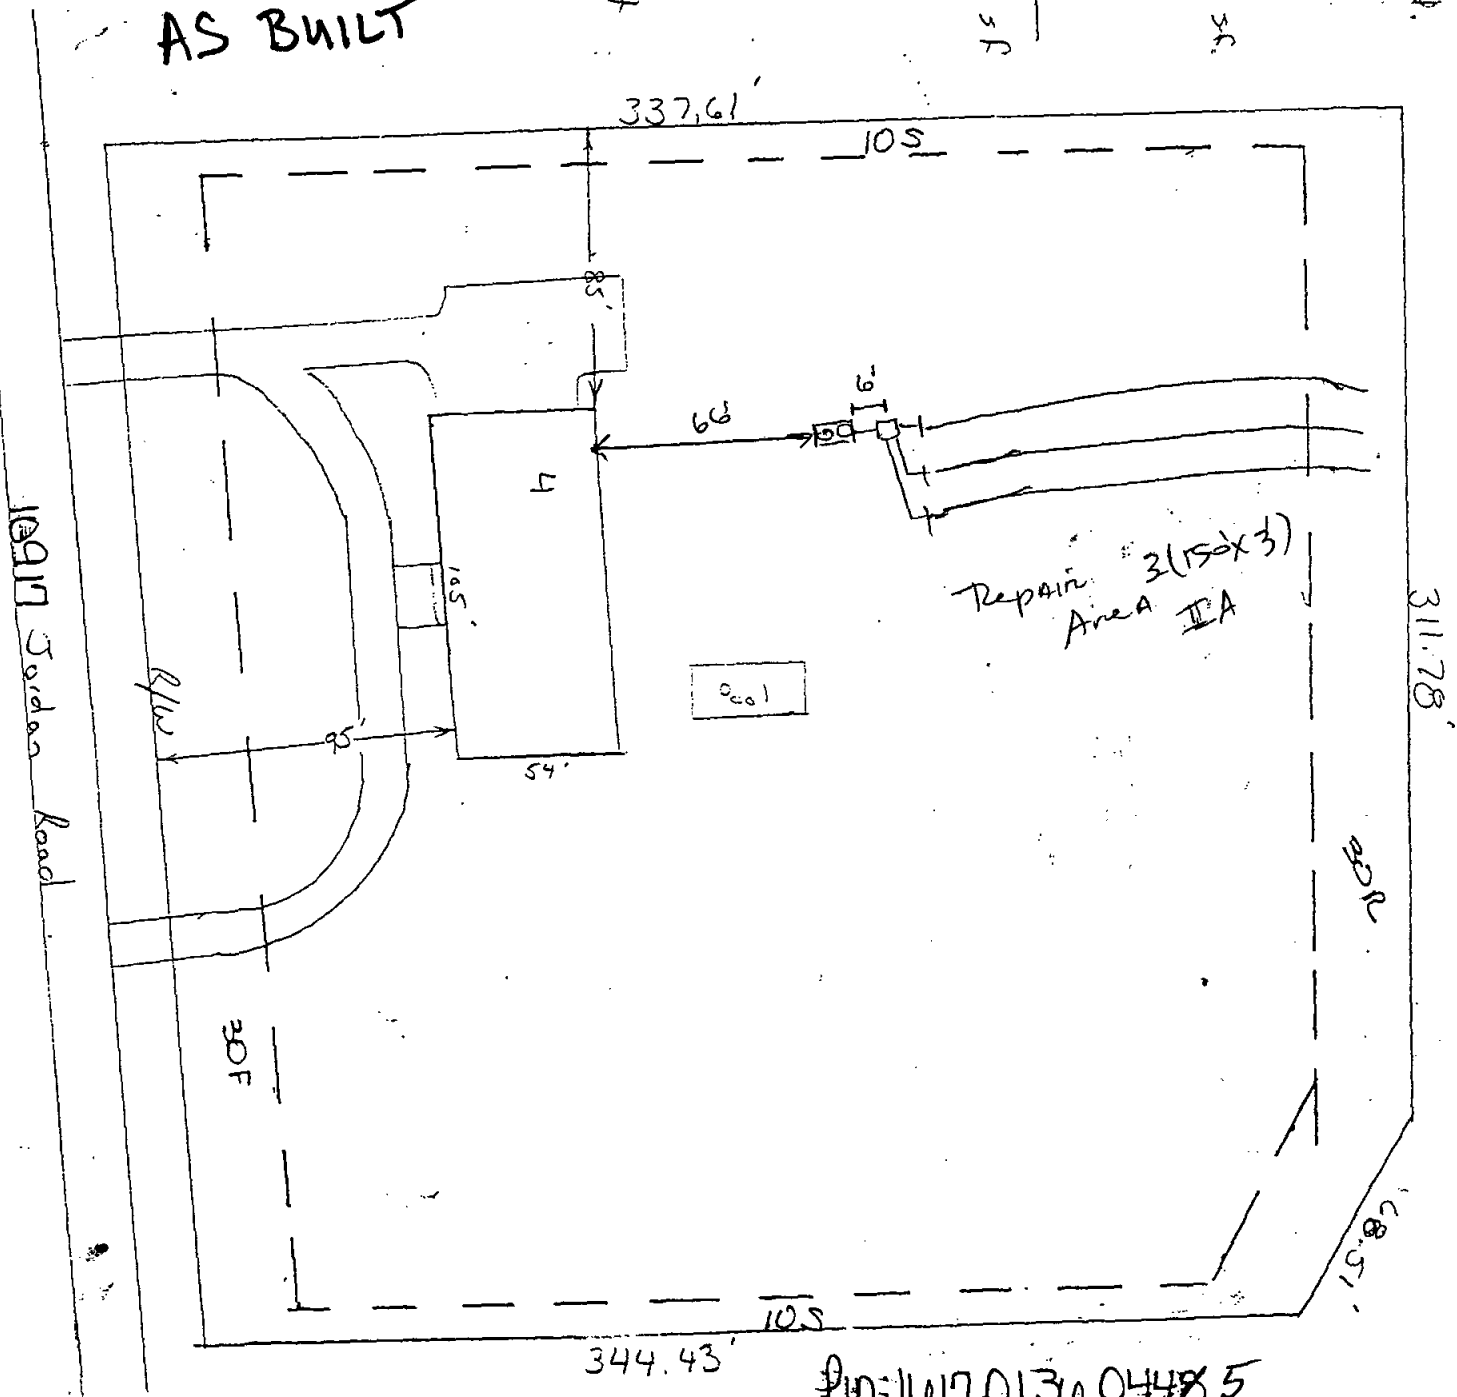

Zoning R30 By SLC
Approve ✓ Date 11-8-04
Revise _____ Use 101
Reject _____ MBL _____
Front 30 Rear 30
Side 10 Corner _____
Comments:--

Pin: 1117.0130.04485

I certify that the location of planned or existing structure(s) are accurately shown. I understand failure to locate structure(s) in accordance with this plot plan may require the relocation of structure(s) regardless of completion. I hereby grant permission to Municipal/County Representatives the right of entry to make evaluations or inspections upon this property.

Bill Wall
Signature of Owner or Authorized Agent

P.W. # 161736 0445

WAKE COUNTY DEPARTMENT OF ENVIRONMENTAL SERVICES WELL AND SEWAGE SITE LOCATION PERMIT
NO PERMIT(S) FOR CONSTRUCTION, LOCATION OR RELOCATION ACTIVITY SHALL BE ISSUED
UNTIL AN AUTHORIZATION FOR WASTEWATER SYSTEM CONSTRUCTION HAS BEEN ISSUED

PERMIT VOID IF NOT IN COMPLIANCE WITH ZONING REGULATIONS AND/ OR IF SITE IS ALTERED OR INTENDED USE CHANGED

PERMIT#: D031991 STATUS: A APP. DATE: 11/08/2004 BLDG. PERMIT#: 0051511
~~PHN: 1617-01-36-0448-000~~ TAX MAP: 0827 0000 RECORDED: Y ORIG. PERMIT#:
TOWNSHIP: 15 PANTHER BRANCH JURISDICTION: WC ZONING: R30
APPLICANT: WHEELLESS, G MICHAEL
3416 KISTLER CT
WILLOW SPRING, NC 27592
(919) 552 - 9347
USE: HD USE: 101 ONE-FAMILY HOUSE
EXIST USE:
DISPOSAL: BEDROOMS: 4 BASEMENT: Y #EMPLOYEES: 0
SITE: ADDRESS: 10917 JORDAN RD
SUBDIVISION: MIKE GREEN LOT: 2 ACRES: 3.31
DIRECTION: N 50 S R JORDAN RD 2MI ON L AFTER CROSSING 1010

Well System: WATER: INDIVIDUAL TYPE: NEW

WELL LOG INFORMATION DEPTH: 240 CASING DEPTH: 80 YIELD: 40 STATIC LEVEL: 35
WELLI CONTRACTOR: Roger Jackson REG.# 646 PUMP CONTRACTOR: Roger Jackson REG.# 915
Construction Compliance GROUT APPROVED ☒ DATE 6/8/05 EHS 6/8/05
13691 WELLHEAD APPROVED ☒ DATE 6/15/05 EHS 6/15/05
SYSTEM FINALIZED ☐ DATE _____ EHS _____

COMMENTS:

Operation Permit

DESIGN FLOW: _____ gal./min. ACTUAL FLOW: _____ INNOVATIVE LETTER: _____

INSTALLED BY: Mike Day INSTALLATION APPROVED BY: _____
PROPRIETARY SYSTEM: _____ FILTER NO: _____
COMMENTS: _____

OPERATIONS PERMIT ISSUED? X OP DATE: 11-01-05 BY: Christina Hanzl

This permit is based in part on information provided by the homeowner or his/her representative in the application submitted for this permit. The Environmental Health Specialist is not responsible for false or misleading information contained in the application. The Environmental Health Specialist is also not responsible for concealed conditions on the property or for statements in this report that may have resulted from false or misleading statements provided to him in the application. Neither Wake County nor the Environmental Health Specialist warrants that the septic tank system will continue to function satisfactorily in the future or that the water supply will remain potable.

As Built Information:

Date: 10-31-05 Benchmark: _____ Rod reading: _____ Distance to Structure: _____
ST: 1200 gals ID#: BTS-SAB-102 D.O.M.: 7-1-05 Elev.: _____ Distance to Well: _____
PT: _____ gals ID#: _____ D.O.M.: _____ Elev.: _____
D-box/FD/PM elev.: 4.3 Supply Line: _____ ft. Pump/Control Panel: _____
Line 1: 5.33/4 _____ Date: _____
Line 2: 5.3 _____ Date: _____
Line 3: 5.03/4 _____ Date: _____
Line 4: _____ Date: _____
Line 5: _____ Date: _____
Distance to P/L: _____ Notes: _____

Septic tank = 3.71/2

P.N # 1617 36 0445

WAKE COUNTY DEPARTMENT OF ENVIRONMENTAL SERVICES WELL AND SEWAGE SITE LOCATION PERMIT
NO PERMIT(S) FOR CONSTRUCTION, LOCATION OR RELOCATION ACTIVITY SHALL BE ISSUED
UNTIL AN AUTHORIZATION FOR WASTEWATER SYSTEM CONSTRUCTION HAS BEEN ISSUED

PERMIT VOID IF NOT IN COMPLIANCE WITH ZONING REGULATIONS AND/ OR IF SITE IS ALTERED OR INTENDED USE CHANGED

PERMIT#: D031991 STATUS: A APP. DATE: 11/08/2004 BLDG. PERMIT#: 0051511
~~PIN: 4647-01-36-0448-000-~~ TAX MAP: 0827 0000 RECORDED: Y ORIG. PERMIT#:
TOWNSHIP: 15 PANTHER BRANCH JURISDICTION: WC ZONING: R30
APPLICANT: WHEELLESS, G MICHAEL
3416 KISTLER CT
WILLOW SPRING, NC 27592
(919) 552 - 9347
USE: HD USE: 101 ONE-FAMILY HOUSE
EXIST USE:
DISPOSAL: BEDROOMS: 4 BASEMENT: Y #EMPLOYEES: 0 FOUND DRAIN:
SITE: ADDRESS: 10917 JORDAN RD
SUBDIVISION: MIKE GREEN LOT: 2 ACRES: 3.31
DIRECTION: N 50 S R JORDAN RD 2MI ON L AFTER CROSSING 1010

IMPROVEMENT PERMIT

TANK SIZE: 1200 gal. PUMP Tank: ____ gal. SQ FT: 1350 STONE DEPTH: 12 in. MAX DEPTH LINE: 24 in.
WASTEWATER: INDIVIDUAL SEWAGE: DOMESTIC TYPE SYSTEM: II A PUMP: N P/M: N
DAILY FLOW: 480 gal/day DESIGN FEE REQ?: PAID?: WATER: INDIVIDUAL

COMMENTS:

IP ISSUED? Y DATE: 12/07/2004 BY: (CHH) Christa H. Hayes PHONE#: 868-2564

AUTHORIZATION FOR WASTEWATER/WATER SYSTEM CONSTRUCTION

VOID SIXTY (60) MONTHS FROM DATE OF ISSUANCE

AUTHORIZATION CONDITIONS:

Contractors shall install system on contours, see attached site plan for wastewater system design and well location. No underground utilities, water lines or sprinkler systems may be located in the original system or repair areas. A septic tank filter with a riser for access is required. The wastewater system shall not be covered or placed into use until inspected by the Wake County Department of Environmental Services and an Operation Permit issued. **OTHER CONDITIONS:**

INSTALL LINES ON CONTOUR. MAINTAIN ALL SETBACKS. DO NOT GRADE OR REMOVE SOIL FROM SEPTIC SYSTEM AREAS. DO NOT INSTALL UTILITIES OR IRRIGATION SYSTEM IN SEPTIC SYSTEM AREAS. GRINDER PUMP WILL BE INSTALLED FOR BATHROOM IN BASEMENT SO THAT PUMP WILL NOT BE NEEDED. CALL PRIOR TO INSTALLATION WITH ANY QUESTIONS, CHANGES OR CONCERNS.

TANK SIZE: 1200 gal. PUMP TANK: ____ gal. SQ FT: 1350 STONE DEPTH: 12 in. MAX DEPTH LINE: 24 in.
MAINT: N OPER: N L/O: Y TRENCH#: 3 LENGTH: 150 ft. WIDTH: 36 in. DESIGNER: ____
SUBFIELDS: ____ DESIGN HEAD PRESSURE: ____ DESIGN FLOW: ____ gal/min DOSE VOLUME: ____ gal.

CA ISSUED? Y DATE: 12/07/2004 BY: (CHH) Christa H. Hayes PHONE#: 868-2564

161701 3609485

0068132
W1804

I certify that the location of planned or existing structure(s) are accurately shown. I understand failure to locate structures in accordance with this plan may require the relocation of structure(s) regardless degree of completion. I hereby submit this plan to Municipal/County Representative for the right of entry to make evaluation and inspections upon this property.

Mike + Kim

Signature of Owner or Authorized Agent

Wholesale

10917 Jordan Rd
Raleigh NC 27603

Lot 1, 2, + 3

Mike Green Sub

BM-2002-838

Pather Branch Township

Capitol Pools + Spa, Inc
128 US Hwy 70 EAST
Greener, NC 27529Ben Lanthier
Ben Lanthier
919-669-9713

3/8/06


Scale

1" = 60'

Site plan approved as shown for pool.
Any changes to site plan voids approval. All setbacks apply for septic systems and wells, regarding any pools, decks, additions and/or accessory structures. Applicant is responsible for protecting all portions of the septic system, repair area and wells from damage during construction. Adhere to all Local and State Rules.

Approved by [Signature] Date 3/27/06
Wake County Department of Environmental Services
Water and Waste Water Section

68'

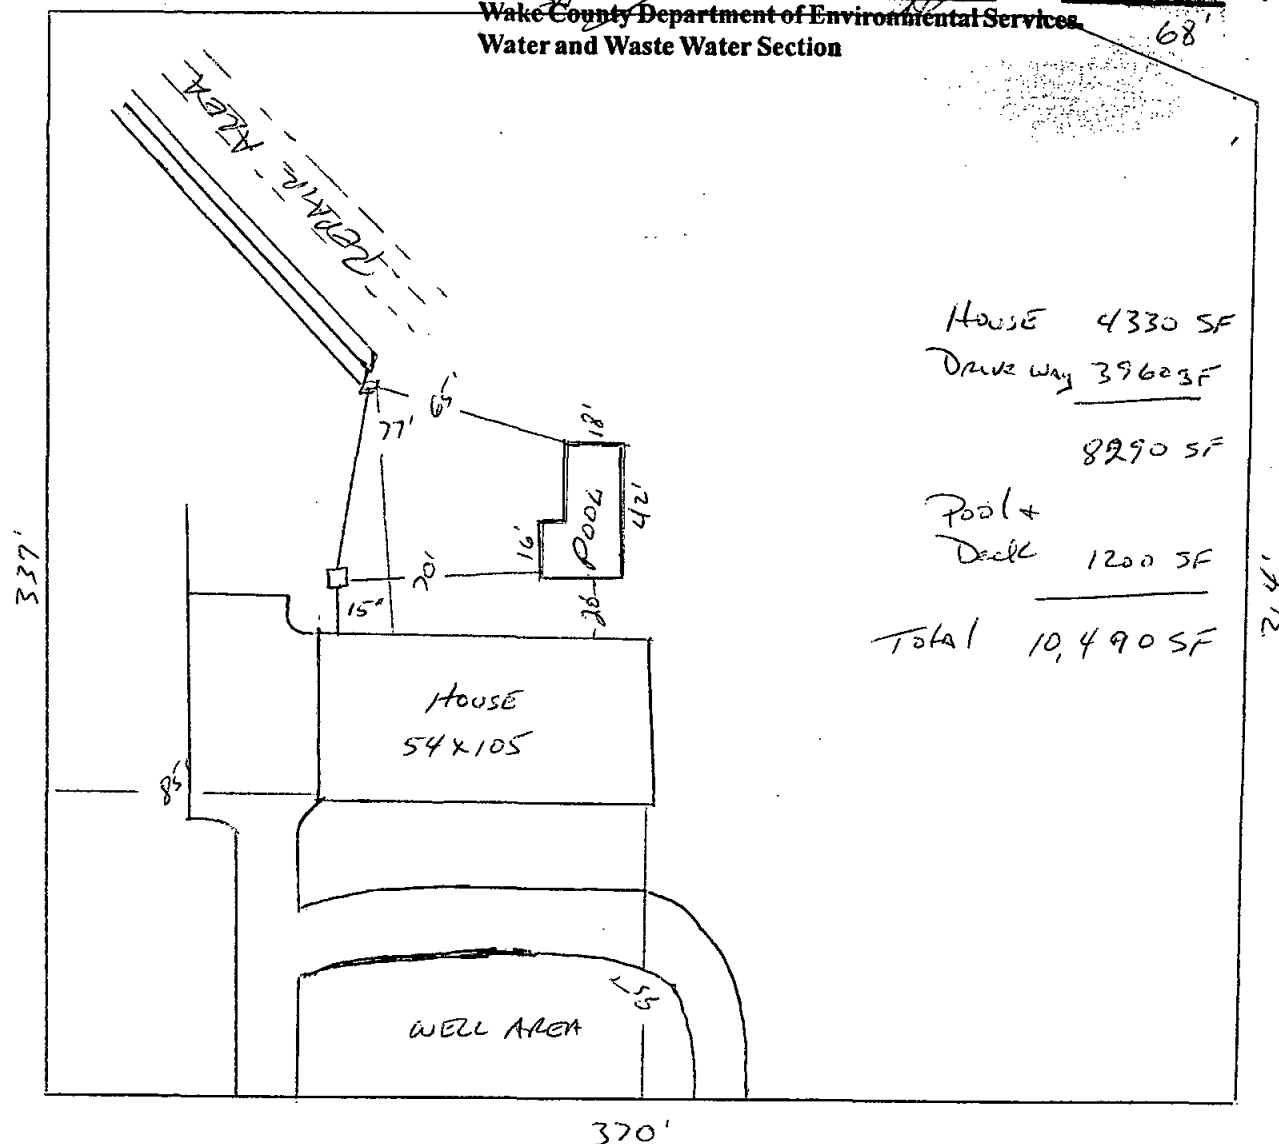

314'

60133
BM 2004
Page 1509

Impervious Surface
House
Drives
Accessory Bldgs
sidewalks

5500 sf
5534 sf
1500 sf
300 sf

12,834 sf

3.572 AC or 155,565 SF
INCLUDING HWY R/W
3.316 AC or 144,434 SF
EXCLUDING HWY R/W
see BM 2004, PG 1509

NOW OR FORMERLY
AMIS MYATT
DB4265, PG 101

Total Impervious + 3360
Total Lot Area 155,596

COURSE	BEARING	DISTANCE
L1	N01°58'09"W	49.79'
L2	N01°51'01"W	54.43'
L3	N02°23'30"W	57.71'
L4	N02°49'06"W	56.71'
L5	N02°43'23"W	17.33'
L6	N02°43'23"W	39.95'
L7	N02°54'27"W	44.45'
L8	N02°57'34"W	49.14'
L9	N03°47'28"W	36.77'
L10	N03°47'28"W	13.04'
L11	S89°43'01"E	13.05'
L12	S89°43'01"E	29.39'
L13	S89°43'01"E	29.96'
L14	S89°43'01"E	0.32'
L15	S89°43'01"E	69.71'

NOTES:

DEED REFERENCE: DB 9574, PG 2771
LOTS 1-3 AS SHOWN IN BM 2002, PG 838

PIN # (LOT 1) 1617360549
PIN # (LOT 2) 1617360448
PIN # (LOT 3) 1617360346



* BEFORE ACQUIRING A BUILDING PERMIT FOR LOTS MARKED BY AN * (ASTERISK) THE BUILDER MAY NEED TO OBTAIN A FLOOD HAZARD AREA USE PERMIT FROM THE WAKE COUNTY ENVIRONMENTAL SERVICES. THE BUILDER'S ENGINEER, ARCHITECT AND/OR SURVEYOR (as appropriate) MUST CERTIFY ON ANY PERMIT THAT ALL FLOOD HAZARD REQUIREMENTS ARE MET [SECTION 1-1-26 (A) (6)].

STATE OF NORTH CAROLINA, JOHNSTON COUNTY

I, JIMMY C. BARBOUR, CERTIFY THAT THIS PLAT WAS DRAWN UNDER MY SUPERVISION FROM AN ACTUAL SURVEY MADE UNDER MY SUPERVISION UNLESS OTHERWISE NOTED; REFERENCING DESCRIPTIONS RECORDED IN map BOOK 2002 PAGE B38; THAT THE BOUNDARIES NOT SURVEYED ARE CLEARLY INDICATED AS DRAWN FROM INFORMATION FOUND IN EXISTING RECORDS AS NOTED; THAT THE RATIO OF PRECISION AS CALCULATED IS 1:10,000+; AND THAT THIS PLAT WAS PREPARED IN ACCORDANCE WITH GS 47.30 AS AMENDED. WITNESS MY ORIGINAL SIGNATURE, LICENSE NUMBER AND SEAL THIS 13 DAY OF March, 2005.

JIMMY C. BARBOUR, PROFESSIONAL LAND SURVEYOR, NC No. L-2855

JIMMY C. BARBOUR, PROFESSIONAL LAND SURVEYOR No. L-2855, CERTIFY THAT THIS PLAT IS OF A SURVEY OF AN EXISTING PARCEL OR PARCELS OF LAND, AND DOES NOT CREATE A NEW STREET OR CHANGE AN EXISTING STREET IN ACCORDANCE WITH G.S. 47-30(F)(11).

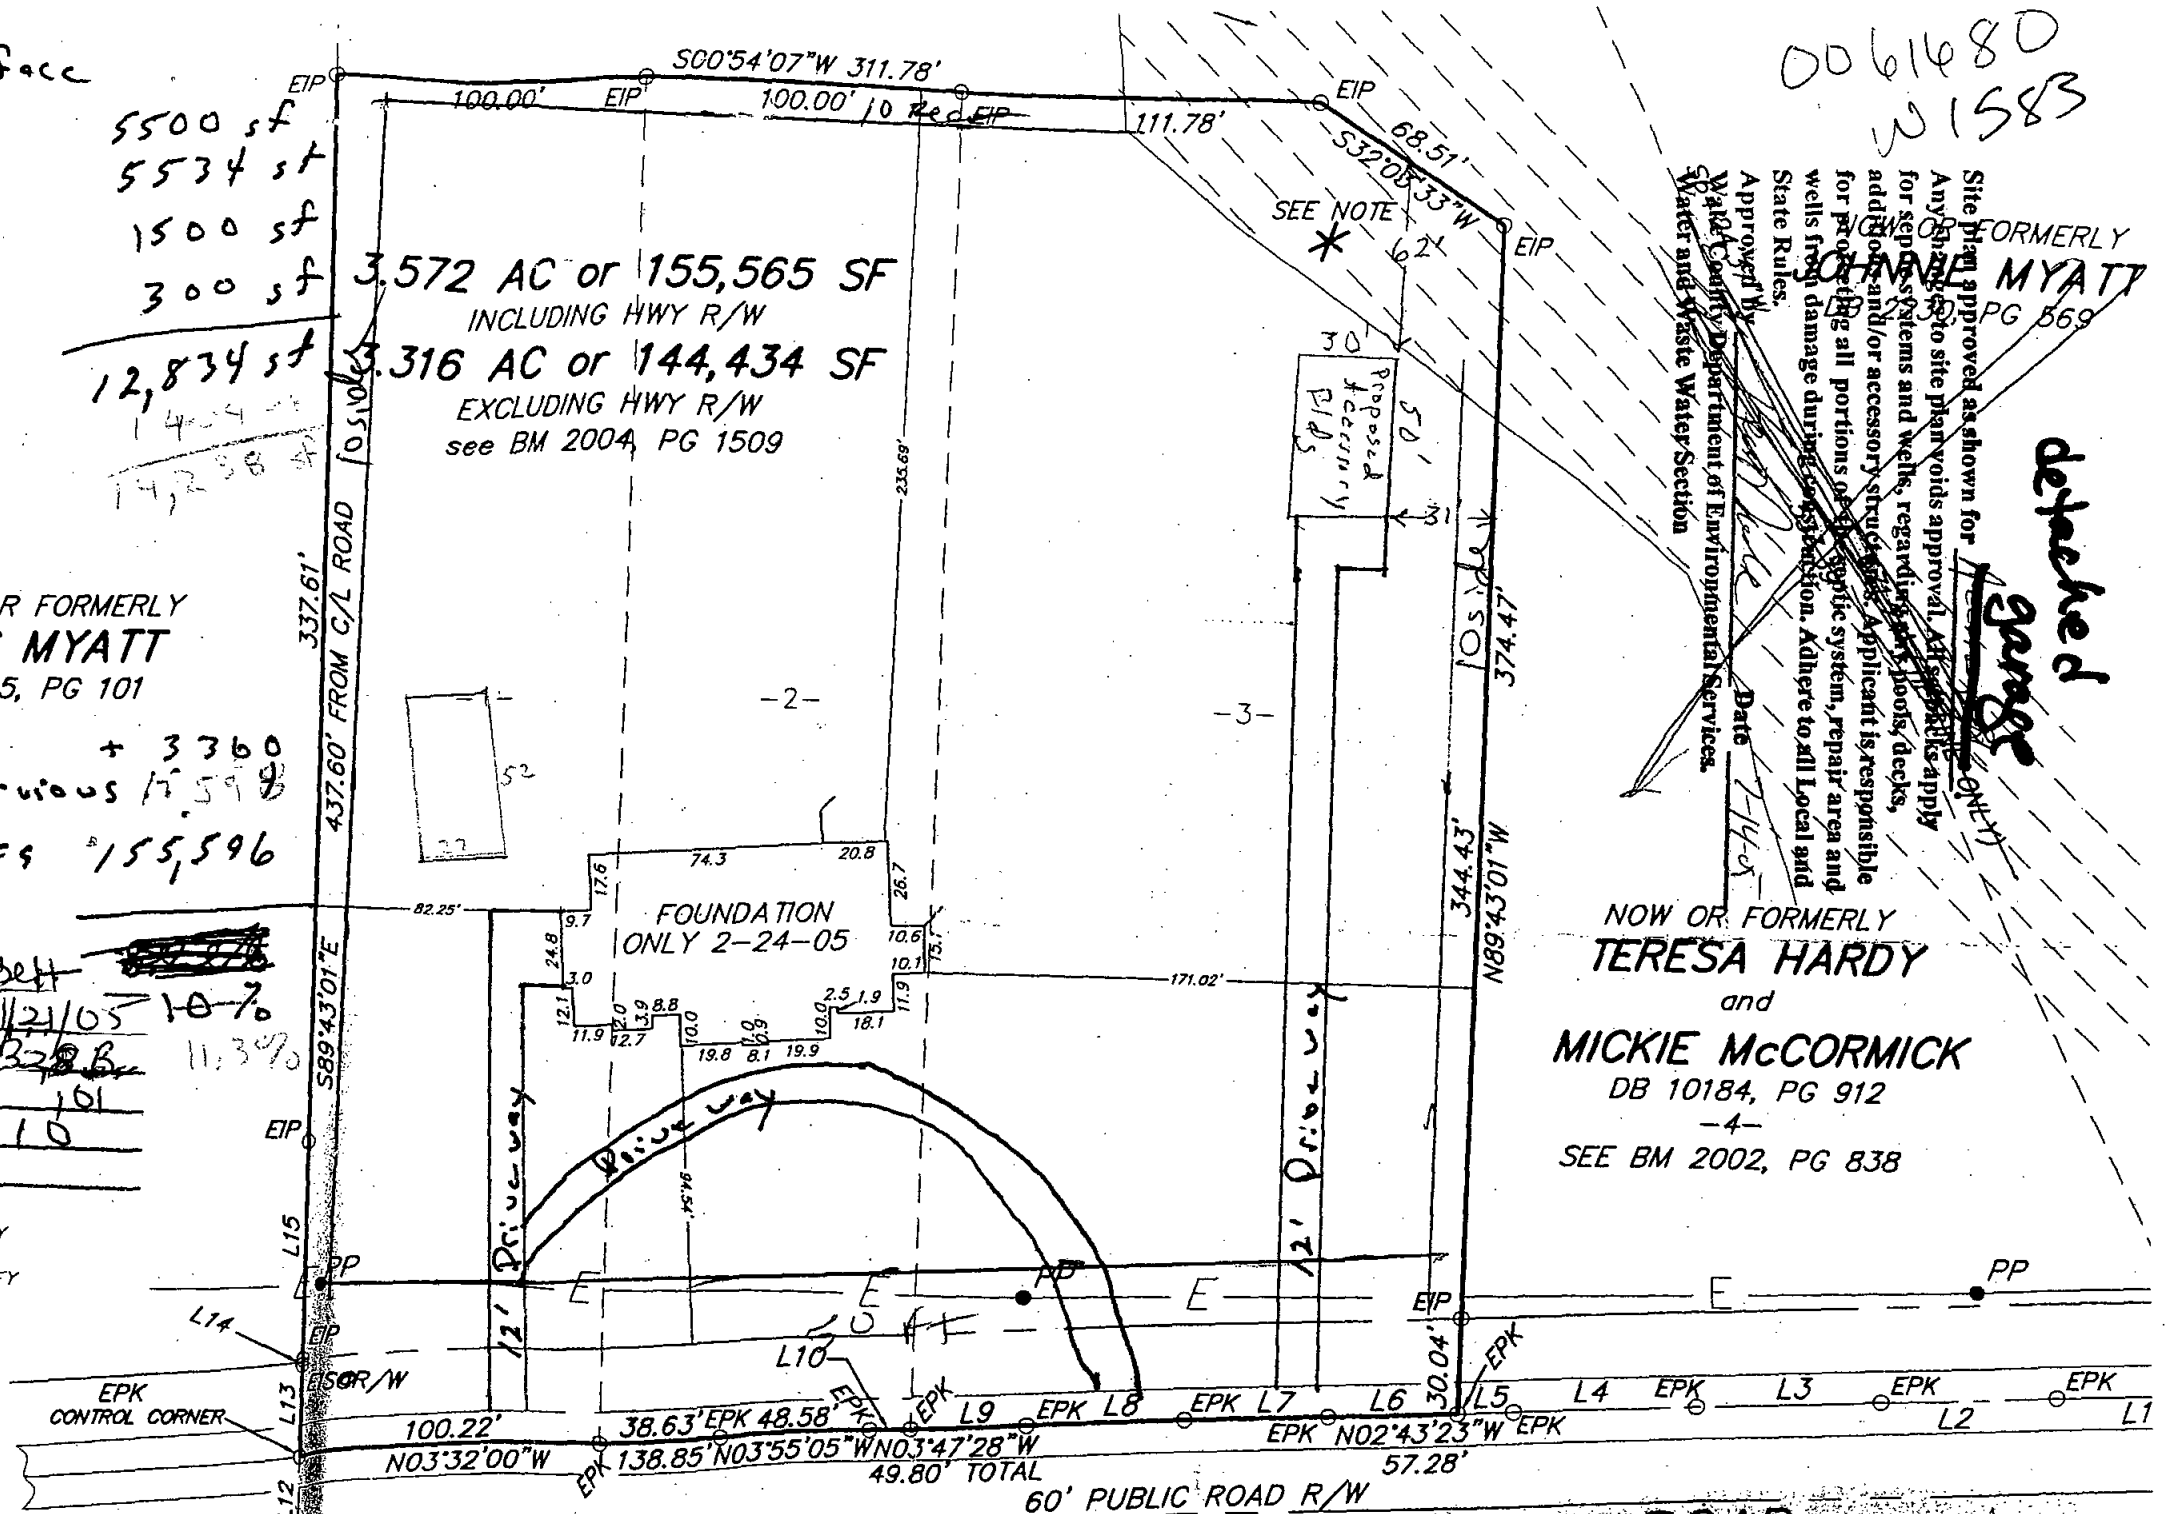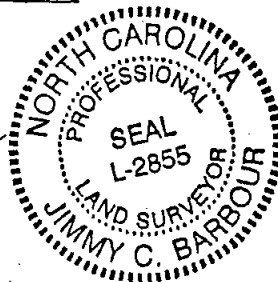

I certify that the location of existing structure(s) are accurate. I understand failure to locate structure(s) in accordance with this plot plan may require the relocation of structure(s) regardless degree of completion. I hereby grant permission to Municipal/County Representatives the right of entry to make evaluations or inspections upon this property.

Signature of Owner or Authorized Agent

NO HORIZONTAL GROUND CONTROL FOUND WITHIN 2,000 FEET.
AREA BY COORDINATE COMPUTATION

0 30 60 120 180

0061480
W1583

NOW OR FORMERLY
AMIS MYATT
PG 569

detached
garage

NOW OR FORMERLY
TERESA HARDY
and
MICKIE MCCORMICK
DB 10184, PG 912
SEE BM 2002, PG 838

NGSR 2731 - JORDAN ROAD

Site plan approved as shown for access bldg
Any changes to site plan voids approval. All setbacks apply for septic systems and wells, regarding any pools, decks, additions and/or accessory structures. Applicant is responsible for protecting all portions of the septic system, repair area and wells from damage during construction. Adhere to all Local and State Rules.
Approved by [Signature] Date 11/21/05
Wake County Department of Environmental Services.
Water and Waste Water Section

pin# 161701360448000
5