

Environmental Services - Water Quality
Onsite Wastewater Scan Data Entry Form

PERMIT #: B012853

PIN #: 0798549024

OP DATE: 1211511978

SYSTEM USE:

- ☒ House
☐ Mobile Home
☐ Business
☐ Other

SEWAGE TYPE:

- ☒ Domestic
☐ Industrial

PUMP/SIPHON?:

- ☐ Yes
☒ No

PRESSURE MANIFOLD:

- ☐ Yes
☒ No

SYSTEM TYPE:

- ☐ I
☒ II
☐ III
☐ IV
☐ V
☐ VI
☐ Other

SUB TYPE:

- ☒ A
☐ B
☐ C
☐ D
☐ E
☐ F
☐ G

NBR BEDROOMS:

- ☐ 1
☐ 2
☐ 3
☐ 4
☒ 5
☐ 6
☐ Other

MAINT. SCHEDULE:

- ☐ Yes
☒ No

CERT. OPERATOR

- ☐ Yes
☒ No

GT ST PT

- ☐
☐
☐
☒

SIZE

- 750
900
1,000
1,200
1,500
1,800
2,100
2,500
3,000
4,000
5,000
8,000
10,000
Other

DRAINFIELD SIZE(SQ. FT.)

01500

2x systems containing tank and 6ft bed drainline

Front yard - 120' of 6ft bed

Back yard - 130' of 6ft bed

Permit B038567 is attached to -

show 11'x23' addition on rear of

house system info not reflective of

what was actually installed per B012853

None/NA GT or PT

DRAIN TYPE:

- ☒ Stone
☐ EZ Flow
☐ Infiltrator
☐ Biodiffuser
☐ Cultec
☐ Drip
☐ Hancor
☐ Large Dia. Pipe
☐ Multi-Pipe
☐ Other

MAX DEPTH (IN.):

- ☐ 12 in. or less
☐ 18 in. or less
☐ 24 in. or less
☐ 26 in. or less
☐ 28 in. or less
☐ 30 in. or less
☐ 32 in. or less
☐ 36 in. or less
☒ Other

STONE DEPTH (IN.):

- ☐ 8 in. or less
☐ 12 in. or less
☒ 18 in. or less
☐ 24 in. or less
☐ Other

TRENCHES:


- ☐ Individual
☒ Bed

TRENCH WIDTH (IN.):

- ☐ 12 in. or less
☐ 18 in.
☐ 24 in.
☐ 36 in.
☒ 6 ft. or less
☐ 9 ft. or less
☐ Other

BSM

APPROVED BY

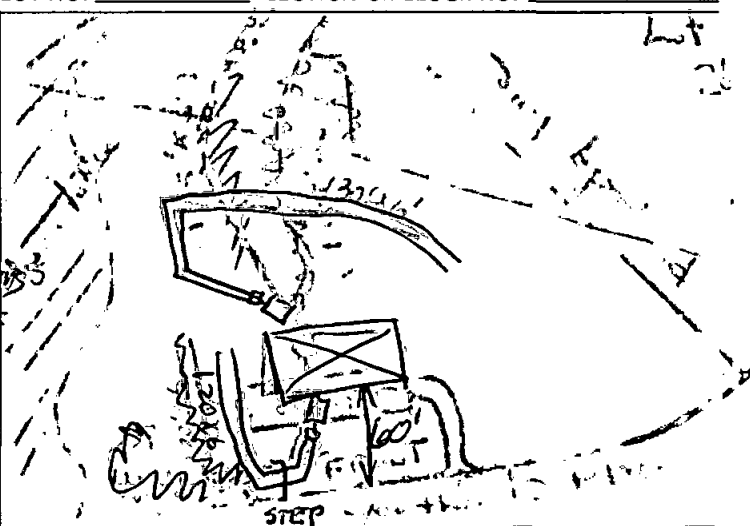

WAKE COUNTY HEALTH DEPARTMENT SEPTIC TANK LAYOUT AND PERMIT

38567

TAX MAP NO. 280/30 PARCEL NO. 1515/107

PERMIT NO. B
OPERATION PERMIT ☐

CONTRACTOR: _____

OWNER Steve J. Smith

DATE 11-13-86

LOCATION 5501 So. 11th St. Raleigh - 1st. Point

S. R. NO. 164.50 N

SUBDIVISION NAME 1st Stage Point LOT NO. 2621 SECTION OR BLOCK NO. _____

REPAIR ☐ ORIGINAL PERMIT NO. B12853

GARBAGE DISPOSAL UNIT YES ☐ NO ☒

HOUSE ☒ MOBILE HOME ☐ BUSINESS ☐

NO. BEDROOMS 5 LOT AREA 40,000

SIZE OF TANK 1500 gal.

NITRIFICATION LINE 2(175' x 6") 1500 sq. ft.


DEPTH OF STONE IN LINES: 12" ☒

RISER AND BAFFLE REQUIRED ☒ PUMP REQUIRED ☐

WATER SUPPLY: INDIVIDUAL ☐ PUBLIC ☒ OTHER ☐

- PERMIT VOID 36 MONTHS FROM DATE OF ISSUANCE.
- PERMIT VOID IF NOT IN COMPLIANCE WITH ZONING REGULATIONS
- PERMIT MAY BE VOIDED IF SITE ALTERATIONS MADE

LAYOUT BY _____

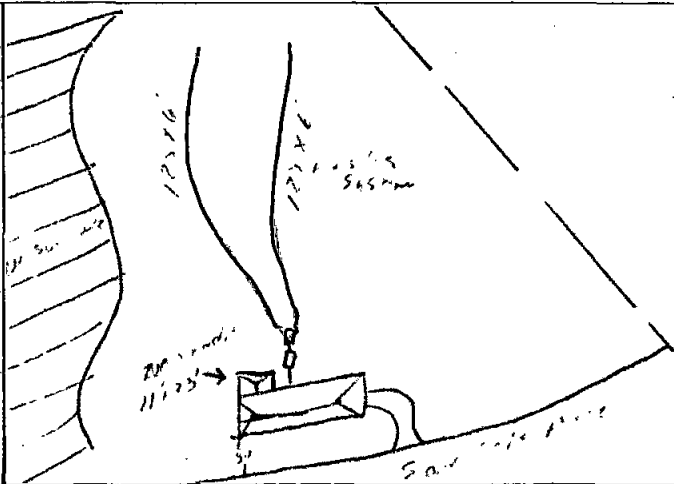

DATE 11-13-86

INSTALLED BY _____

APPROVED BY _____