

Environmental Services - Water Quality
Onsite Wastewater Scan Data Entry Form

PERMIT #: D010886

PIN #: 0799371218

OP DATE: 0410811999

SYSTEM USE:

- ☒ House
☐ Mobile Home
☐ Business
☐ Other

SEWAGE TYPE:

- ☒ Domestic
☐ Industrial

PUMP/SIPHON?:

- ☒ Yes
☐ No

PRESSURE MANIFOLD:

- ☐ Yes
☒ No

SYSTEM TYPE:

- ☐ I
☐ II
☒ III
☐ IV
☐ V
☐ VI
☐ Other

SUB TYPE:

- ☐ A
☒ B
☐ C
☐ D
☐ E
☐ F
☐ G

NBR BEDROOMS:

- ☐ 1
☐ 2
☒ 3
☐ 4
☐ 5
☐ 6
☐ Other

MAINT. SCHEDULE:

- ☐ Yes
☒ No

CERT. OPERATOR

- ☐ Yes
☒ No

GT ST PT

- | | | | |
|-------------------------------------|-------------------------------------|-------------------------------------|------------------|
| ☐ | ☐ | ☐ | 750 |
| ☐ | ☐ | ☐ | 900 |
| ☐ | ☐ | ☐ | 1,000 |
| ☐ | ☒ | ☒ | 1,200 |
| ☐ | ☐ | ☐ | 1,500 |
| ☐ | ☐ | ☐ | 1,800 |
| ☐ | ☐ | ☐ | 2,100 |
| ☐ | ☐ | ☐ | 2,500 |
| ☐ | ☐ | ☐ | 3,000 |
| ☐ | ☐ | ☐ | 4,000 |
| ☐ | ☐ | ☐ | 5,000 |
| ☐ | ☐ | ☐ | 8,000 |
| ☐ | ☐ | ☐ | 10,000 |
| ☐ | ☐ | ☐ | Other |
| ☒ | ☐ | ☐ | None/NA GT or PT |

DRAINFIELD SIZE(SQ. FT.)

01200

DRAIN TYPE:

- ☐ Stone
☒ EZ Flow
☐ Infiltrator
☐ Biodiffuser
☐ Cultec
☐ Drip
☐ Hancor
☐ Large Dia. Pipe
☐ Multi-Pipe
☐ Other

MAX DEPTH (IN.):

- ☐ 12 in. or less
☐ 18 in. or less
☒ 24 in. or less
☐ 26 in. or less
☐ 28 in. or less
☐ 30 in. or less
☐ 32 in. or less
☐ 36 in. or less
☐ Other

STONE DEPTH (IN.):

- ☐ 8 in. or less
☐ 12 in. or less
☐ 18 in. or less
☐ 24 in. or less
☒ Other

TRENCHES:

- ☒ Individual
☐ Bed

TRENCH WIDTH (IN.):

- ☐ 12 in. or less
☐ 18 in.
☐ 24 in.
☒ 36 in.
☐ 6 ft. or less
☐ 9 ft. or less
☐ Other

WAKE COUNTY DEPARTMENT OF ENVIRONMENTAL SERVICES WELL AND SEWAGE SITE LOCATION PERMIT

NO PERMIT(S) FOR CONSTRUCTION, LOCATION OR RELOCATION ACTIVITY SHALL BE ISSUED

UNTIL AN AUTHORIZATION FOR WASTEWATER SYSTEM CONSTRUCTION HAS BEEN ISSUED

PERMIT VOID IF NOT IN COMPLIANCE WITH ZONING REGULATIONS AND/OR IF SITE IS ALTERED OR INTENDED USE CHANGED

PERMIT#: D010886 STATUS: A APP DATE: 06/09/1998 BLDG PERMIT#: 0984400

APPLICANT: WEAVER CONST CO INC DAY PHONE: (919) 846 - 9600

ADDRESS: P O BOX 99637 FAX#: (919) 846 - 1022

CITY: RALEIGH STATE: NC ZIP: 27624

OWNER: WINCHESTER DEVELOPMENT CO DAY PHONE: (919) 999 - 9999

ADDRESS: P O BOX 99637 FAX#: (919) 999 - 9999

CITY: RALEIGH STATE: NC ZIP: 27624

HD USE CD: 101 ONE-FAMILY HOUSE ORIG PERMIT#: REC?: Y

EXIST USE: TAX MAP#: 0240

BEDROOMS: 3 BSMT: N #EMPLOYEES: 0 WATER: C WASTEWATER: I GARB DISPOS: N

TOWNSHIP: 02 BARTON'S CREEK JURIS: WC ZON: R40W PIN: 0799.01 37 1218 000

SUBD#: S 000 000 00 SUBD NAME: CHANDLER POINT LOT-SEC: 1 ACRE: 1.66

IMPRV PRMT: ISSUED?: Y DATE: 07/11/1998 BY: TDC TYPE SYSTEM: III PUMP: Y

CNSTR AUTH: ISSUED?: Y DATE: 07/11/1998 BY: TDC DATE EXPIRED: 07/11/2003

RECEIPT#: 0029520 FEE: 145.00 OP DATE: BY:

WATR SAMPL: REQ?: N APPROVED?: DATE: PROPRIETARY SYS:

ST#: 1437 MI: DIR: NAME: KINSDALE DIR: TYP: DR

DIRECTIONS: GO 50 N-SUB DIV ON RIGHT-ONTO WARDEN RD-R KINDA

LE-LOT ON CRN KINSDALE-OLD WARDEN-CREEDMOOR

LOT #

IMPROVEMENT PERMIT

SIZE OF TANK 1200 ST 1200 PT GALS. TOTAL SQ. FT. 1200 DEPTH OF STONE 12 IN. MAX. DEPTH LINE 24 IN.

WASTEWATER: DOMESTIC ☒ INDUSTRIAL ☐

I.P. ISSUED BY

Terry D. Chappell R.S.

AUTHORIZATION FOR WASTEWATER SYSTEM CONSTRUCTION

VOID SIXTY (60) MONTHS FROM DATE OF ISSUANCE

AUTHORIZATION CONDITIONS

Contractor To Follow Contours, See Attached Site Plan For Wastewater System Design And Well Location. The wastewater system shall not be covered or placed into use until inspected by the Wake County Department of Environmental Services and an Operation Permit issued.

OTHER CONDITIONS: Keep system shallow, 24 inch max. depth. Use NEMA 4X elec. Box, 4X4 post, mount alarm in garage or in house. Keep system 10 feet min. from property lines, stay 15 feet from road cuts, install 2nd riser on septic tank for access to septic tank filter, community water supplied

SIZE OF TANK 1200 ST 1200 PT GALS. TOTAL SQ. FT. 1200 DEPTH OF STONE 12 IN. MAX. DEPTH LINE 24 IN.

ST FILTER REQUIRED ☒ NUMBER OF TRENCHES 2 LENGTH OF TRENCHES 200 FT. WIDTH OF TRENCHES 3 FT.

C.A. ISSUED BY *Terry D. Chappell R.S.*

INSTALLED BY *James Gullett*

CTR. I.D. #

SEPTIC TANK FILTER USED

INNOV. APPRL. #: IWWS- DATE 4-8-99

INSTALLATION APPROVED BY *Lin Weaver R.S.*

Alarm insp
Pump Final
OK
4-8-99
JTW

WELL SYSTEM = PRIVATE ☐ SEMI-PUBLIC ☐ NEW ☐ REPLACEMENT ☐ EXISTING ☐

WELL LOG INFORMATION = DEPTH CASING DEPTH YIELD STATIC LEVEL

WELL CONTRACTOR REG.# PUMP CONTRACTOR REG.#

CONSTRUCTION COMPLIANCE = GROUT APPROVED ☐ DATE EHS


WCHD ID # WELLHEAD APPROVED ☐ DATE EHS

NEGATIVE BACTERIOLOGICAL RESULTS ☐ DATE EHS

SYSTEM FINALIZED ☐ DATE EHS

COMMENTS: community water

This permit is based in part on information provided by the homeowner or his/her representative in the application submitted for this permit. The Environmental Health Specialist is not responsible for false or misleading information contained in the application. The Environmental Health Specialist is also not responsible for concealed conditions on the property or for statements in this report that may have resulted from false or misleading statements provided to him in the application. Neither Wake County nor the Environmental Health Specialist warrants that the septic tank system will continue to function satisfactorily in the future or that the water supply will remain potable.

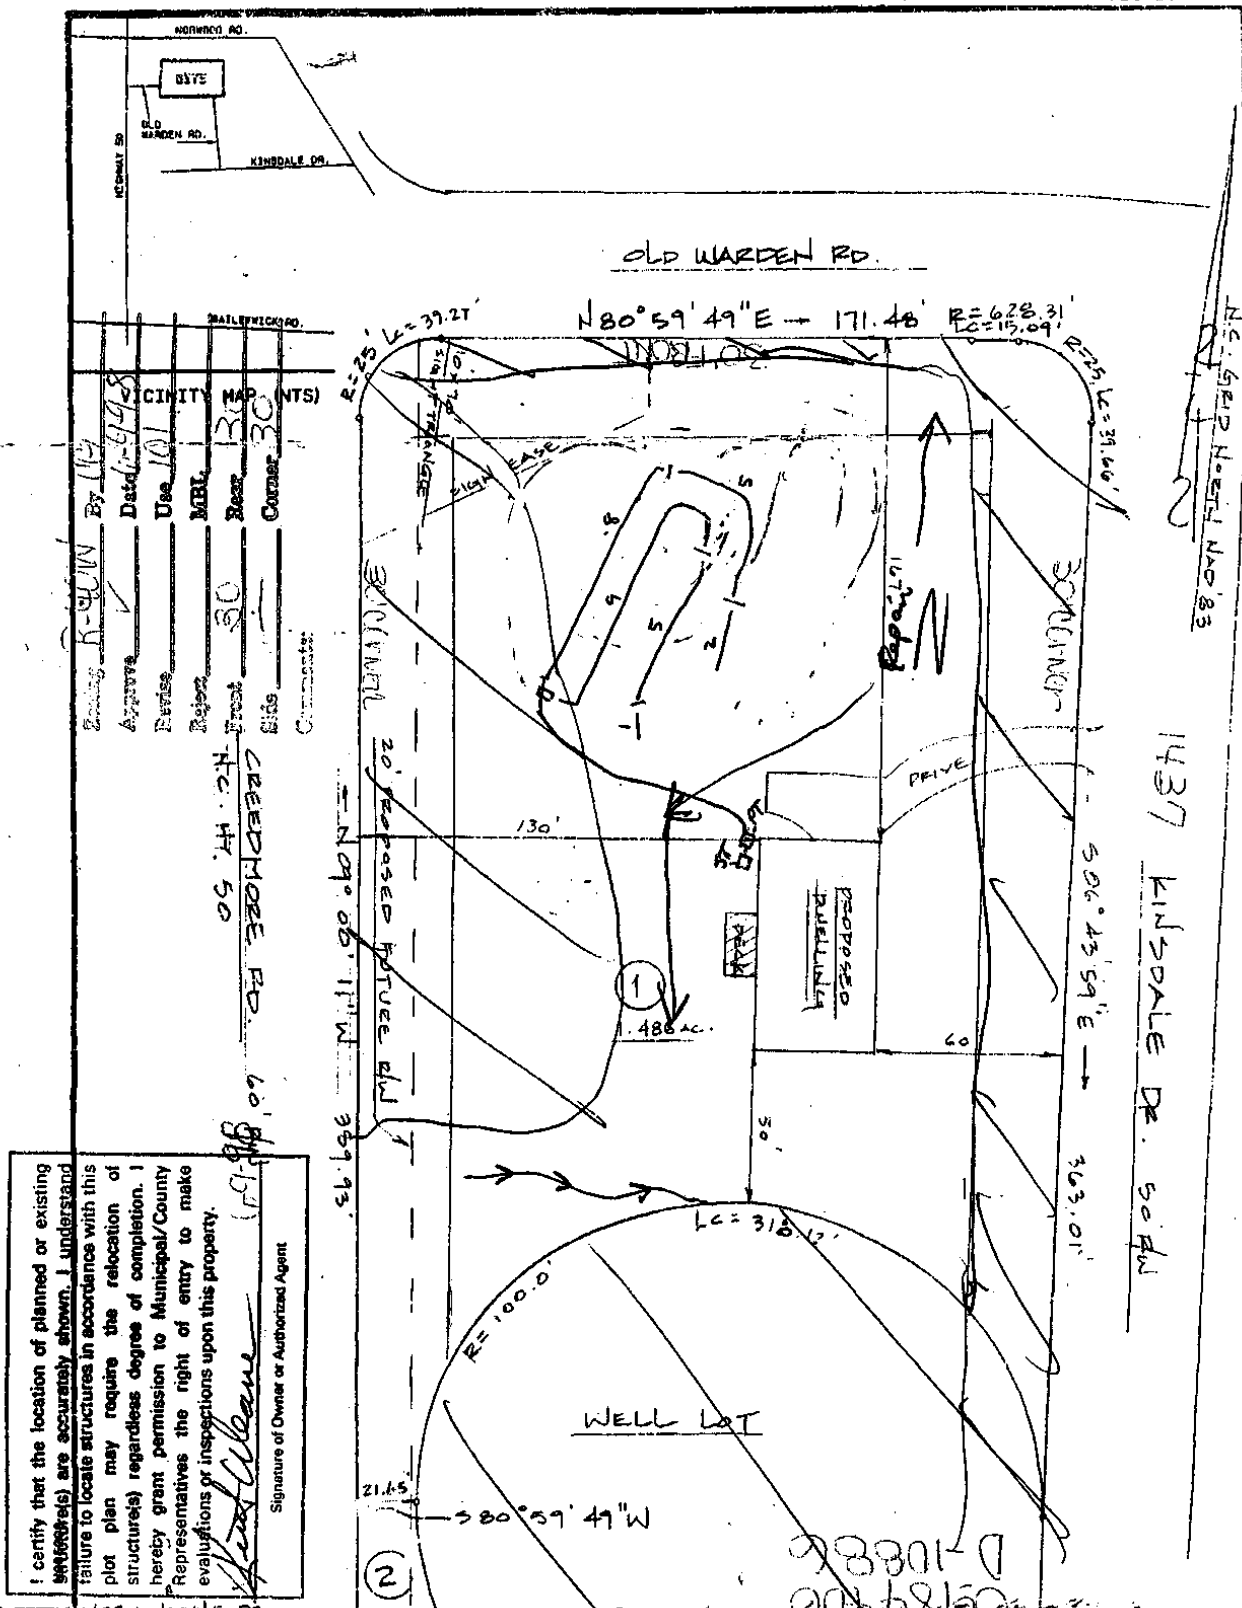

I certify that the location of planned or existing structures are accurately shown. I understand failure to locate structures in accordance with this plot plan may require the relocation of structures regardless degree of completion. I hereby grant permission to Municipal/County Representatives the right of entry to make evaluations or inspections upon this property.

Signature of Owner or Authorized Agent

THIS PROPERTY IS NOT LOCATED IN A FEMA DESIGNATED FLOOD HAZARD AREA

Book of Maps 1996 Vol. Page 1515 Dead Book Pg. County of WAKE

LOT 1 SUBDIVISION CHANDLER POINTE

I HEREBY CERTIFY THAT THIS MAP IS CORRECT AND THAT THE BUILDING FOUNDATION LIES WHOLLY ON THE LOT AND THAT THERE ARE NO ENCROACHMENTS ON SAID LOT EXCEPT AS NOTED.

Surv'd. Drawn 41P Chk'd. ED Job No. 98000 Date 5-27-78 Scale 1"=50'

BASS, NIXON & KENNEDY, INC.
CONSULTING ENGINEERS
7416 CHAPEL HILL ROAD
RALEIGH, NORTH CAROLINA 27607
919-851-4422

PROPERTY OF
WEAVER CONST. & DEV. CO.

BARTON'S CRK TWP.