

Environmental Services - Water Quality
Onsite Wastewater Scan Data Entry Form

PERMIT #: 0019641

PIN #: 0696158903

OP DATE: 0812412001

SYSTEM USE:

- ☒ House
☐ Mobile Home
☐ Business
☐ Other

SEWAGE TYPE:

- ☒ Domestic
☐ Industrial

PUMP/SIPHON?:

- ☐ Yes
☒ No

PRESSURE MANIFOLD:

- ☐ Yes
☒ No

SYSTEM TYPE:

- ☐ I
☒ II
☐ III
☐ IV
☐ V
☐ VI
☐ Other

SUB TYPE:

- ☒ A
☐ B
☐ C
☐ D
☐ E
☐ F
☐ G

NBR BEDROOMS:

- ☐ 1
☐ 2
☒ 3
☐ 4
☐ 5
☐ 6
☐ Other

MAINT. SCHEDULE:

- ☐ Yes
☒ No

CERT. OPERATOR

- ☐ Yes
☒ No

GT ST PT SIZE

- | | | | |
|-------------------------------------|-------------------------------------|-------------------------------------|------------------|
| ☐ | ☐ | ☐ | 750 |
| ☐ | ☐ | ☐ | 900 |
| ☐ | ☒ | ☐ | 1,000 |
| ☐ | ☐ | ☐ | 1,200 |
| ☐ | ☐ | ☐ | 1,500 |
| ☐ | ☐ | ☐ | 1,800 |
| ☐ | ☐ | ☐ | 2,100 |
| ☐ | ☐ | ☐ | 2,500 |
| ☐ | ☐ | ☐ | 3,000 |
| ☐ | ☐ | ☐ | 4,000 |
| ☐ | ☐ | ☐ | 5,000 |
| ☐ | ☐ | ☐ | 8,000 |
| ☐ | ☐ | ☐ | 10,000 |
| ☐ | ☐ | ☐ | Other |
| ☒ | | ☒ | None/NA GT or PT |

DRAINFIELD SIZE(SQ. FT.)

00900

DRAIN TYPE:

- ☒ Stone
☐ EZ Flow
☐ Infiltrator
☐ Biodiffuser
☐ Cultec
☐ Drip
☐ Hancor
☐ Large Dia. Pipe
☐ Multi-Pipe
☐ Other

MAX DEPTH (IN.):

- ☐ 12 in. or less
☐ 18 in. or less
☒ 24 in. or less ^{20"}
☐ 26 in. or less
☐ 28 in. or less
☐ 30 in. or less
☐ 32 in. or less
☐ 36 in. or less
☐ Other

STONE DEPTH (IN.):

- ☐ 8 in. or less
☒ 12 in. or less
☐ 18 in. or less
☐ 24 in. or less
☐ Other

TRENCHES:

- ☒ Individual
☐ Bed

TRENCH WIDTH (IN.):

- ☐ 12 in. or less
☐ 18 in.
☐ 24 in.
☒ 36 in.
☐ 6 ft. or less
☐ 9 ft. or less
☐ Other

WAKE COUNTY DEPARTMENT OF ENVIRONMENTAL SERVICES WELL AND SEWAGE SITE LOCATION PERMIT
NO PERMIT(S) FOR CONSTRUCTION, LOCATION OR RELOCATION ACTIVITY SHALL BE ISSUED
UNTIL AN AUTHORIZATION FOR WASTEWATER SYSTEM CONSTRUCTION HAS BEEN ISSUED

PERMIT VOID IF NOT IN COMPLIANCE WITH ZONING REGULATIONS AND/ OR IF SITE IS ALTERED OR INTENDED USE CHANGED

PERMIT#: D019641 STATUS: A APP. DATE: 10/09/2000 BLDG. PERMIT#: 0011189
PIN: 0696.01 16 7808 000 TAX MAP: 0857 RECORDED: Y ORIG. PERMIT#:
TOWNSHIP: 15 PANTHER BRANCH JURISDICTION: WC ZONING: R30
APPLICANT: STANCIL BUILDERS INC
466 STANCIL RD
ANGIER, NC 27501
(919) 639 - 2073
USE: HD USE: 101 ONE-FAMILY HOUSE
EXIST USE:
DISPOSAL: N BEDROOMS: 3 BASEMENT: N #EMPLOYEES: 0
SITE: ADDRESS: 7100 SARAHWOOD CT
SUBDIVISION: KENDALL HILL LOT: 47 ACRES: 0.57
DIRECTION: 401 S TO L SR 1006 CROSS N C 42 HWY SUB WILL BE
ON L

Well System: WATER: COMMUNITY - TYPE: IRRIGATION

WELL LOG INFORMATION: DEPTH: _____ CASING DEPTH: _____ YIELD: _____ STATIC LEVEL: _____
WELL CONTRACTOR: _____ REG.# _____ PUMP CONTRACTOR: _____ REG.# _____
Construction Compliance GROUT APPROVED ☐ DATE _____ EHS _____
WELLHEAD APPROVED ☐ DATE _____ EHS _____
SYSTEM FINALIZED ☐ DATE _____ EHS _____

COMMENTS:

Operation Permit

DESIGN FLOW: _____ gal./min. ACTUAL FLOW: _____ INNOVATIVE LETTER: _____
INSTALLED BY: Stancil INSTALLATION APPROVED BY: MTB
PROPRIETARY SYSTEM: _____ FILTER NO: _____
COMMENTS:

OPERATIONS PERMIT ISSUED? Yes OP DATE: 8/24/01 BY: MTB

This permit is based in part on information provided by the homeowner or his/her representative in the application submitted for this permit. The Environmental Health Specialist is not responsible for false or misleading information contained in the application. The Environmental Health Specialist is also not responsible for concealed conditions on the property or for statements in this report that may have resulted from false or misleading statements provided to him in the application. Neither Wake County nor the Environmental Health Specialist warrants that the septic tank system will continue to function satisfactorily in the future or that the water supply will remain potable.

WAKE COUNTY DEPARTMENT OF ENVIRONMENTAL SERVICES WELL AND SEWAGE SITE LOCATION PERMIT
NO PERMIT(S) FOR CONSTRUCTION, LOCATION OR RELOCATION ACTIVITY SHALL BE ISSUED
UNTIL AN AUTHORIZATION FOR WASTEWATER SYSTEM CONSTRUCTION HAS BEEN ISSUED

PERMIT VOID IF NOT IN COMPLIANCE WITH ZONING REGULATIONS AND/ OR IF SITE IS ALTERED OR INTENDED USE CHANGED

PERMIT#: D019641 STATUS: A APP. DATE: 10/09/2000 BLDG. PERMIT#: 0011189
PIN: 0696.01 16 7808 000 TAX MAP: 0857 0012 RECORDED: Y ORIG. PERMIT#:
TOWNSHIP: 15 PANTHER BRANCH JURISDICTION: WC ZONING: R30
APPLICANT: STANCIL BUILDERS INC
466 STANCIL RD
ANGIER, NC 27501
(919) 639 - 2073
USE: HD USE: 101 ONE-FAMILY HOUSE
EXIST USE:
DISPOSAL: N BEDROOMS: 3 BASEMENT: N #EMPLOYEES: 0
SITE: ADDRESS: 7100 SARAHWOOD CT
SUBDIVISION: KENDALL HILL LOT: 47 ACRES: 0.57
DIRECTION: 401 S TO L SR 1006 CROSS N C 42 HWY SUB WILL BE
ON L

IMPROVEMENT PERMIT

TANK SIZE: 1000 gal. PUMP Tank: _____ gal. SQ FT: 900 STONE DEPTH: 12 in. MAX DEPTH LINE: 20 in.
WASTEWATER: INDIVIDUAL SEWAGE: DOMESTIC TYPE SYSTEM: II G PUMP: N P/M: N
DAILY FLOW: 00360 gal/day WATER: COMMUNITY

COMMENTS:

IP ISSUED? Y DATE: 01/08/2001 BY: (VJM) *Clemente Manzi* RS PHONE#: 856-7438

AUTHORIZATION FOR WASTEWATER/WATER SYSTEM CONSTRUCTION

VOID SIXTY (60) MONTHS FROM DATE OF ISSUANCE

AUTHORIZATION CONDITIONS:

Contractors shall install system on contours, see attached site plan for wastewater system design and well location. No underground utilities, water lines or sprinkler systems may be located in the original system or repair areas. A septic tank filter with a riser for access is required. The wastewater system shall not be covered or placed into use until inspected by the Wake County Department of Environmental Services and an Operation Permit issued. **OTHER CONDITIONS:**

INSTALL ON CONTOUR, FOLLOW LAYOUT IN FIELD. NO GRADING OR SITE DISTURBANCE IN AREA RESERVED FOR SEWAGE DISPOSAL. HOUSE TO BE CONSTRUCTED AS SHOWN ON SITE PLAN DRIVEWAY TO FOLLOW 10 FEET OFF EASEMENT AS SHOWN ON SITE PLAN CONCRETE WALKWAY NOT TO ENCROACH INTO REPAIR AREA. RECOMMEND UTILITIES TO BE LOCATED UNDER OR NEAR DRIVEWAY/PROPERTY LINE.


TANK SIZE: 1000 gal. PUMP TANK: _____ gal. SQ FT: 900 STONE DEPTH: 12 in. MAX DEPTH LINE: 20 in.
MAINT: N OPER: N L/O: Y TRENCH#: 3 LENGTH: 90 ft. WIDTH: 36 in.
SUBFIELDS: _____ DESIGN HEAD PRESSURE: _____ DESIGN FLOW: _____ gal/min DOSE VOLUME: _____ gal.

CA ISSUED? Y DATE: 01/08/2001 BY: (VJM) *Clemente Manzi* RS PHONE#: 856-7438

*MLP 814
5/5/01*

Pit	Pit
①	②
40"	30"
2CL	3CL
.33	.33

0011189
19641

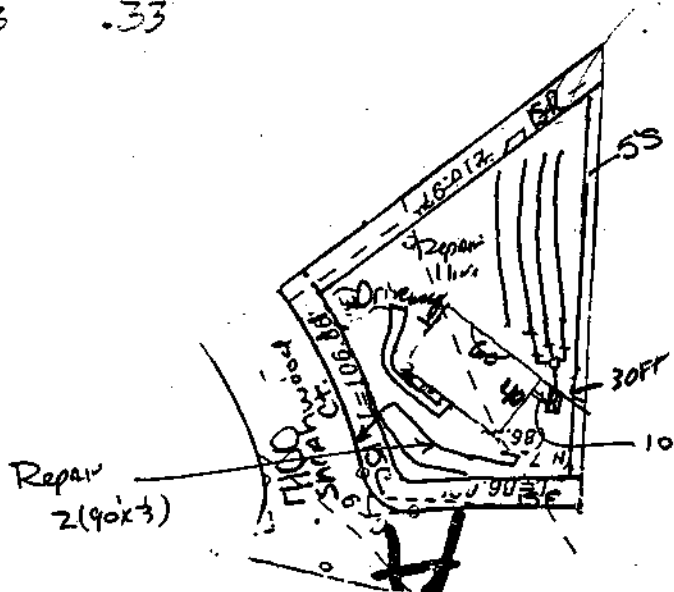

Kendall Hills
Subdivision
Lot 47
1 inch = 100' F
0.578 AC

Initial =
3(90x3) INNOV

Repair = 3(90x3)
Pressure Manifold

Zoning B30 By JLL
 Approve ✓ Date 10-5-00
 Revise _____ Use 101
 Reject _____ MBL _____
 Front 15 Rear 15
 Side 5 Corner _____

Comments: cluster dnd

I certify that the location of planned or existing structure(s) are accurately shown. I understand failure to locate structures in accordance with this plot plan may require the relocation of structure(s) regardless degree of completion. I hereby grant permission to Municipal/County Representatives the right of entry to make evaluations or inspections upon this property.

[Signature]

Signature of Owner or Authorized Agent

Pin: 0016-01-16-7808