

Environmental Services - Water Quality
Onsite Wastewater Scan Data Entry Form

PERMIT #: **B 0 2 0 2 2 7**

PIN #: **0 7 8 6 0 8 6 3 1 2**

OP DATE: **0 7 / 2 3 / 1 9 8 2**

SYSTEM USE:

- ☒ House
☐ Mobile Home
☐ Business
☐ Other

SEWAGE TYPE:

- ☒ Domestic
☐ Industrial

PUMP/SIPHON?:

- ☐ Yes
☒ No

PRESSURE MANIFOLD:

- ☐ Yes
☒ No

SYSTEM TYPE:

- ☐ I
☒ II
☐ III
☐ IV
☐ V
☐ VI
☐ Other

SUB TYPE:

- ☒ A
☐ B
☐ C
☐ D
☐ E
☐ F
☐ G

NBR BEDROOMS:

- ☐ 1
☐ 2
☒ 3
☐ 4
☐ 5
☐ 6
☐ Other

MAINT. SCHEDULE:

- ☐ Yes
☒ No

CERT. OPERATOR

- ☐ Yes
☒ No

GT	ST	PT	SIZE
☐	☐		750
☐	☐	☐	900
☐	☒	☐	1,000
☐	☐	☐	1,200
☐	☐	☐	1,500
☐	☐	☐	1,800
☐	☐	☐	2,100
☐	☐	☐	2,500
☐	☐	☐	3,000
☐	☐	☐	4,000
☐	☐	☐	5,000
☐	☐	☐	8,000
☐	☐	☐	10,000
☐	☐	☐	Other
☒		☒	None/NA GT or PT

DRAINFIELD SIZE(SQ. FT.)

0 1 0 0 0

DRAIN TYPE:

- ☒ Stone
☐ EZ Flow
☐ Infiltrator
☐ Biodiffuser
☐ Cultec
☐ Drip
☐ Hancor
☐ Large Dia. Pipe
☐ Multi-Pipe
☐ Other

MAX DEPTH (IN.):

- ☐ 12 in. or less
☐ 18 in. or less
☐ 24 in. or less
☐ 26 in. or less
☐ 28 in. or less
☐ 30 in. or less
☐ 32 in. or less
☐ 36 in. or less
☒ Other None Given

STONE DEPTH (IN.):

- ☐ 8 in. or less
☒ 12 in. or less
☐ 18 in. or less
☐ 24 in. or less
☐ Other

TRENCHES:

- ☐ Individual
☒ Bed

TRENCH WIDTH (IN.):

- ☐ 12 in. or less
☐ 18 in.
☐ 24 in.
☐ 36 in.
☒ 6 ft. or less
☐ 9 ft. or less
☐ Other

WAKE COUNTY HEALTH DEPARTMENT SEPTIC TANK LAYOUT AND PERMIT

TAX MAP NO. 403 PARCEL NO. 76 PERMIT NO. B 20227

CONTRACTOR Sendero

OWNER Ch Rd, lot on right side DATE Dec 14, 1981


LOCATION Ch Rd, lot on right side S. R. NO. 1649

SUBDIVISION NAME Sendero LOT NO. 4 SECTION OR BLOCK NO. 4

REPAIR ☐ ORIGINAL PERMIT NO.
 GARBAGE DISPOSAL UNIT YES ☐ NO ☐
 HOUSE ☐ MOBILE HOME ☐ BUSINESS ☐
 NO. BEDROOMS 2 LOT AREA 2.86 ac
 SIZE OF TANK 1100 gal.
 NITRIFICATION LINE 6' x 16' x 1000 sq. ft.
 DEPTH OF STONE IN LINES: 12" ☐ 18" ☐

WATER SUPPLY: INDIVIDUAL ☒ PUBLIC ☐ OTHER ☐
1.5 serv. baffle required on new installation
 * PERMIT VOID 36 MONTHS FROM DATE OF ISSUANCE.
 * PERMIT VOID IF NOT IN COMPLIANCE WITH ZONING REGULATIONS
 * PERMIT MAY BE VOIDED IF SITE ALTERATIONS MADE

*well - follow contour
- install shallow*

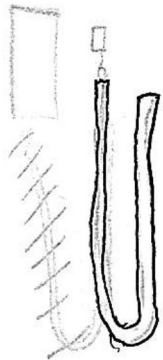

LAYOUT BY H. L. Bergeron APPROVED BY David Farrell
 DATE 1-23-82

