

Environmental Services - Water Quality
Onsite Wastewater Scan Data Entry Form

PERMIT #: D026987

PIN #: 1606244640

OP DATE: 1110712003

SYSTEM USE:

- ☒ House
☐ Mobile Home
☐ Business
☐ Other

SEWAGE TYPE:

- ☒ Domestic
☐ Industrial

PUMP/SIPHON?:

- ☒ Yes
☐ No

PRESSURE MANIFOLD:

- ☐ Yes
☒ No

SYSTEM TYPE:

- ☐ I
☐ II
☒ III
☐ IV
☐ V
☐ VI
☐ Other

SUB TYPE:

- ☐ A
☒ B
☐ C
☐ D
☐ E
☐ F
☐ G

NBR BEDROOMS:

- ☐ 1
☐ 2
☒ 3
☐ 4
☐ 5
☐ 6
☐ Other

MAINT. SCHEDULE:

- ☐ Yes
☒ No

CERT. OPERATOR

- ☐ Yes
☒ No

GT ST PT SIZE

- | | | | |
|-------------------------------------|-------------------------------------|-------------------------------------|------------------|
| ☐ | ☐ | ☐ | 750 |
| ☐ | ☐ | ☐ | 900 |
| ☐ | ☒ | ☒ | 1,000 |
| ☐ | ☐ | ☐ | 1,200 |
| ☐ | ☐ | ☐ | 1,500 |
| ☐ | ☐ | ☐ | 1,800 |
| ☐ | ☐ | ☐ | 2,100 |
| ☐ | ☐ | ☐ | 2,500 |
| ☐ | ☐ | ☐ | 3,000 |
| ☐ | ☐ | ☐ | 4,000 |
| ☐ | ☐ | ☐ | 5,000 |
| ☐ | ☐ | ☐ | 8,000 |
| ☐ | ☐ | ☐ | 10,000 |
| ☐ | ☐ | ☐ | Other |
| ☒ | ☐ | ☐ | None/NA GT or PT |

DRAINFIELD SIZE(SQ. FT.)

00900

DRAIN TYPE:

- ☐ Stone
☒ EZ Flow
☐ Infiltrator
☐ Biodiffuser
☐ Cultec
☐ Drip
☐ Hancor
☐ Large Dia. Pipe
☐ Multi-Pipe
☐ Other

MAX DEPTH (IN.):

- ☐ 12 in. or less
☐ 18 in. or less
☐ 24 in. or less
☐ 26 in. or less
☐ 28 in. or less
☒ 30 in. or less
☐ 32 in. or less
☐ 36 in. or less
☐ Other

STONE DEPTH (IN.):

- ☐ 8 in. or less
☒ 12 in. or less
☐ 18 in. or less
☐ 24 in. or less
☐ Other

TRENCHES:

- ☒ Individual
☐ Bed

TRENCH WIDTH (IN.):

- ☐ 12 in. or less
☐ 18 in.
☐ 24 in.
☒ 36 in.
☐ 6 ft. or less
☐ 9 ft. or less
☐ Other

WAKE COUNTY DEPARTMENT OF ENVIRONMENTAL SERVICES WELL AND SEWAGE SITE LOCATION PERMIT
NO PERMIT(S) FOR CONSTRUCTION, LOCATION OR RELOCATION ACTIVITY SHALL BE ISSUED
UNTIL AN AUTHORIZATION FOR WASTEWATER SYSTEM CONSTRUCTION HAS BEEN ISSUED

PERMIT VOID IF NOT IN COMPLIANCE WITH ZONING REGULATIONS AND/ OR IF SITE IS ALTERED OR INTENDED USE CHANGED

PERMIT#: D026987 STATUS: A APP. DATE: 04/22/2003 BLDG. PERMIT#: 0032637
PIN: 1606.01 25 6499 000 TAX MAP: 0859 0000 RECORDED: Y ORIG. PERMIT#:
TOWNSHIP: 15 PANTHER BRANCH JURISDICTION: WC ZONING: R30
APPLICANT: SUPERIOR HOMES
126 PARRISH MEMORIAL RD
SELMA, NC 27576
(919) 868 - 6315
USE: HD USE: 101 ONE-FAMILY HOUSE
EXIST USE:
DISPOSAL: BEDROOMS: 3 BASEMENT: N #EMPLOYEES: 0
SITE: ADDRESS: 2725 LAUTENBERG LA
SUBDIVISION: OGBURN FARMS LOT: 28 ACRES: 0.61
DIRECTION: 50S R HWY 42 6MI AT BACK OF LANDINGHAM SUB

Well System: WATER: COMMUNITY TYPE: EXISTING

WELL LOG INFORMATION: DEPTH: _____ CASING DEPTH: _____ YIELD: _____ STATIC LEVEL: _____
WELL CONTRACTOR: _____ REG.# _____ PUMP CONTRACTOR: _____ REG.# _____
Construction Compliance GROUT APPROVED ☐ DATE _____ EHS _____
WELLHEAD APPROVED ☐ DATE _____ EHS _____
SYSTEM FINALIZED ☐ DATE _____ EHS _____

COMMENTS: _____

DESIGN FLOW: _____ gal./min. ACTUAL FLOW: _____ INNOVATIVE LETTER: R
INSTALLED BY: Tommy Camal INSTALLATION APPROVED BY: Kathryn Robinson
PROPRIETARY SYSTEM: _____ FILTER NO: _____
COMMENTS: _____

OPERATIONS PERMIT ISSUED? Y OP DATE: 11/7/03 BY: jeelmaria

This permit is based in part on information provided by the homeowner or his/her representative in the application submitted for this permit. The Environmental Health Specialist is not responsible for false or misleading information contained in the application. The Environmental Health Specialist is also not responsible for concealed conditions on the property or for statements in this report that may have resulted from false or misleading statements provided to him in the application. Neither Wake County nor the Environmental Health Specialist warrants that the septic tank system will continue to function satisfactorily in the future or that the water supply will remain potable.

As Built Information:

Date: _____ Benchmark: _____ Rod reading: _____ Distance to Structure: _____
ST: _____ gals ID#: _____ D.O.M.: _____ Elev.: _____ Distance to Well: _____
PT: _____ gals ID#: _____ D.O.M.: _____ Elev.: _____
D-box/FD/PM elev.: _____ Supply Line: _____ ft. Pump/Control Panel: _____
Line 1: _____ Date: _____
Line 2: _____ Date: _____
Line 3: _____ Date: _____
Line 4: _____ Date: _____
Line 5: _____ Date: _____
Distance to P/L: _____ Notes: _____

WAKE COUNTY DEPARTMENT OF ENVIRONMENTAL SERVICES WELL AND SEWAGE SITE LOCATION PERMIT
NO PERMIT(S) FOR CONSTRUCTION, LOCATION OR RELOCATION ACTIVITY SHALL BE ISSUED

UNTIL AN AUTHORIZATION FOR WASTEWATER SYSTEM CONSTRUCTION HAS BEEN ISSUED

PERMIT VOID IF NOT IN COMPLIANCE WITH ZONING REGULATIONS AND/ OR IF SITE IS ALTERED OR INTENDED USE CHANGED

PERMIT#: D026987 STATUS: A APP. DATE: 04/22/2003 BLDG. PERMIT#: 0032637
PIN: ~~1606-01-256499-000~~ TAX MAP: 0859 0000 RECORDED: Y ORIG. PERMIT#:
TOWNSHIP: 15 PANTHER BRANCH JURISDICTION: WC ZONING: R30
APPLICANT: SUPERIOR HOMES
126 PARRISH MEMORIAL RD
SELMA, NC 27578
(919) 868-6315
USE: HD USE: 101 ONE-FAMILY HOUSE
EXIST USE:
DISPOSAL: BEDROOMS: 3 BASEMENT: N #EMPLOYEES: 0 FOUND DRAIN:
SITE: ADDRESS: 2725 LAUTENBERG LA
SUBDIVISION: OGBURN FARMS LOT: 28 ACRES: 0.61
DIRECTION: 50S R HWY 42 5MI AT BACK OF LANDINGHAM SUB

1606 24 4640

IMPROVEMENT PERMIT

TANK SIZE: 1000 gal. PUMP Tank: 1000 gal. SQ FT: 900 INNOVATIVE MAX DEPTH LINE: 30 in.
WASTEWATER: INDIVIDUAL SEWAGE: DOMESTIC TYPE SYSTEM: III G PUMP: Y P/M: N
DAILY FLOW: 360 gal/day DESIGN FEE REQ?: PAID?: WATER: COMMUNITY

COMMENTS:

IP ISSUED? Y DATE: 06/30/2003 BY: (SFM) Steve Meyer, RS PHONE#: 856-5706

AUTHORIZATION FOR WASTEWATER/WATER SYSTEM CONSTRUCTION

VOID SIXTY (60) MONTHS FROM DATE OF ISSUANCE

AUTHORIZATION CONDITIONS:

Contractors shall install system on contours, see attached site plan for wastewater system design and well location. No underground utilities, water lines or sprinkler systems may be located in the original system or repair areas. A septic tank filter with a riser for access is required. The wastewater system shall not be covered or placed into use until inspected by the Wake County Department of Environmental Services and an Operation Permit issued. **OTHER CONDITIONS:**
INSTALL A PUMP, ALARM, NEMA 4X BOX, ETC. INSTALL AN INNOVATIVE SYSTEM AS PROPOSED BY CONSULTANT, NEAL FLOYD. INSTALL A LARGE D BOX. MAINTAIN ALL SETBACKS OFF OF HOUSE LOCATION. DO NOT EXCEED MAXIMUM TRENCH DEPTH. CALL PRIOR TO INSTALLATION WITH ANY QUESTIONS OR CHANGES.

TANK SIZE: 1000 gal. PUMP TANK: 1000 gal. SQ FT: 900 INNOVATIVE MAX DEPTH LINE: 30 in.
MAINT: N OPER: N L/O: Y TRENCH#: 3 LENGTH: 100 ft. WIDTH: 36 in. DESIGNER:
SUBFIELDS: _ DESIGN HEAD PRESSURE: _ DESIGN FLOW: _ gal/min DOSE VOLUME: _ gal.

CA ISSUED? Y DATE: 06/30/2003 BY: (SFM) Steve Meyer, RS PHONE#: 856-5706

Attn: Steve Meyers.

ROCK N SERVICE
247 N STA. 20.

026987
0032637

pin# 160603244640


GRID
MB 2002-339

VICINITY MAP
NTS

IMPERVIOUS DATA

LOT 26,559 S.F.
HOUSE 2400 SF = 9.19%
DRIVE 1523 SF = 5.7%
TOTAL 3923 SF = 14.8%

Zoning R30 By SEH
Approve ✓ Date 6/25/03
Revise ✓ Use 101
Reject ✓ MBL 30
Front 15 Rear 30
Side 15 Corner 30
Comment ✓

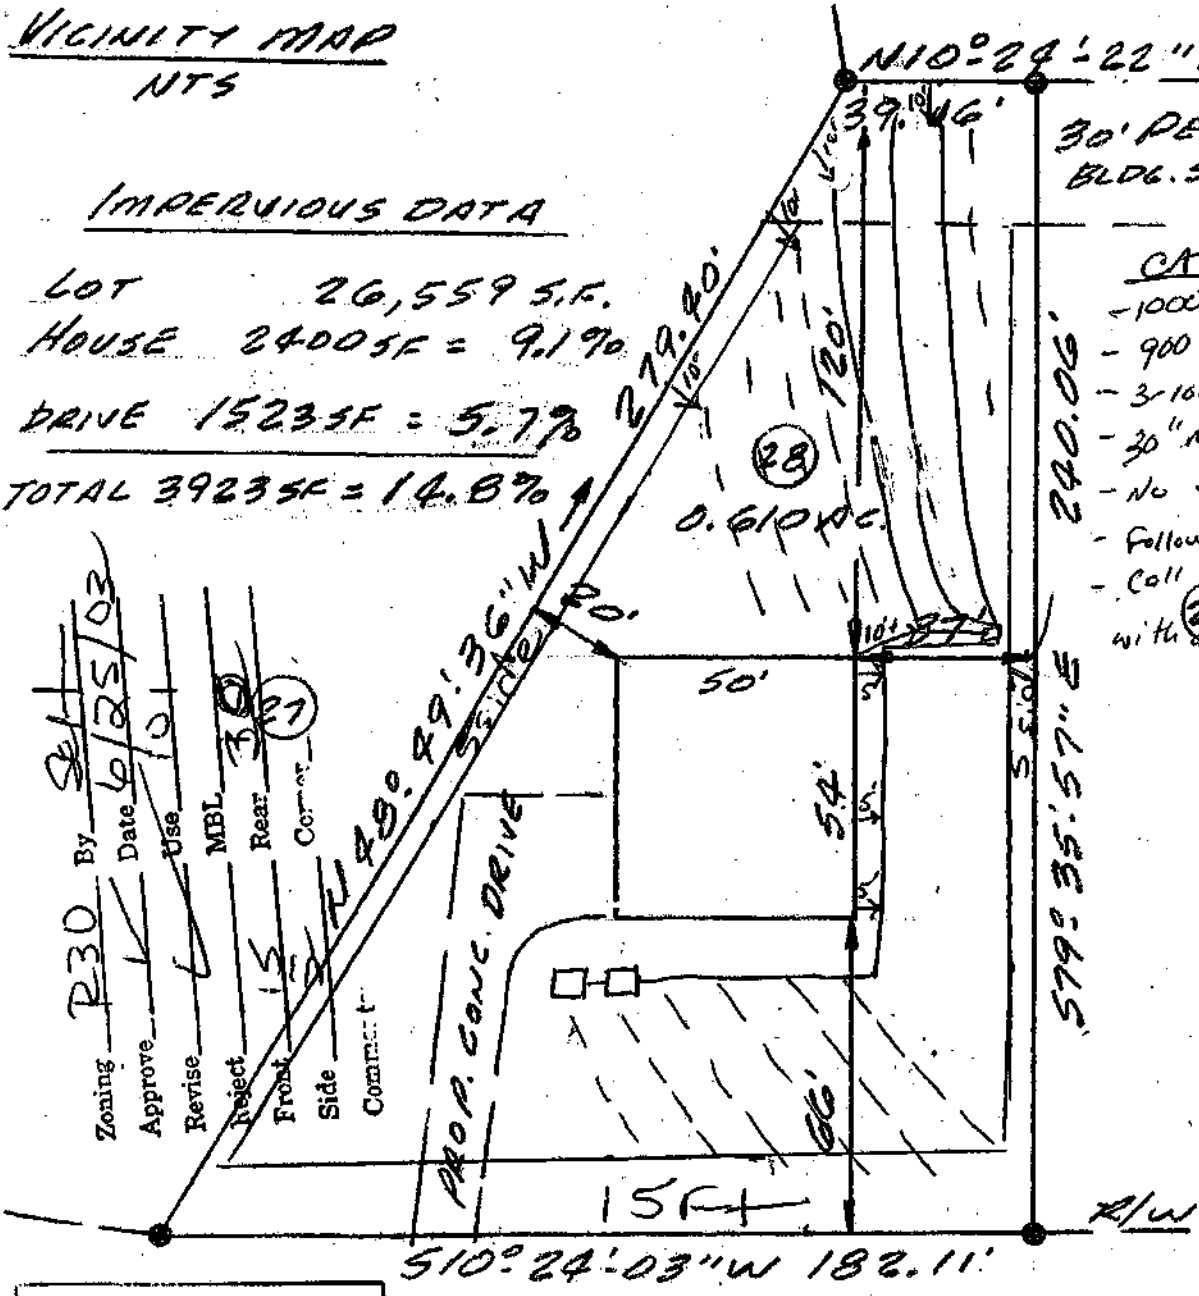

30' PERIMETER
BLDG. SETBACK

- CA
- 1000 gal ST / 1000 gal PT
 - 900 SG. CT / mov.
 - 3-100'x3' / mov.
 - 30" max T.D.
 - No Steppdowns
 - Follow Layout
 - Call prior to construction with any questions

ALL INTERIOR LOT LINES SHALL HAVE A 20' EASEMENT,
10' EACH SIDE OF ALL LOT LINES.
A 10' DRAINAGE AND UTILITY EASEMENT SHALL LIE
INSIDE OF ALL EXTERIOR BOUNDARY LINES.
A 15' WIDE GRADING, SLOPE, DRAINAGE, AND UTILITY
EASEMENT IS RESERVED ON THE SIDE OF LAND AND
ADJACENT TO ALL STREET RIGHTS-OF-WAY.

LAUTENBERG LANE
50' R/W

PROPOSED PLOT PLAN

LOT 28
OGBURN FARMS
MAP BOOK 2002 PAGES 337-339
WAKE COUNTY REGISTRY

PROPERTY OF

LINWOOD HINES

PANTHER BRANCH TOWNSHIP
WAKE COUNTY, N.C.

SCALE
1" = 40'
DATE
6-23-03

2725 LAUTENBERG LANE, RALEIGH

I certify that the location of planned or existing structure(s) are accurately shown. I understand failure to locate structures in accordance with this plot plan may require the relocation of structure(s) regardless degree of completion. I hereby grant permission to Municipal/County Representatives the right of entry to make evaluations or inspections upon this property.

Signature of Owner or Authorized Agent