

WAKE COUNTY DEPARTMENT OF ENVIRONMENTAL SERVICES WASTEWATER PERMIT

NO PERMIT(S) FOR CONSTRUCTION, LOCATION OR RELOCATION ACTIVITY SHALL BE ISSUED UNTIL AN AUTHORIZATION FOR WASTEWATER SYSTEM CONSTRUCTION AUTHORIZATION HAS BEEN ISSUED

PERMIT VOID IF NOT IN COMPLIANCE WITH ZONING REGULATIONS AND/OR IF SITE IS ALTERED OR INTENDED USE CHANGED

OPERATIONS PERMIT

PERMIT # WRP-009028-2018

APPLICATION DATE: 11/06/2018

BLDG. PERMIT#: RBPR-010639-2018

PIN: 0760970098

RECORDED: Yes

TOWNSHIP: 18 - Swift Creek

JURISDICTION: Wake County

ZONING: R-40W

APPLICANT: Red Door Homes
Lee Johnson

BUSINESS PHONE: (919) 424-7770

HOME PHONE:

MOBILE PHONE: (919) 999-7554

HD USE: 101A CONVENTIONAL ONE-FAMILY HOUSE

EXISTING USE: 112 MANUFACTURED HOME

SITE ADDRESS: 4609 TEN TEN RD

SUBDIVISION: TEN-TEN TERRENE SUB

LOT: 4

ACRES: 1.25

DIRECTIONS: Going west on I-40/US-64 (inner loop) take gorman St. exit 295. Take left on Gorman st. Take right on Tryon rd. Go 2.23 miles and go left on Holy Springs Rd. Go 4.06 miles and turn left on Ten Ten Rd. Go 0.34 miles will be on your left.

Systems defined as either type III-b, III-g with a pump, IV, V or VI, in accordance with the North Carolina administrative code 15A NCAC 18a .1961, table V as adopted by reference in the "Regulations Governing Wastewater Treatment Dispersal Systems in Wake County", requires Wake County Environmental Services to conduct periodic inspections of the system type pursuant to 15A NCAC 18a. 1961 (j). Fees for these inspections will be charged as per the approved Fee Schedule. In addition, all systems are to be operated and maintained as specified in 15A NCAC 18A .1961. This permit is based in part on information provided by the homeowner and/or his/her representative in the application submitted for this permit. The Environmental Health Specialist is not responsible for false or misleading information contained in the application. The environmental health specialist is also not responsible for concealed conditions on the property or for statements in this report that may have resulted from false or misleading statements provided to him/her in the application. Neither Wake County nor the Environmental Health Specialist warrants that the septic tank system will continue to function satisfactorily in the future or that the water supply will remain potable.

OPERATION PERMIT VALID FOR: No Expiration

INSTALLED BY:

PROPRIETARY SYSTEM:

PRETREATMENT SYSTEM:

SYSTEM TYPE INSTALLED:

OPERATION PERMIT: STATUS: Issued

ISSUED BY: Adrienne Holloway

ISSUED DATE: 02/12/2019

SEPTIC TANK:

DATE OF MANUFACTURE:

FILTER:

GREASE TRAP:

DATE OF MANUFACTURE:

FILTER:

DOSING PUMP TANK:

DATE OF MANUFACTURE:

FILTER:

CC1: ETM1:

CC2:

ETM2:

RECIRCULATION TANK:

DATE OF MANUFACTURE:

CC1: ETM1:

CC2:

ETM2:

SEPTIC TANK ELEVATION:

GREASE TRAP ELEVATION:

DOSING PUMP TANK ELEVATION:

RECIRCULATION TANK ELEVATION:

DISTRIBUTION DEVICE ELEVATION:

INSTALLED TRENCH DEPTH	INSTALLED AGGREGATE DEPTH	INSTALLED TRENCH LENGTH	INSTALLED TRENCH BOTTOM ELEVATION

ACTUAL PRESSURE HEAD:

ACTUAL FLOW RATE:

ACTUAL DOSE VOLUME:

SPECIFIC OPERATION REQUIREMENTS:

ISSUED BY:


Abbott REHS

DATE: 02/12/2019

NOTE : CONTRACTOR TO VERIFY ALL BUILDING SETBACKS & DIMENSIONS PRIOR TO CONSTRUCTION.

IMPERVIOUS AREA


PROPOSED HOUSE: 2,703 SQ FT
PROPOSED DRIVE: 1,923 SQ FT
TOTAL AREA: 54,675 SQ FT
TOTAL IMPERVIOUS AREA: 4,626 SQ FT
% IMPERVIOUS: 8.46%

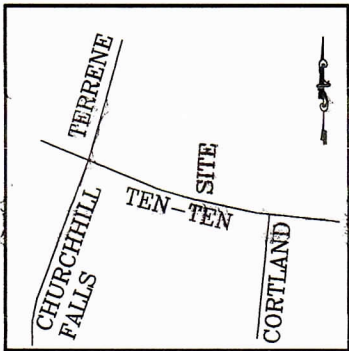

VICINITY MAP
(NO SCALE)

J.R. BROWN FAMILY TRUST
0760-97-0431
DB 5937, PG 477

CURVE TABLE				
CURVE	LENGTH	RADIUS	CHORD	BEARING
C1	207.43	1005.92	207.06	S53°57'14"E

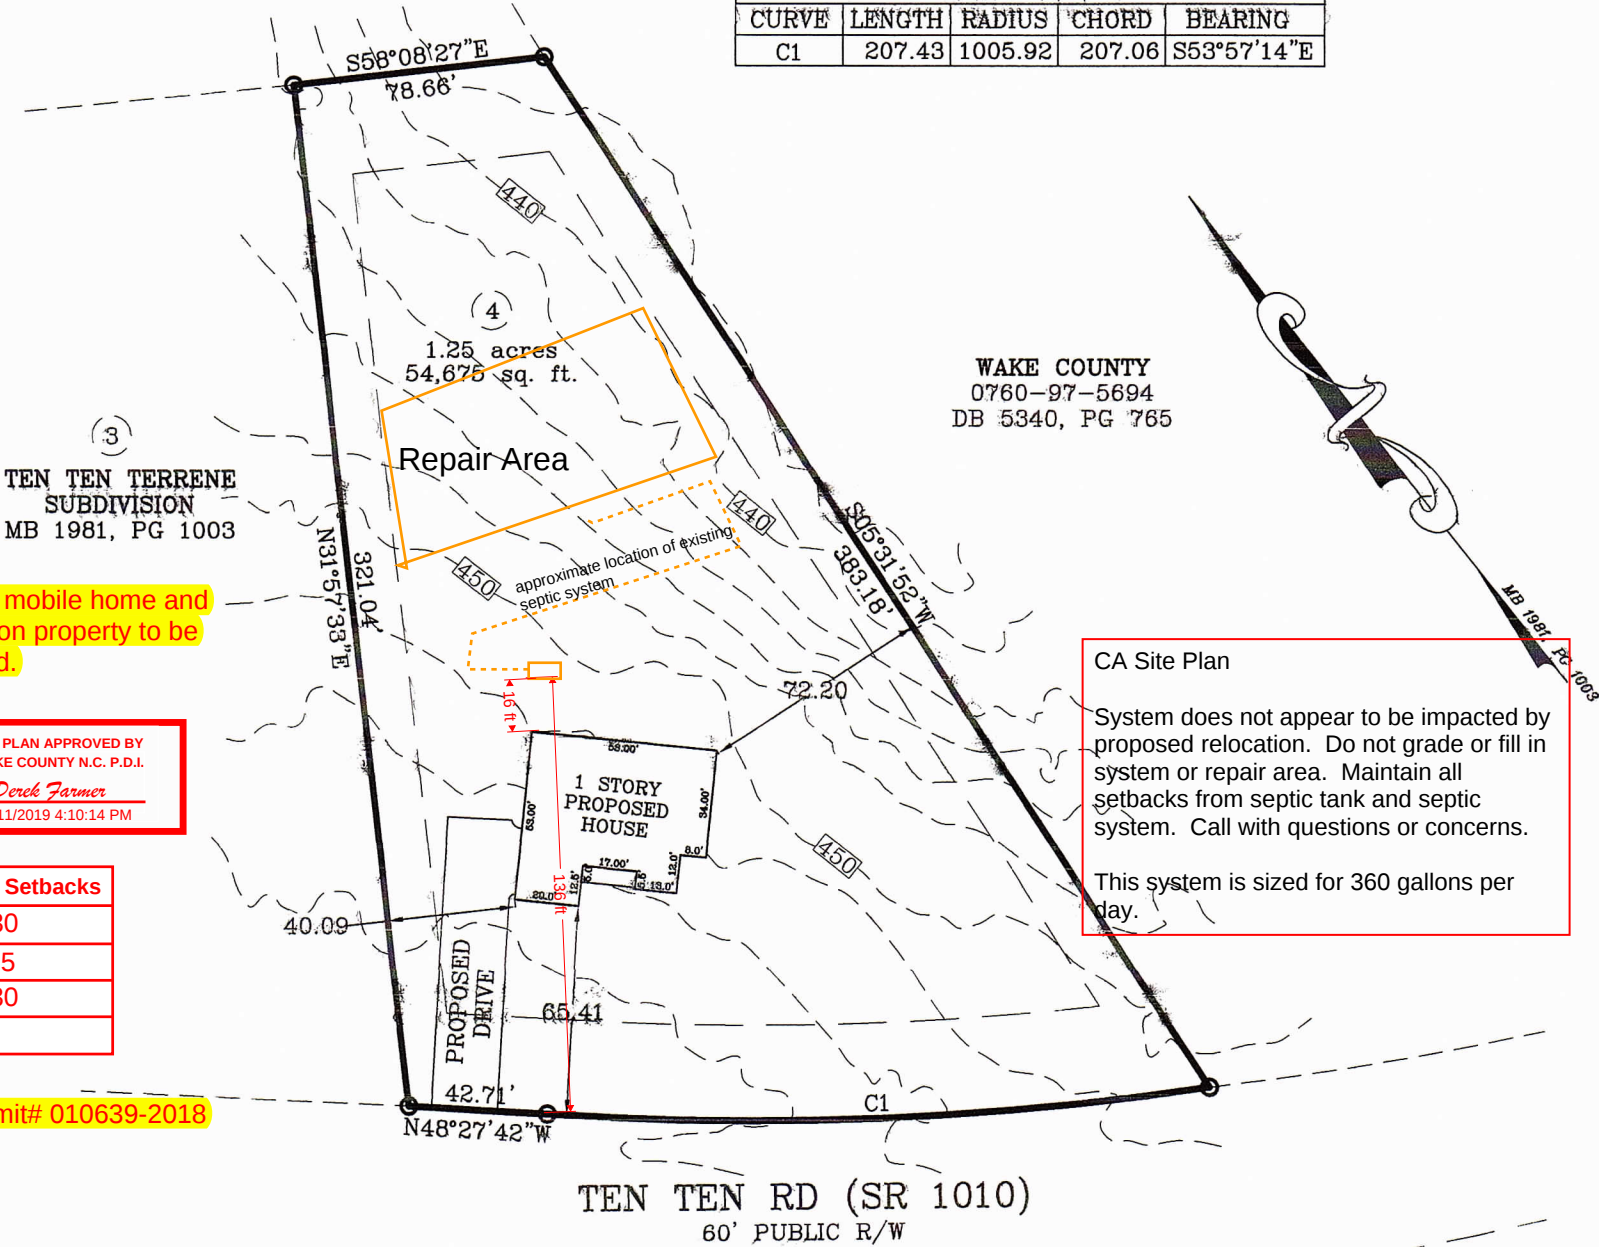

WAKE COUNTY
0760-97-5694
DB 5340, PG 765

TEN TEN TERRENE
SUBDIVISION
MB 1981, PG 1003

existing mobile home and
carport on property to be
removed.



Required Setbacks	
Front	30
Side	15
Rear	30
Corner	

CA Site Plan
System does not appear to be impacted by proposed relocation. Do not grade or fill in system or repair area. Maintain all setbacks from septic tank and septic system. Call with questions or concerns.
This system is sized for 360 gallons per day.

permit# 010639-2018

TEN TEN RD (SR 1010)
60' PUBLIC R/W

PLOT PLAN

RED DOOR 09-18-169

OWNER: JOHN

ADDRESS: 4609 TEN TEN RD

CITY OF: APEX

COUNTY OF: WAKE

ZONING: R-40W


TOWNSHIP OF: SWIFT CREEK

DATE: 3 NOV 2018

SCALE: 1" = 60'

REFERENCE: MB 1981, PG 1003

GRAPHIC SCALE

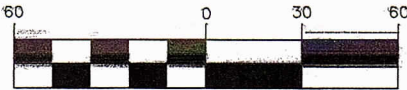

(IN FEET)

1 inch = 60 ft.



I, MICHAEL E. ROGERS, CERTIFY THAT THIS MAP IS FOR THE PURPOSE OF PERMITTING ONLY, IT IS NOT A SURVEY AND NO RELIANCE MAY BE PLACED ON ITS ACCURACY. THE STRUCTURE SHOWN ON THIS PLOT PLAN IS PLACED ACCORDING TO THE INSTRUCTIONS GIVEN BY THE BUILDER. ALL DIMENSIONS AND SETBACKS SHOULD BE VERIFIED FOR COMPLIANCE WITH ZONING AND COVENANTS.

MICHAEL E. ROGERS
PLS, L-4908; 1SG, USA (RET)
ROGERS SURVEYING
529 HARRIS AVE
RAEFORD, NC 28376
Phone: (910) 479-1744
mrogerssurvey.com

THIS MAP CAN NOT BE USED FOR RECORDATION OR ATTACHED TO A DEED TO BE RECORDED. THIS MAP IS NOT DRAWN IN ACCORDANCE WITH GS 47-30.

THE BOUNDARY AND LOT INFORMATION SHOWN ON THIS MAP IS TAKEN FROM THAT DOCUMENT DESCRIBED IN THE "REFERENCE" LINE SHOWN HEREON. THIS INFORMATION SHOULD BE CONFIRMED AS THE MOST CURRENT FOR THIS PROPERTY BEFORE ISSUANCE OF PERMITS OR COMMENCEMENT OF CONSTRUCTION. NO TITLE SEARCH WAS PERFORMED ON THIS PROPERTY BY THIS SURVEYOR.