

Environmental Services - Water Quality
Onsite Wastewater Scan Data Entry Form

PERMIT #: 0009956

PIN #: 1607381971

OP DATE: 0711111990

SYSTEM USE:

- ☒ House
☐ Mobile Home
☐ Business
☐ Other

SEWAGE TYPE:

- ☒ Domestic
☐ Industrial

PUMP/SIPHON?:

- ☐ Yes
☒ No

PRESSURE MANIFOLD:

- ☐ Yes
☒ No

SYSTEM TYPE:

- ☐ I
☒ II
☐ III
☐ IV
☐ V
☐ VI
☐ Other

SUB TYPE:

- ☒ A
☐ B
☐ C
☐ D
☐ E
☐ F
☐ G

NBR BEDROOMS:

- ☐ 1
☐ 2
☒ 3
☐ 4
☐ 5
☐ 6
☐ Other

MAINT. SCHEDULE:

- ☐ Yes
☒ No

CERT. OPERATOR

- ☐ Yes
☒ No

GT ST PT

- ☐ ☐ ☐
☐ ☐ ☐
☐ ☒ ☐
☐ ☐ ☐
☐ ☐ ☐
☒ ☐ ☒

SIZE

- 750
900
1,000
1,200
1,500
1,800
2,100
2,500
3,000
4,000
5,000
8,000
10,000
Other
None/NA GT or PT

DRAINFIELD SIZE(SQ. FT.)

01000

DRAIN TYPE:

- ☒ Stone
☐ EZ Flow
☐ Infiltrator
☐ Biodiffuser
☐ Cultec
☐ Drip
☐ Hancor
☐ Large Dia. Pipe
☐ Multi-Pipe
☐ Other

MAX DEPTH (IN.):

- ☐ 12 in. or less
☐ 18 in. or less
☒ 24 in. or less
☐ 26 in. or less
☐ 28 in. or less
☐ 30 in. or less
☐ 32 in. or less
☐ 36 in. or less
☐ Other

STONE DEPTH (IN.):

- ☐ 8 in. or less
☒ 12 in. or less
☐ 18 in. or less
☐ 24 in. or less
☐ Other

TRENCHES:

- ☒ Individual
☐ Bed

TRENCH WIDTH (IN.):

- ☐ 12 in. or less
☐ 18 in.
☐ 24 in.
☒ 36 in.
☐ 6 ft. or less
☐ 9 ft. or less
☐ Other



WAKE COUNTY HEALTH DEPARTMENT WELL AND SEWAGE SITE, LOCATION PERMIT

Tax Map-No. 826 Parcel No. 449 No. C 09956
 Contractor: William Barker Operation Permit [LT]
 Owner: _____ Date: 3-13-90
 Location/Address: (6324 Hampton Ridge Rd) 3/4 mi S of Hampton
Ridge Rd. 1/4 mi left S.R. # 2737
 Subdivision Name: Hampton Ridge Lot No. 83 Section or Block No. III
 Zoning: W42 Township: Parish Branch

* Permit may be voided if intended use changes


Sewage System

Repair [] Original Permit No. _____
 Garbage Disposal Unit Yes [] No [LT]
 House [✓] Mobile Home [] Business []
 No. Bedrooms 3 Lot Area 30,000
 Size of Tank 1000 gal.
 Nitrification Line 1000 Ft 2(3'x167') sq. ft.
 Depth of Stone: 12" [✓] Max. Depth of Trenches: 24 in.
 Riser and Baffle Required [✓] Pump Required []

Improvement Permit

*Permit Void 36 months from date of issuance
 *Permit Void if not in compliance with zoning regulations
 *Permit may be voided if site alterations made

Layout By: Jerry D. Chapell R.S.
Jerry D. Chapell R.S.

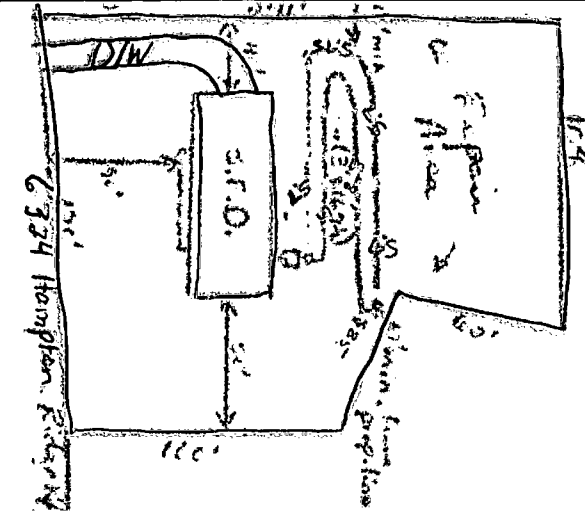

Date July 11, 1990

Horace Tait
 Installed By

Andie C. Pierce
 Approved By
Andie C. Pierce

Well System

Individual [] Semi-Public [] Public [✓]
 New [] Replacement [] Repair []
 Fee Paid Yes [] No []
 Construction Compliance Yes No
 Site Approved [] []
 Well Head Approved [] []
 Grouting Approved [] []

Date Inspected	Sanitarian	
	Yes	No
Final Inspection	[]	[]
Required Slab	[]	[]
Chlorinated	[]	[]
Required Certificate	[]	[]
Variance (Explain)	[]	[]
WCHD I.D. Affixed	[]	[]
Sample Collected	[]	[]

**Well permit void 36 months from issuance date

Bacteriological Results

Initial Sample: _____ Date: _____
 *Re-sample #1 _____ Date: _____
 *Re-sample #2 _____ Date: _____
 Re-chlorination as required Yes [] No []
 Comments: _____

*\$10.00 fee for all re-samples

All checks payable to: **Wake County Health Department**

Well Installed By: _____

Date System Finalized _____ Sanitarian

This report is based in part on information provided by the homeowner or his/her representative in the application submitted for this permit. The sanitarian is not responsible for false or misleading information contained in the application. The sanitarian is also not responsible for concealed conditions on the property or for statements in this report that may have resulted from false or misleading statements provided to him in the application. Neither Wake County nor the sanitarian warrants that the septic tank system will continue to function satisfactorily in the future or that the water supply will remain potable.