

Environmental Services - Water Quality
Onsite Wastewater Scan Data Entry Form

PERMIT #: C021512

PIN #: 0697798196

OP DATE: 0312411995

SYSTEM USE:

- ☒ House
☐ Mobile Home
☐ Business
☐ Other

SEWAGE TYPE:

- ☒ Domestic
☐ Industrial

PUMP/SIPHON?:

- ☐ Yes
☒ No

PRESSURE MANIFOLD:

- ☐ Yes
☒ No

SYSTEM TYPE:

- ☐ I
☒ II
☐ III
☐ IV
☐ V
☐ VI
☐ Other

SUB TYPE:

- ☒ A
☐ B
☐ C
☐ D
☐ E
☐ F
☐ G

NBR BEDROOMS:

- ☐ 1
☐ 2
☒ 3
☐ 4
☐ 5
☐ 6
☐ Other

MAINT. SCHEDULE:

- ☐ Yes
☒ No

CERT. OPERATOR

- ☐ Yes
☒ No

GT ST PT SIZE

- | | | | |
|-------------------------------------|-------------------------------------|-------------------------------------|------------------|
| ☐ | ☐ | ☐ | 750 |
| ☐ | ☐ | ☐ | 900 |
| ☐ | ☒ | ☐ | 1,000 |
| ☐ | ☐ | ☐ | 1,200 |
| ☐ | ☐ | ☐ | 1,500 |
| ☐ | ☐ | ☐ | 1,800 |
| ☐ | ☐ | ☐ | 2,100 |
| ☐ | ☐ | ☐ | 2,500 |
| ☐ | ☐ | ☐ | 3,000 |
| ☐ | ☐ | ☐ | 4,000 |
| ☐ | ☐ | ☐ | 5,000 |
| ☐ | ☐ | ☐ | 8,000 |
| ☐ | ☐ | ☐ | 10,000 |
| ☐ | ☐ | ☐ | Other |
| ☒ | | ☒ | None/NA GT or PT |

DRAINFIELD SIZE(SQ. FT.)

01000

DRAIN TYPE:

- ☒ Stone
☐ EZ Flow
☐ Infiltrator
☐ Biodiffuser
☐ Cultec
☐ Drip
☐ Hancor
☐ Large Dia. Pipe
☐ Multi-Pipe
☐ Other

MAX DEPTH (IN.):

- ☐ 12 in. or less
☐ 18 in. or less
☐ 24 in. or less
☐ 26 in. or less
☒ 28 in. or less
☐ 30 in. or less
☐ 32 in. or less
☐ 36 in. or less
☐ Other

STONE DEPTH (IN.):

- ☐ 8 in. or less
☒ 12 in. or less
☐ 18 in. or less
☐ 24 in. or less
☐ Other

TRENCHES:

- ☒ Individual
☐ Bed

TRENCH WIDTH (IN.):

- ☐ 12 in. or less
☐ 18 in.
☐ 24 in.
☒ 36 in.
☐ 6 ft. or less
☐ 9 ft. or less
☐ Other

B.W 11/18/04

WAKE COUNTY HEALTH DEPARTMENT WELL AND SEWAGE SITE, LOCATION PERMIT

ALL PERMITS VOID 60 MONTHS FROM DATE OF ISSUANCE

Pin # 0697.02798196 Project # 0950638

Tax Map No. _____ Parcel No. _____

Zoning WAKE Township Panther Branch

Owner/Contractor: Woodall Construction

Location/Address: 824 ELBRIDGE DR. on R after Pagan

Improvement Permit

Well Permit No. **C 21512**

Operation Permit []

Date: 9/14/94


S.R. # _____

Subdivision Name: Worthington


Lot No. 14

Section or Block No. _____

Preliminary Layout

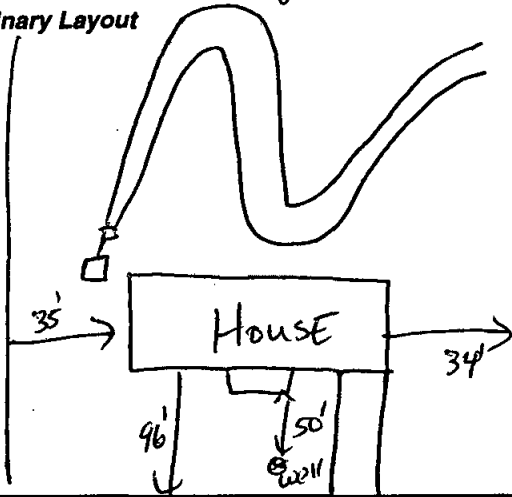

Final Layout

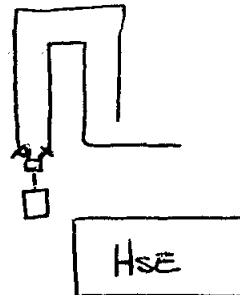

Sewage System Specifications

Repair [] Original Permit No. _____

Garbage Disposal Unit Yes [] No [☒]

House [☒] Mobile Home [] Business []

No. of Bedrooms 3 Lot Area 0.69

Size of Tank 1000 10-18-94 gal.

Comments: _____

Nitrification Line (2) 16.5' x 3' 1000 sq. ft.

Depth of Stone: 12" [☒] Max Depth of Trenches: 28 in.

Riser and Baffle Required [☒] Pump Required []

Permit void if not in compliance with zoning regulations

Permits may be voided if site is altered or intended use changed

Layout by: H. B. Phillips

Date: 12-22-94 Installed By: Jerry Stevens Approved By: Andre C. Davis, R.S.

Well System	
Individual [☒]	Semi-Public []
New [☒]	Replacement []
Fee Paid: Yes [☒]	No []
Construction Compliance	
Site Approved [☒]	No []
Well Head Approved [☒]	[]
Grouting Approved [☒]	[]
Date Inspected: <u>10/25/94</u>	Sanitarian: <u>[Signature]</u>

Bacteriological Results

Initial Sample: absent Date: 3-22-95

* Re-Sample #1 _____ Date: _____

* Re-Sample #2 _____ Date: _____

* Re-chlorination as required [] Yes [] No

* Fees for all resamples

All checks payable to: **Wake County Health Department**

Final Inspection	Yes	No
Required Slab	[☒]	[]
Chlorinated	[☒]	[]
Required Certificate	[]	[]
Variance (Explain)	[]	[]
WCHD I.D. Affixed <u>5178</u>	[☒]	[]
Sample Collected	[☒]	[]
Comments: _____		

Well Installed By: [Signature]

3-24-95 Ralph McDonald, R.S.

Date System Finalized _____ Sanitarian _____

This report is based in part on information provided by the homeowner or his/her representative in the application submitted for this permit. The sanitarian is not responsible for false or misleading information contained in the application. The sanitarian is also not responsible for concealed conditions on the property or for statements in this report that may have resulted from false or misleading statements provided to him in the application. Neither Wake County nor the sanitarian warrants that the septic tank system will continue to function satisfactorily in the future or that the water supply will remain potable.