

Environmental Services - Water Quality
Onsite Wastewater Scan Data Entry Form

PERMIT #: 0029595

PIN #: 1627186077

OP DATE: 07/01/2004

SYSTEM USE:

- ☒ House
☐ Mobile Home
☐ Business
☐ Other

SEWAGE TYPE:

- ☒ Domestic
☐ Industrial

PUMP/SIPHON?:

- ☐ Yes
☒ No

PRESSURE MANIFOLD:

- ☐ Yes
☒ No

SYSTEM TYPE:

- ☐ I
☐ II
☒ III
☐ IV
☐ V
☐ VI
☐ Other

SUB TYPE:

- ☐ A
☐ B
☐ C
☐ D
☐ E
☐ F
☒ G

NBR BEDROOMS:

- ☐ 1
☐ 2
☒ 3
☐ 4
☐ 5
☐ 6
☐ Other

MAINT. SCHEDULE:

- ☐ Yes
☒ No

CERT. OPERATOR

- ☐ Yes
☒ No

GT ST PT

- ☐ ☐ ☐
☐ ☐ ☐
☐ ☒ ☐
☐ ☐ ☐
☐ ☐ ☐
☒ ☐ ☒

SIZE

- 750
900
1,000
1,200
1,500
1,800
2,100
2,500
3,000
4,000
5,000
8,000
10,000
Other

DRAINFIELD SIZE(SQ. FT.)

00900

include permit
W-10802

DRAIN TYPE:

- ☐ Stone
☒ EZ Flow
☐ Infiltrator
☐ Biodiffuser
☐ Cultec
☐ Drip
☐ Hancor
☐ Large Dia. Pipe
☐ Multi-Pipe
☐ Other

MAX DEPTH (IN.):

- ☐ 12 in. or less
☐ 18 in. or less
☒ 24 in. or less
☐ 26 in. or less
☐ 28 in. or less
☐ 30 in. or less
☐ 32 in. or less
☐ 36 in. or less
☐ Other

STONE DEPTH (IN.):

- ☐ 8 in. or less
☒ 12 in. or less
☐ 18 in. or less
☐ 24 in. or less
☐ Other

TRENCHES:

- ☒ Individual
☐ Bed

TRENCH WIDTH (IN.):

- ☐ 12 in. or less
☐ 18 in.
☐ 24 in.
☒ 36 in.
☐ 6 ft. or less
☐ 9 ft. or less
☐ Other

WAKE COUNTY DEPARTMENT OF ENVIRONMENTAL SERVICES WELL AND SEWAGE SITE LOCATION PERMIT
NO PERMIT(S) FOR CONSTRUCTION, LOCATION OR RELOCATION ACTIVITY SHALL BE ISSUED
UNTIL AN AUTHORIZATION FOR WASTEWATER SYSTEM CONSTRUCTION HAS BEEN ISSUED

PERMIT VOID IF NOT IN COMPLIANCE WITH ZONING REGULATIONS AND/ OR IF SITE IS ALTERED OR INTENDED USE CHANGED

PERMIT#: D029595 STATUS: A APP. DATE: 02/23/2004 BLDG. PERMIT#: 0042419
PIN: 1627.01 18 8084 000 TAX MAP: 0828 0000 RECORDED: Y ORIG. PERMIT#:
TOWNSHIP: 15 PANTHER BRANCH JURISDICTION: WC ZONING: R30
APPLICANT: ASHLEY TURNER BUILDERS
PO BOX 160
CLAYTON, NC 27520
(919) 773 - 8566
USE: HD USE: 101 ONE-FAMILY HOUSE
EXIST USE:
DISPOSAL: BEDROOMS: 3 BASEMENT: N #EMPLOYEES: 0
SITE: ADDRESS: 117 BELVE DR
SUBDIVISION: CLEVELAND OAKS LOT: 19 ACRES: 0.47
DIRECTION: 40E TAKE EXIT 312 TRN R GO 2 STOP LIGHTS TRN R
CLEVELAND RD GO 3/4MI SUB ON L

Well System: WATER: COMMUNITY - TYPE:

WELL LOG INFORMATION: DEPTH: _____ CASING DEPTH: _____ YIELD: _____ STATIC LEVEL: _____
WELLI CONTRACTOR: _____ REG.# _____ PUMP CONTRACTOR: _____ REG.# _____
Construction Compliance GROUT APPROVED ☐ DATE _____ EHS _____
WELLHEAD APPROVED ☐ DATE _____ EHS _____
SYSTEM FINALIZED ☐ DATE _____ EHS _____

COMMENTS:

DESIGN FLOW: _____ gal./min. ACTUAL FLOW: _____ INNOVATIVE LETTER: R

INSTALLED BY: Tony Carroll INSTALLATION APPROVED BY: [Signature]
PROPRIETARY SYSTEM: _____ FILTER NO: _____
COMMENTS:

OPERATIONS PERMIT ISSUED? ☒ OP DATE: 7/1/09 BY: [Signature]

This permit is based in part on information provided by the homeowner or his/her representative in the application submitted for this permit. The Environmental Health Specialist is not responsible for false or misleading information contained in the application. The Environmental Health Specialist is also not responsible for concealed conditions on the property or for statements in this report that may have resulted from false or misleading statements provided to him in the application. Neither Wake County nor the Environmental Health Specialist warrants that the septic tank system will continue to function satisfactorily in the future or that the water supply will remain potable.

As Built Information:

Date: 7/1/09 Benchmark: ST. RISE Rod reading: 2' 4 1/2" Distance to Structure: _____
ST: 1000 gals ID#: MCP-814 D.O.M.: 4-17-09 Elev.: 3' 1/2" Distance to Well: _____
PT: _____ gals ID#: _____ D.O.M.: _____ Elev.: _____
D-box/FD/PM elev.: 4' 5 1/2" Supply Line: 25' ft. Pump/Control Panel: _____
Line 1: 6' 3" _____ Date: _____
Line 2: 6' 10" _____ Date: _____
Line 3: 7' 3 1/2" _____ Date: _____
Line 4: 7' 10 1/2" _____ Date: _____
Line 5: _____ Date: _____
Distance to P/L: _____ Notes: _____

WAKE COUNTY DEPARTMENT OF ENVIRONMENTAL SERVICES WELL AND SEWAGE SITE LOCATION PERMIT

NO PERMIT(S) FOR CONSTRUCTION, LOCATION OR RELOCATION ACTIVITY SHALL BE ISSUED

UNTIL AN AUTHORIZATION FOR WASTEWATER SYSTEM CONSTRUCTION HAS BEEN ISSUED

PERMIT VOID IF NOT IN COMPLIANCE WITH ZONING REGULATIONS AND/ OR IF SITE IS ALTERED OR INTENDED USE CHANGED

PERMIT#: D029595 STATUS: A APP. DATE: 02/23/2004 BLDG. PERMIT#: 0042419
PIN: 1627.01 18 8084 000 TAX MAP: 0828 0000 RECORDED: Y ORIG. PERMIT#:
TOWNSHIP: 15 PANTHER BRANCH JURISDICTION: WC ZONING: R30
APPLICANT: ASHLEY TURNER BUILDERS
PO BOX 160
CLAYTON, NC 27520
(919) 773 - 8566
USE: HD USE: 101 ONE-FAMILY HOUSE
EXIST USE:
DISPOSAL: BEDROOMS: 3 BASEMENT: N #EMPLOYEES: 0 FOUND DRAIN:
SITE: ADDRESS: 117 BELVE DR
SUBDIVISION: CLEVELAND OAKS LOT: 19 ACRES: 0.47
DIRECTION: 40E TAKE EXIT 312 TRN R GO 2 STOP LIGHTS TRN R
CLEVELAND RD GO 3/4MI SUB ON L

IMPROVEMENT PERMIT

TANK SIZE: 1000 gal. PUMP Tank: ____ gal. SQ FT: 900 INNOVATIVE MAX DEPTH LINE: 24 in.
WASTEWATER: INDIVIDUAL SEWAGE: DOMESTIC TYPE SYSTEM: III G PUMP: N P/M: N
DAILY FLOW: 360 gal/day DESIGN FEE REQ?: PAID?: WATER: COMMUNITY

COMMENTS:

IP ISSUED? Y DATE: 04/27/2004 BY: (JEM) Jill McNally PHONE#: _____

AUTHORIZATION FOR WASTEWATER/WATER SYSTEM CONSTRUCTION

VOID SIXTY (60) MONTHS FROM DATE OF ISSUANCE

AUTHORIZATION CONDITIONS:

Contractors shall install system on contours, see attached site plan for wastewater system design and well location. No underground utilities, water lines or sprinkler systems may be located in the original system or repair areas. A septic tank filter with a riser for access is required. The wastewater system shall not be covered or placed into use until inspected by the Wake County Department of Environmental Services and an Operation Permit issued. **OTHER CONDITIONS:**

TANK SIZE: 1000 gal. PUMP TANK: ____ gal. SQ FT: 900 INNOVATIVE MAX DEPTH LINE: 24 in.
MAINT: N OPER: N L/O: Y TRENCH#: 4 LENGTH: 75 ft. WIDTH: 36 in. DESIGNER: ____
SUBFIELDS: ____ DESIGN HEAD PRESSURE: ____ DESIGN FLOW: ____ gal/min DOSE VOLUME: ____ gal.


CA ISSUED? Y DATE: 04/27/2004 BY: (JEM) Jill McNally PHONE#: _____

4 BR

TOTAL IMPERVIOUS AREA =
20,473.20SF X 30% = 6,141.96SF

TOTAL DISTURBED AREA = 2,144.0SF
HOUSE = 1,477.0SF
DRIVE = 486.0SF
DECK = 120.00SF
WALK = 61.0SF


SETBACK INFO:
FRONT = 15'
CORNER SIDE = 15'
SIDE = 5'
REAR = 15'

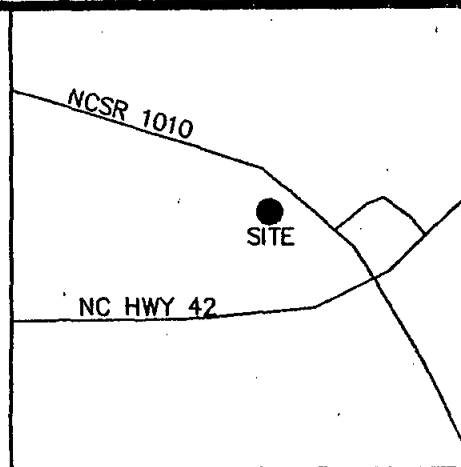

VICINITY MAP

SCALE

PLAT NORTH
BDM 2003, PG. 2227

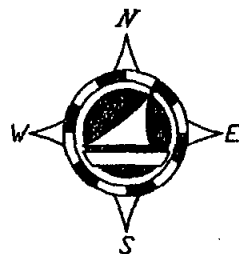

Pin: 1162901188084
I certify that the location of planned or existing structure(s) are accurately shown. I understand this plot plan may require the relocation of structure(s) regardless degree of completion. I hereby grant permission to Municipal/County Representatives the right of entry to make evaluations or inspections upon this property.
[Signature]
Signature of Owner or Authorized Agent

0042419
D29595

(20)

(19)


(18)

W BELVE DRIVE

VIOLA PL.

CURVE 11
R = 800.0
BRG = S27°36'39"E
CHORD = 110.00

REFERENCE:
CLEVELAND OAKS PHASE I
BDM 2003, PG. 2227
LOT 19

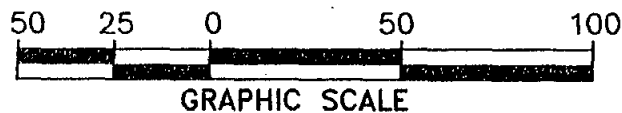

Zoning B30 By SJL
Approve ✓ Date 2.24.04
Revise Use 101
Reject MBL
Front 15 Rear 15
Side 5 Corner


Comments: Cluster Setbacks per plat

NOTES:
THIS PLAT IS NOT FOR RECORDATION
LOT SERVED BY PUBLIC WATER AND IND. SEPTIC SYSTEMS
THIS PLAT WAS PREPARED FROM RECORDED DEEDS AND/OR PLATS.
NO SURVEY WORK WAS DONE AT THIS TIME

PRELIMINARY SITE PLAN

PRELIMINARY
FOR REVIEW ONLY

ASHLEY TURNER ENTERPRISES

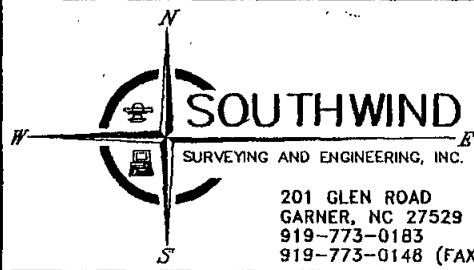

CLEVELAND
TOWNSHIP
WAKE
COUNTY
STATE NC


SCALE 1"=50' DATE 2/5/04 DRAWING NO. A04-2018

4 BR

TOTAL IMPERVIOUS AREA =
20,473.20SF X 30% = 6,141.96SF

TOTAL DISTURBED AREA = 2,144.0SF
HOUSE = 1,477.0SF
DRIVE = 486.0SF
DECK = 120.00SF
WALK = 61.0SF


SETBACK INFO:
FRONT = 15'
CORNER SIDE = 15'
SIDE = 5'
REAR = 15'

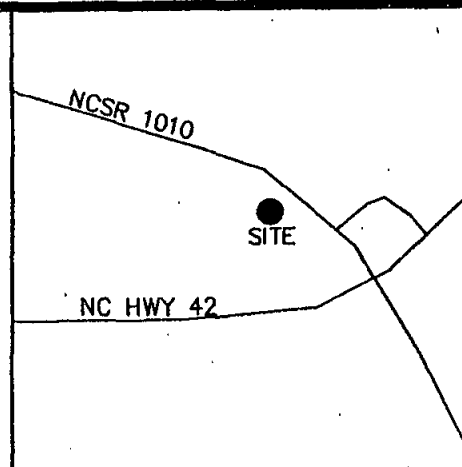

VICINITY MAP

SCALE

PLAT NORTH
BDM 2003, PG. 2227

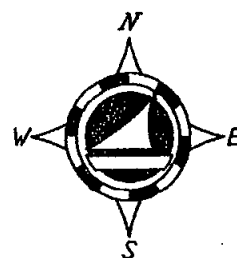

CA

PIN: 162901188084

I certify that the location of planned or existing structure(s) are accurately shown. I understand this plot plan may require the relocation of structure(s) regardless degree of completion. I hereby grant permission to Municipal/County Representatives the right of entry to make evaluations or inspections upon this property.

Ellen Smith
Signature of Owner or Authorized Agent

0042419
D29595

(20)

1000 gallon ST
Max depth 24"
4x75x36"
E2 Flow


11" BELVE DRIVE
VIOLA PL.

CURVE 11
R = 800.0
BRG = S27°36'39"E
CHORD = 110.00

REFERENCE:
CLEVELAND OAKS PHASE I
BDM 2003, PG. 2227
LOT 19



GRAPHIC SCALE

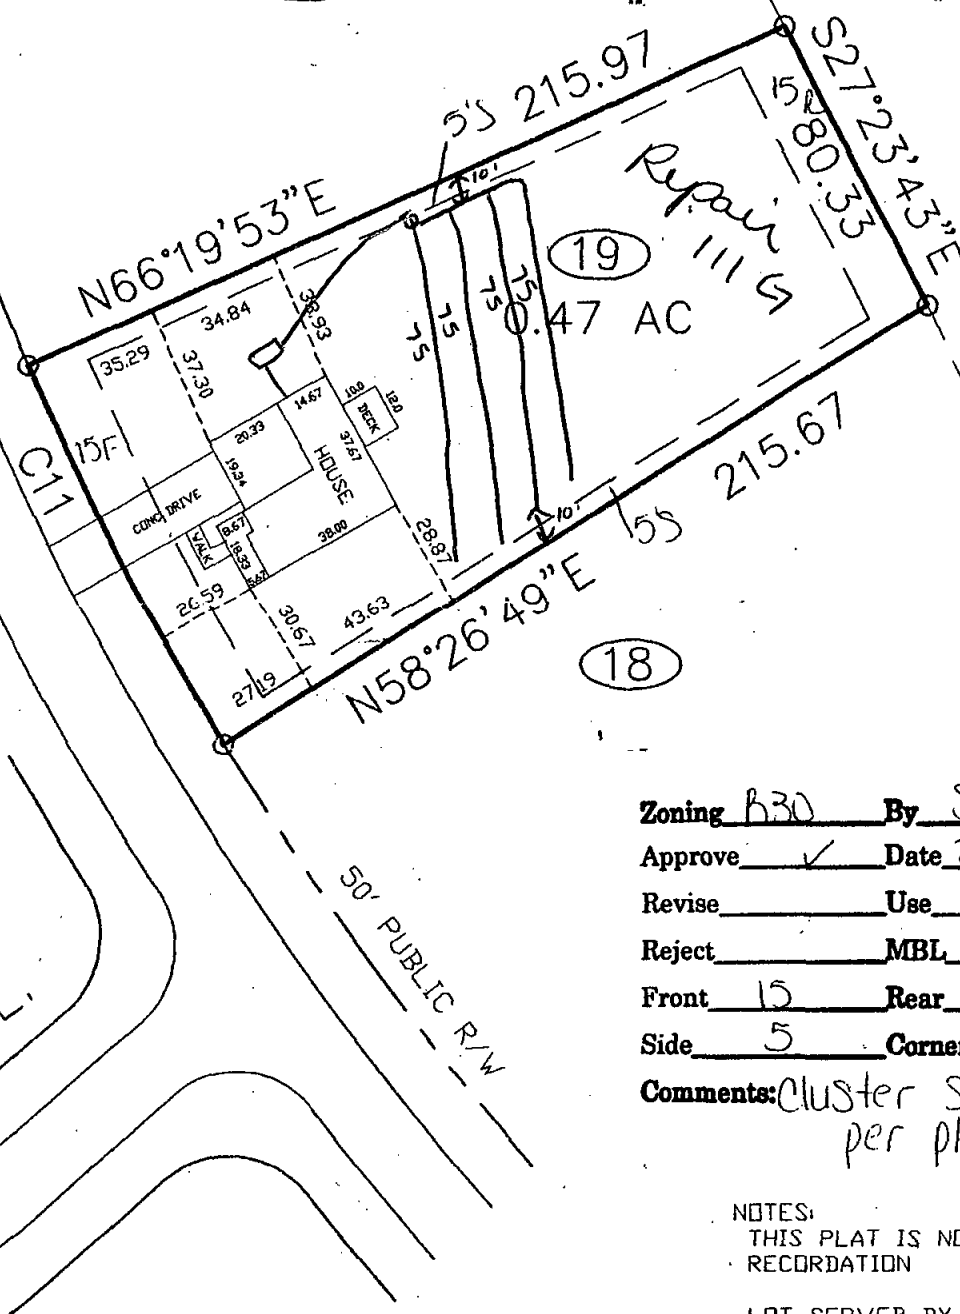

Water and Waste Water Section
 Wake County Department of Environmental Services
 Approved by *E-Plan*
 State Rules.
 Any changes to site plan voids approval. All setbacks apply for septic systems and wells, regarding any pools, decks, additions and/or accessory structures. Applicant is responsible for protecting all portions of the septic system, repair area and wells from damage during construction. Adhere to all local and



Zoning	<i>D30</i>
Approve	<i>1627177899</i>
Revise	<i>2-10-14</i>
Reject	<i>Use 439B</i>
Front	<i>50</i>
Side	<i>10</i>
Corner	<i>10</i>


MAP TITLE

0142044

Comments:

1627186077
 I hereby certify that the information contained herein is true and correct to the best of my knowledge and belief. I am a duly qualified professional engineer and I am not aware of any fraud or other illegal activity in connection with this plan. I am not aware of any fraud or other illegal activity in connection with this plan. I am not aware of any fraud or other illegal activity in connection with this plan.

REVISED
ATTN: ERIC GREEN

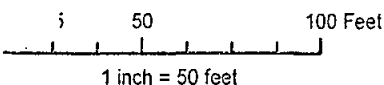

Disclaimer
 iMaps makes every effort to produce and publish the most current and accurate information possible. However, the maps are produced for information purposes, and are NOT surveys. No warranties, expressed or implied, are provided for the data therein, its use, or its interpretation.

20301 M

