


As-Built

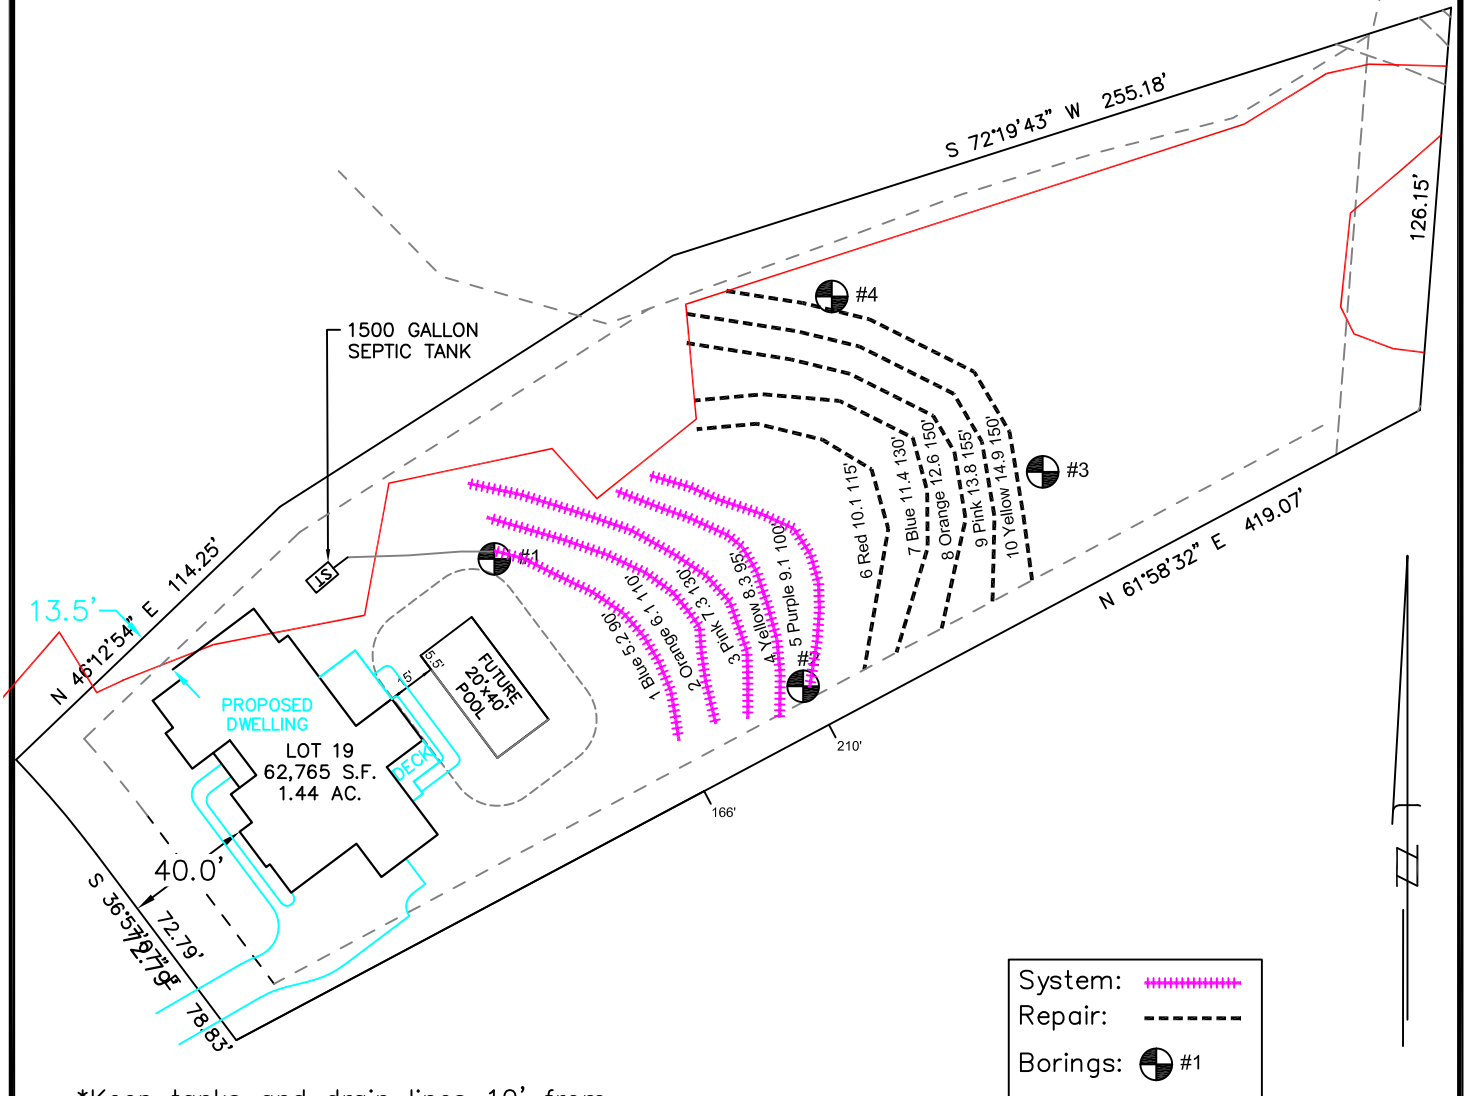

- *Keep tanks and drain lines 10' from property lines.
- *Not a survey.
- *Not a guarantee of a septic permit.
- *Keep supply lines >5' from property lines.
- *Some lines are flagged longer in the field than lengths indicate.
- *No grading septic area.

GRAPHIC SCALE

1" = 60'



System: Gravity to Serial Dist.
Lines: 1-5, (525')
Accepted Status System
0.3 Soil LTAR

Repair: Gravity to Serial Dist.
Lines: 6-10, (700')
Accepted Status System
0.3 Soil LTAR



Central Carolina Soil Consulting, PLLC
1900 South Main Street, Suite 110
Wake Forest, North Carolina 27587
Phone (919)569-6704 Fax (919)569-6703

5-Bedroom Septic Layout
Lot 19, Shinleaf Estates Subdivision
Wake County, North Carolina

Job# : 4993
Drawn By : MB
Date : 08/13/2024
Revision: 12/17/2025