

Environmental Services - Water Quality
Onsite Wastewater Scan Data Entry Form

PERMIT #: 8029085

PIN #: 0761551566

OP DATE: 0712711984

SYSTEM USE:

- ☒ House
☐ Mobile Home
☐ Business
☐ Other

SEWAGE TYPE:

- ☒ Domestic
☐ Industrial

PUMP/SIPHON?:

- ☐ Yes
☒ No

PRESSURE MANIFOLD:

- ☐ Yes
☒ No

SYSTEM TYPE:

- ☐ I
☒ II
☐ III
☐ IV
☐ V
☐ VI
☐ Other

SUB TYPE:

- ☒ A
☐ B
☐ C
☐ D
☐ E
☐ F
☐ G

NBR BEDROOMS:

- ☐ 1
☐ 2
☐ 3
☒ 4
☐ 5
☐ 6
☐ Other

MAINT. SCHEDULE:

- ☐ Yes
☒ No

CERT. OPERATOR

- ☐ Yes
☒ No

GT ST PT SIZE

- | | | | |
|-------------------------------------|-------------------------------------|-------------------------------------|------------------|
| ☐ | ☐ | ☐ | 750 |
| ☐ | ☐ | ☐ | 900 |
| ☐ | ☐ | ☐ | 1,000 |
| ☐ | ☒ | ☐ | 1,200 |
| ☐ | ☐ | ☐ | 1,500 |
| ☐ | ☐ | ☐ | 1,800 |
| ☐ | ☐ | ☐ | 2,100 |
| ☐ | ☐ | ☐ | 2,500 |
| ☐ | ☐ | ☐ | 3,000 |
| ☐ | ☐ | ☐ | 4,000 |
| ☐ | ☐ | ☐ | 5,000 |
| ☐ | ☐ | ☐ | 8,000 |
| ☐ | ☐ | ☐ | 10,000 |
| ☐ | ☐ | ☐ | Other |
| ☒ | | ☒ | None/NA GT or PT |

DRAINFIELD SIZE(SQ. FT.)

01320

DRAIN TYPE:

- ☒ Stone
☐ EZ Flow
☐ Infiltrator
☐ Biodiffuser
☐ Cultec
☐ Drip
☐ Hancor
☐ Large Dia. Pipe
☐ Multi-Pipe
☐ Other

MAX DEPTH (IN.):

- ☐ 12 in. or less
☐ 18 in. or less
☒ 24 in. or less *rel*
☐ 26 in. or less
☐ 28 in. or less
☐ 30 in. or less
☐ 32 in. or less
☐ 36 in. or less
☐ Other

STONE DEPTH (IN.):

- ☐ 8 in. or less
☒ 12 in. or less
☐ 18 in. or less
☐ 24 in. or less
☐ Other

TRENCHES:

- ☒ Individual
☐ Bed

TRENCH WIDTH (IN.):

- ☐ 12 in. or less
☐ 18 in.
☐ 24 in.
☒ 36 in.
☐ 6 ft. or less
☐ 9 ft. or less
☐ Other

ju

WAKE COUNTY HEALTH DEPARTMENT SEPTIC TANK LAYOUT AND PERMIT

TAX MAP NO. 651 PARCEL NO. 55 PERMIT NO. B 29085

CONTRACTOR Jimmy C. Lamer 467 3232 Swift Creek

OWNER _____ DATE 1-20-84

LOCATION _____

SUBDIVISION NAME Humlock Ridge LOT NO. 3 SECTION OR BLOCK NO. —

S. R. NO. 1379

REPAIR ☐ ORIGINAL PERMIT NO. _____

GARBAGE DISPOSAL UNIT YES ☐ NO ☒ Life

HOUSE ☒ MOBILE HOME ☐ BUSINESS ☐ 4 in family

NO. BEDROOMS 3-4 LOT AREA 2.01 AC

SIZE OF TANK 1200 gal.

NITRIFICATION LINE 1320 2(220' x 3') sq. ft.


DEPTH OF STONE IN LINES: 12" ☒

RISER AND BAFFLE REQUIRED ☐ PUMP REQUIRED ☐

WATER SUPPLY: INDIVIDUAL ☒ PUBLIC ☐ OTHER ☐

- PERMIT VOID 36 MONTHS FROM DATE OF ISSUANCE.
- PERMIT VOID IF NOT IN COMPLIANCE WITH ZONING REGULATIONS
- PERMIT MAY BE VOIDED IF SITE ALTERATIONS MADE

LAYOUT BY Al Kornogay

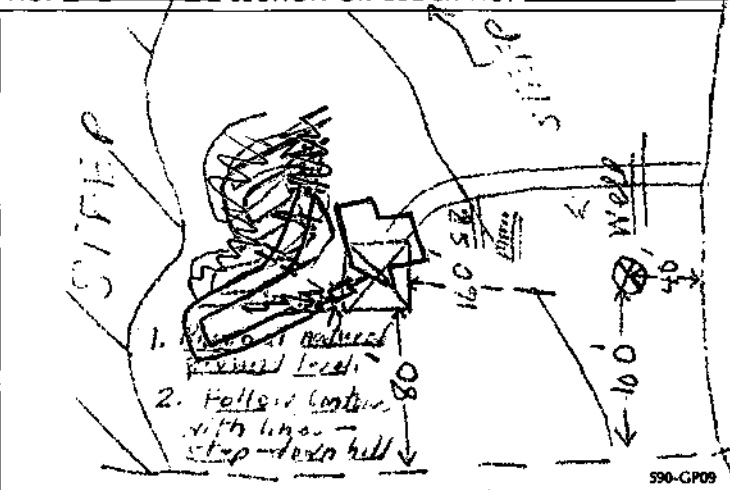

DATE 7-27-84

INSTALLED BY Al Kornogay

APPROVED BY Al Way

